

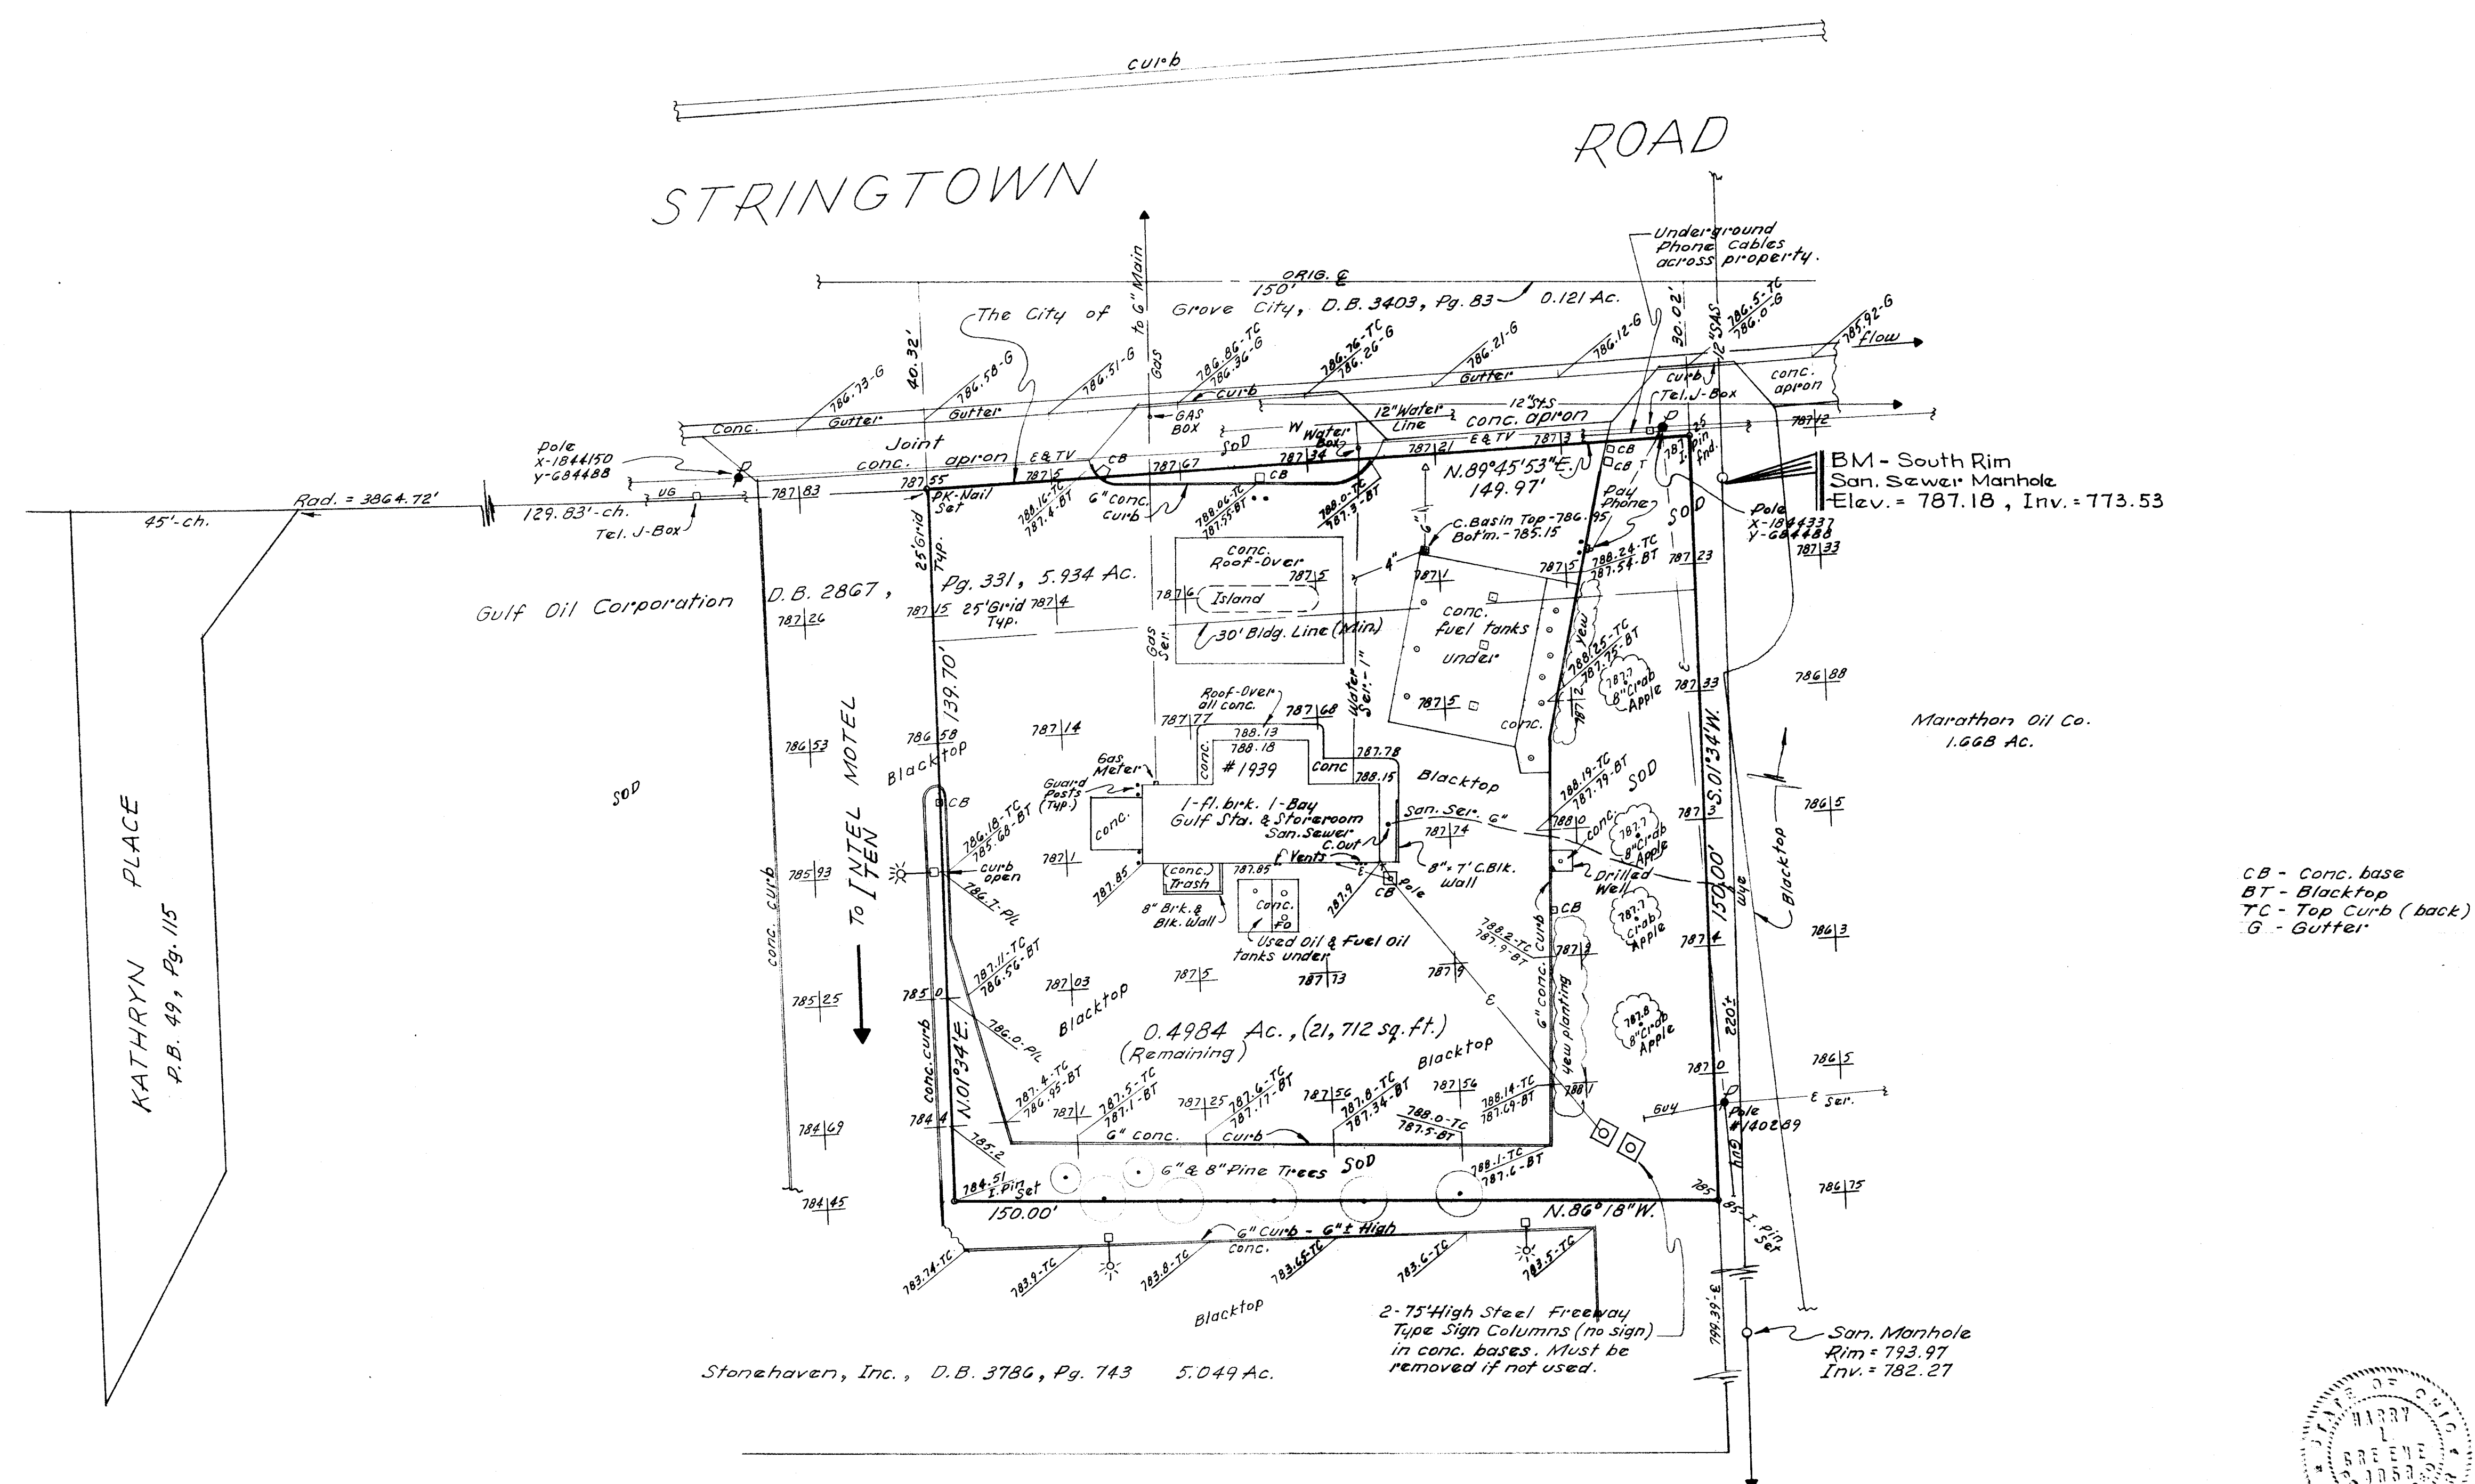


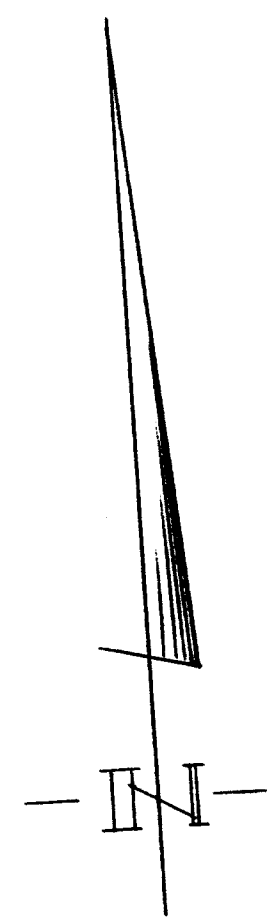

Plat showing survey and topo, 0.4984 Acre Tract, City of Grove City, Ohio, on property of Gulf Oil Corporation, of record in D.B. 2867, Pg. 331, Recorder's Office, Franklin County, Ohio.

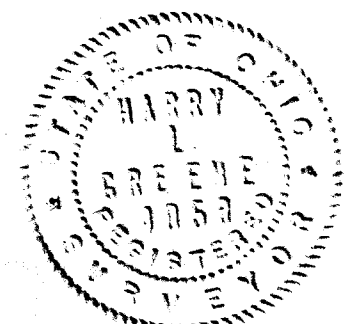

for
G.D. Ritzky's Inc.
Harry L. Greene, Reg. Surveyor - 4058.
1" = 20'
April 20-83
Ph. 486-0714