


SULLIVANT


AVENUE 80' R/W

B.M. - Assume Elev. of 100.00 ft., Top West Bolt, Fire Hyd.

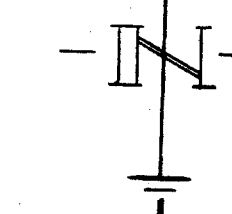

Rim - San. M. H.
Elev. = 94.02
F/L = 77.00

Rim - San. M. H.
Elev. = 98.12
F/L = 78.12

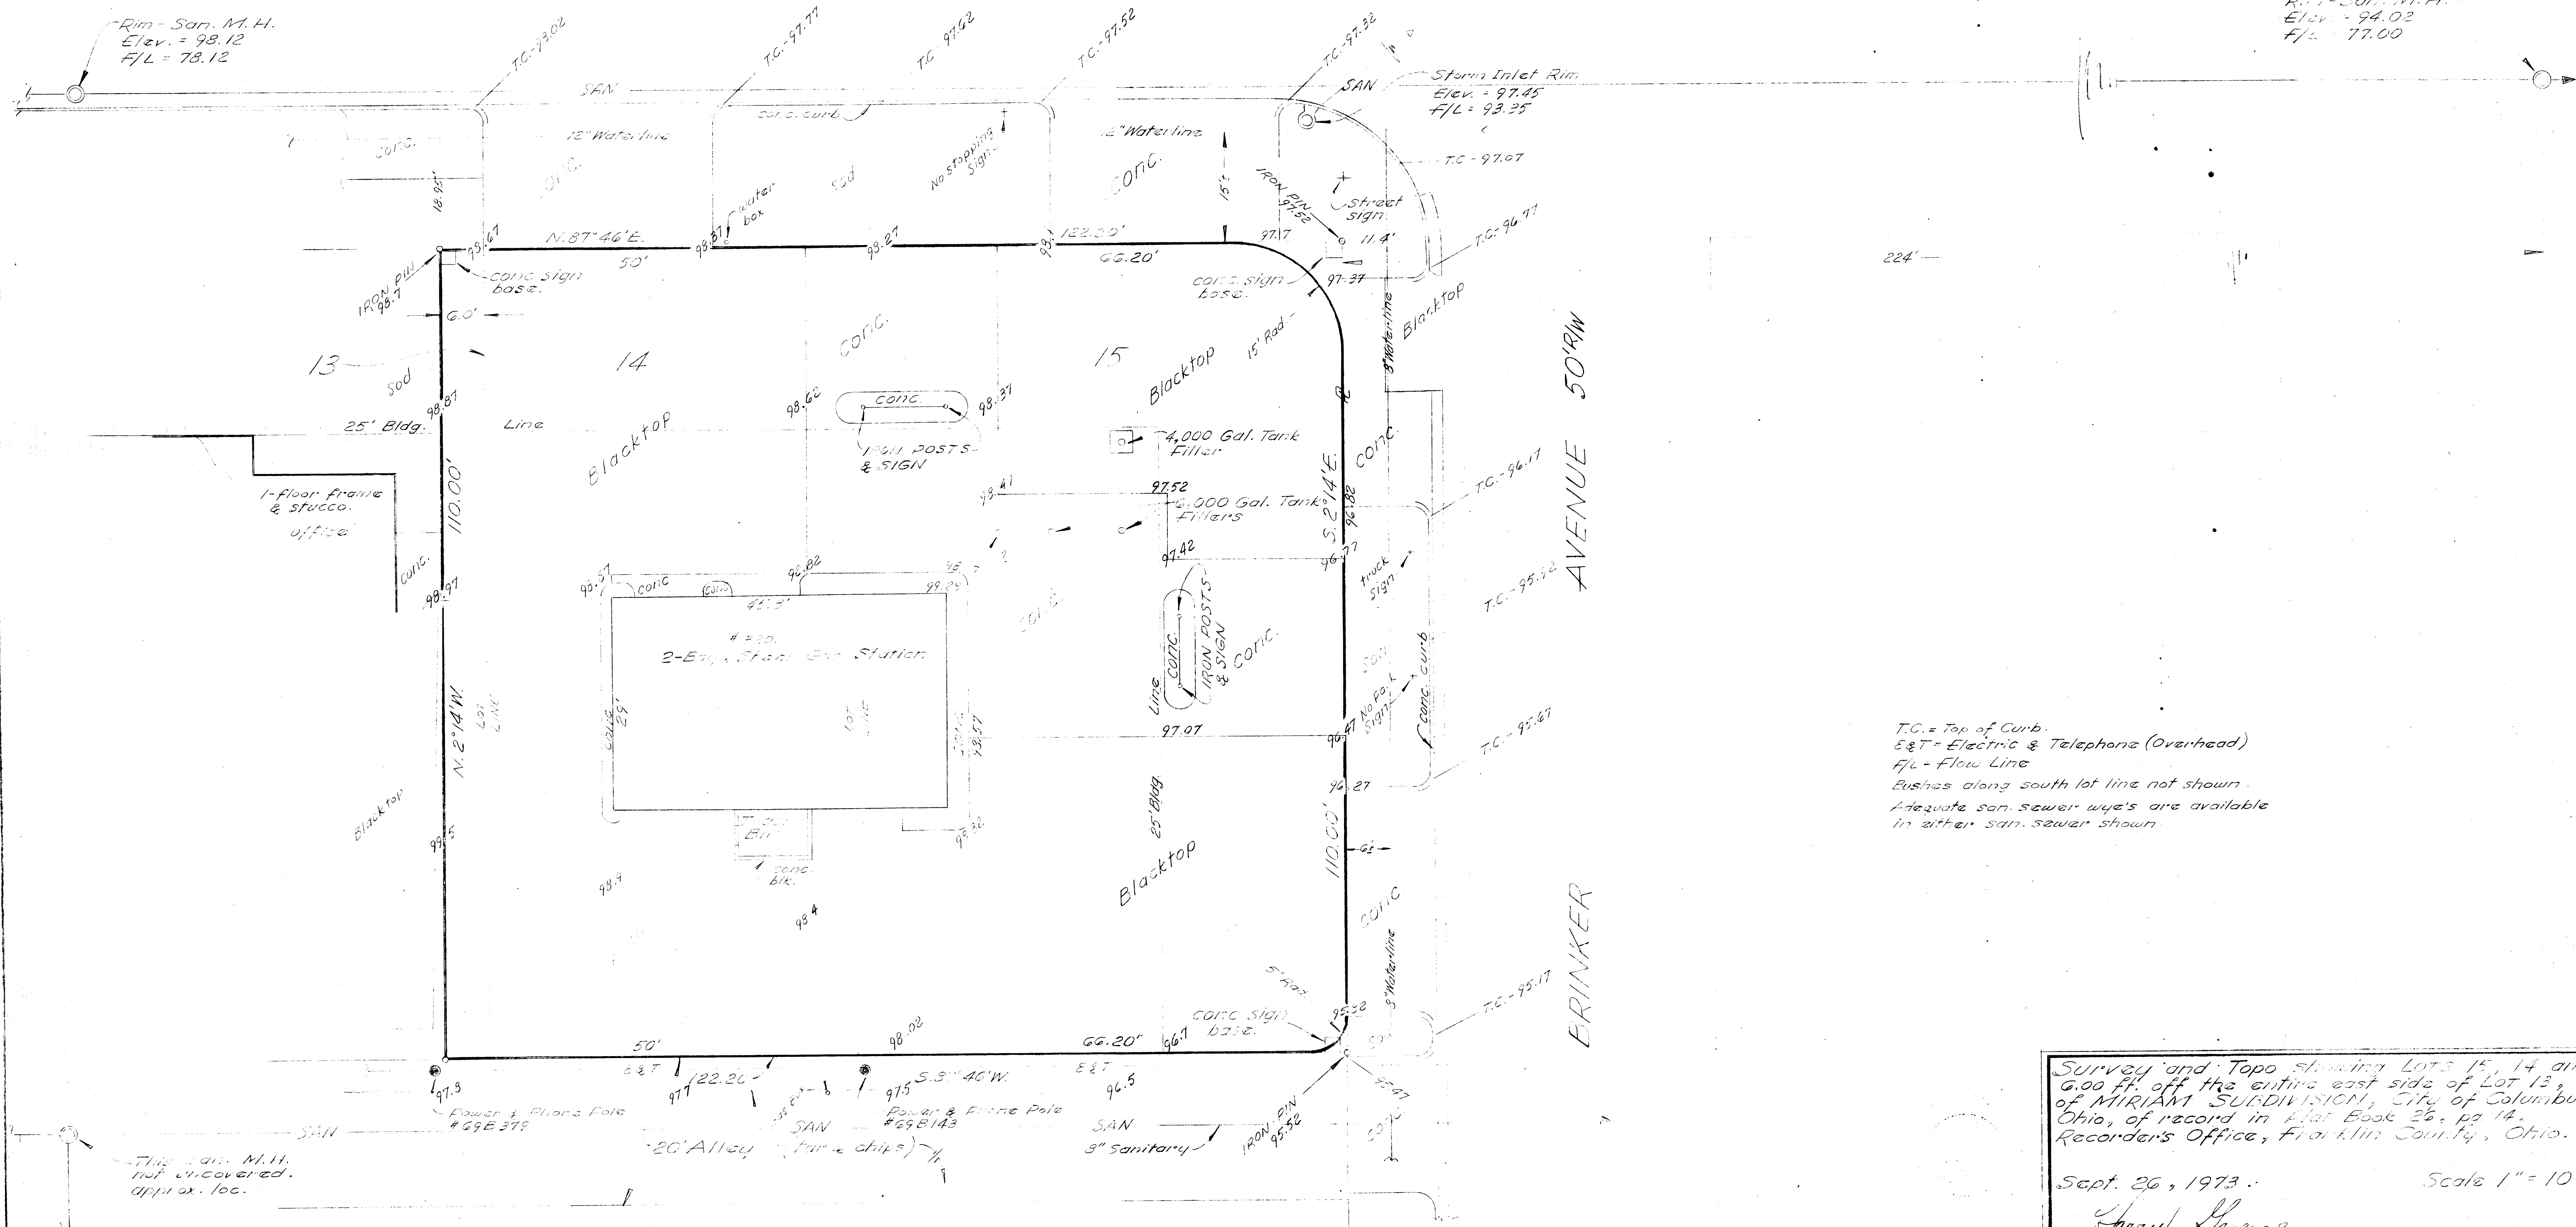

T.C. = Top of Curb.
E&T = Electric & Telephone (Overhead)
F/L = Flow Line
Bushes along south lot line not shown.
Adequate san. sewer wye's are available in either san. sewer shown.

Survey and Topo showing Lots 15, 14 and 6.00 ft. off the entire east side of Lot 13, of MIRIAM SUBDIVISION, City of Columbus, Ohio, of record in Plat Book 26, pg. 14. Recorder's Office, Franklin County, Ohio.

Sep. 26, 1973. Scale 1" = 10'-0"
Joseph L. Greene
Harry L. Greene, Reg. Surveyor - 4053.

1146