


Northeast Corner of 1.48 Acre Tract.

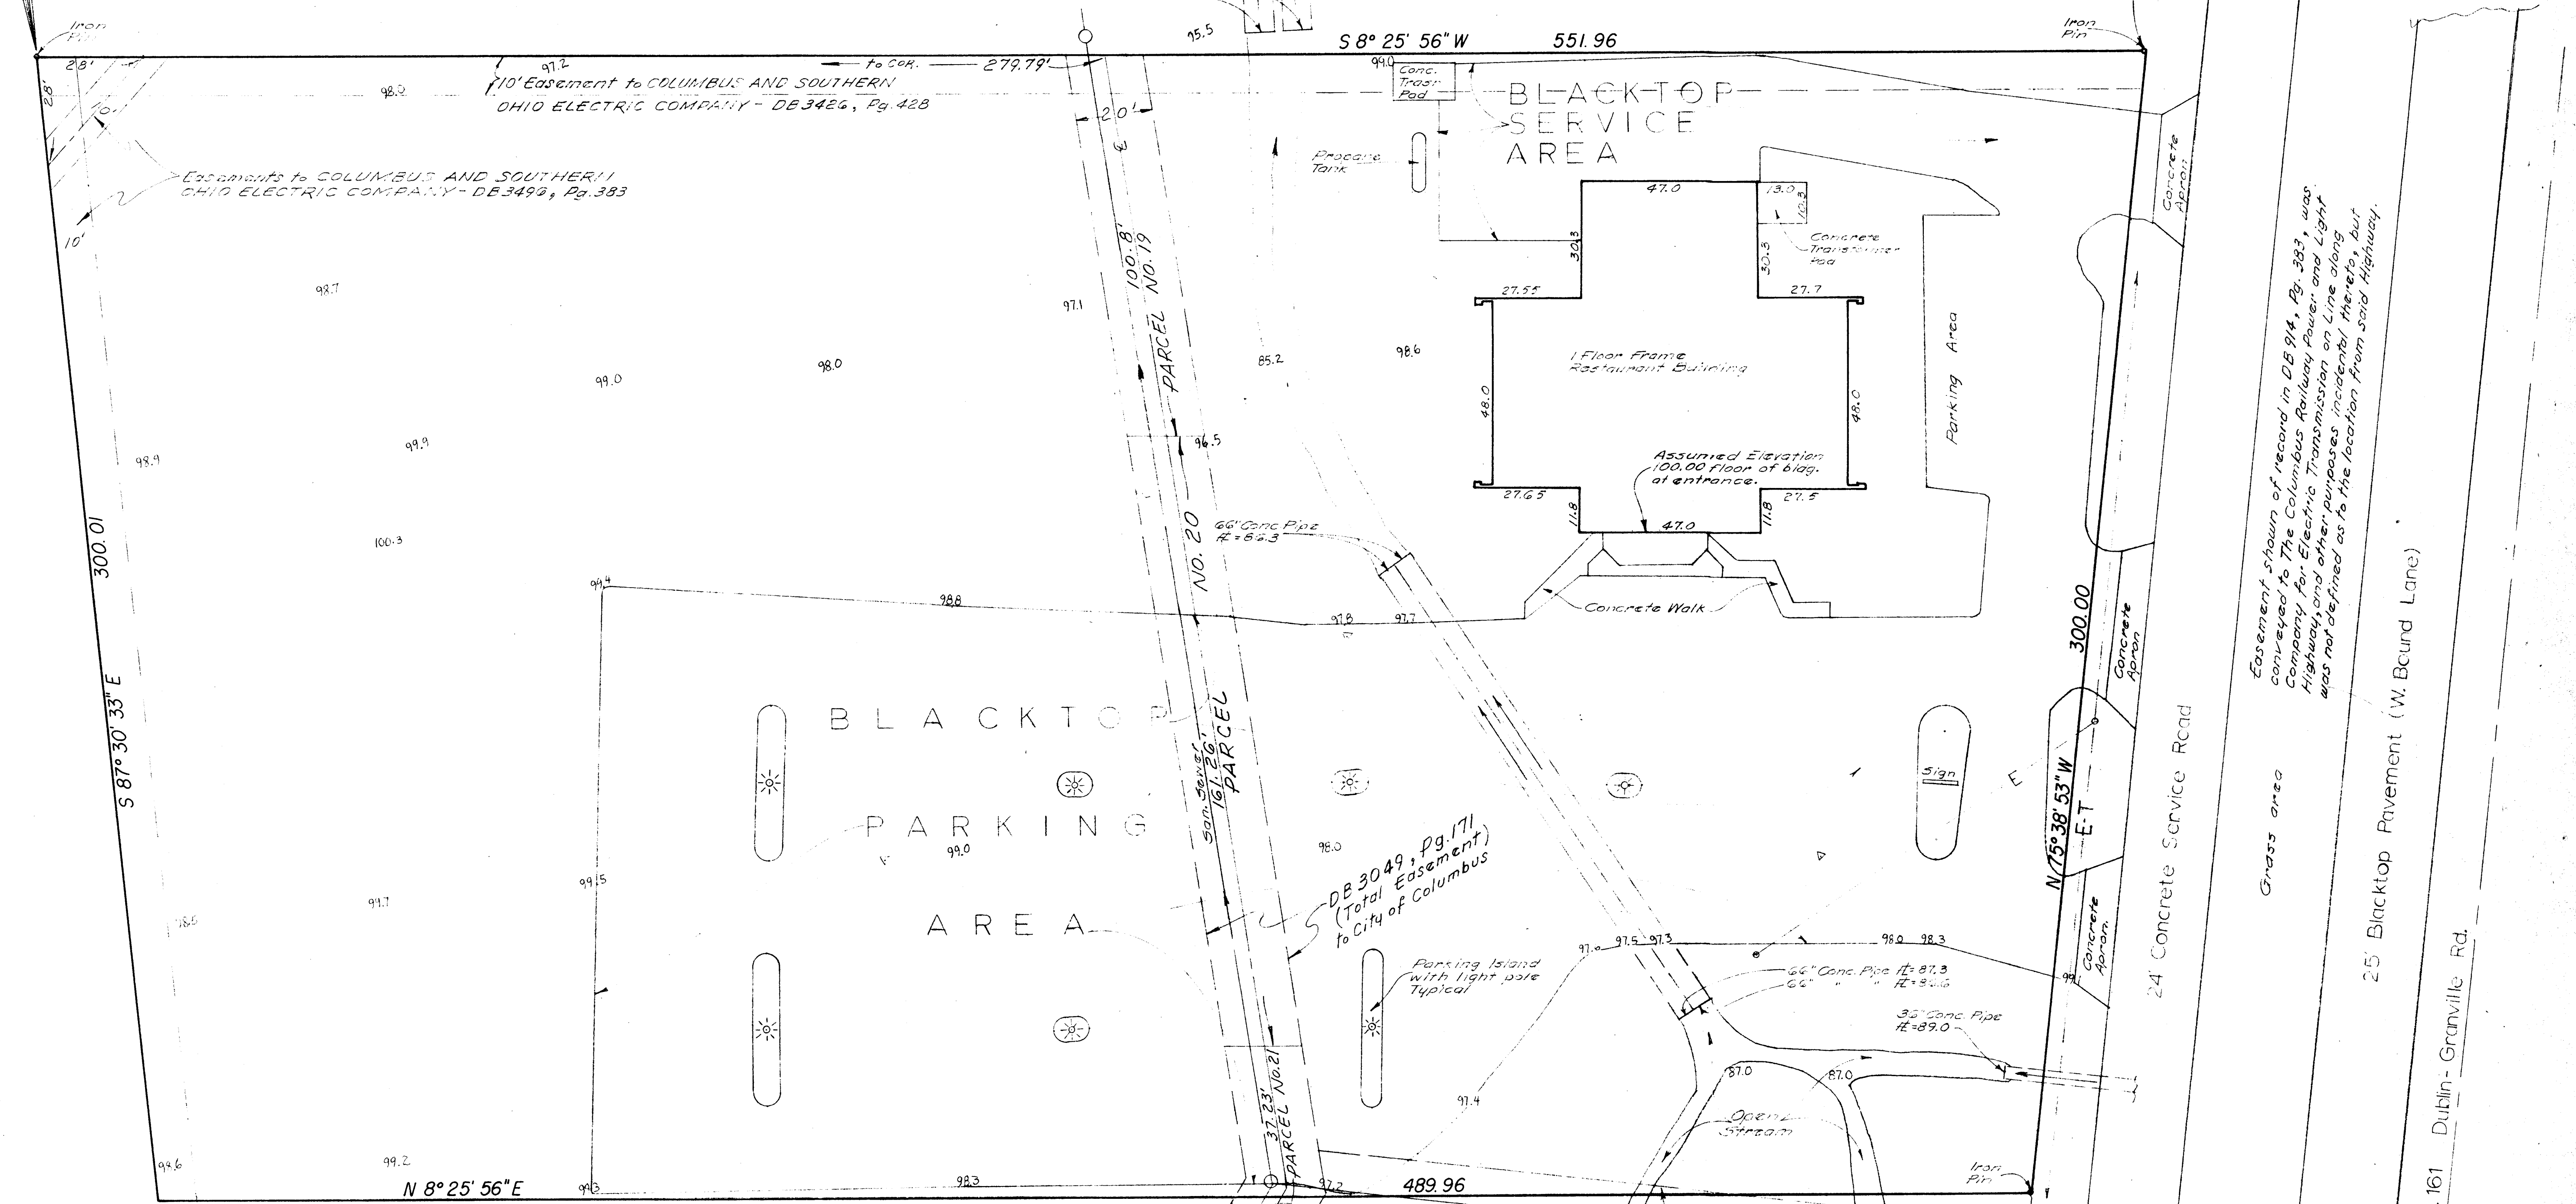


To - C.A. MUEER CORPORATION, TRANSOHIO TITLE AGENCY, INC. and all persons interested in the Title to the premises shown on this Plat.

I hereby certify that I personally made an actual survey of the premises shown on this plat on the 15th day of July 1981, that this plat is a correct representation of the premises as determined by said survey. I further certify that there are no encroachments either way across any boundary line of the premises except as shown hereon.

Signed at Columbus, Ohio this 13th day of May, 1982.

Harry L. Greene, Reg. Surveyor - 4058.

 

Plat showing survey of 3.569 acres, City of Columbus, Franklin County, Ohio.

for Dobb's Houses Inc. DB 3401, Pg. 871.

Scale 1" = 20'

July 1, 1981

Harry L. Greene, Reg. Surveyor No. 4058.