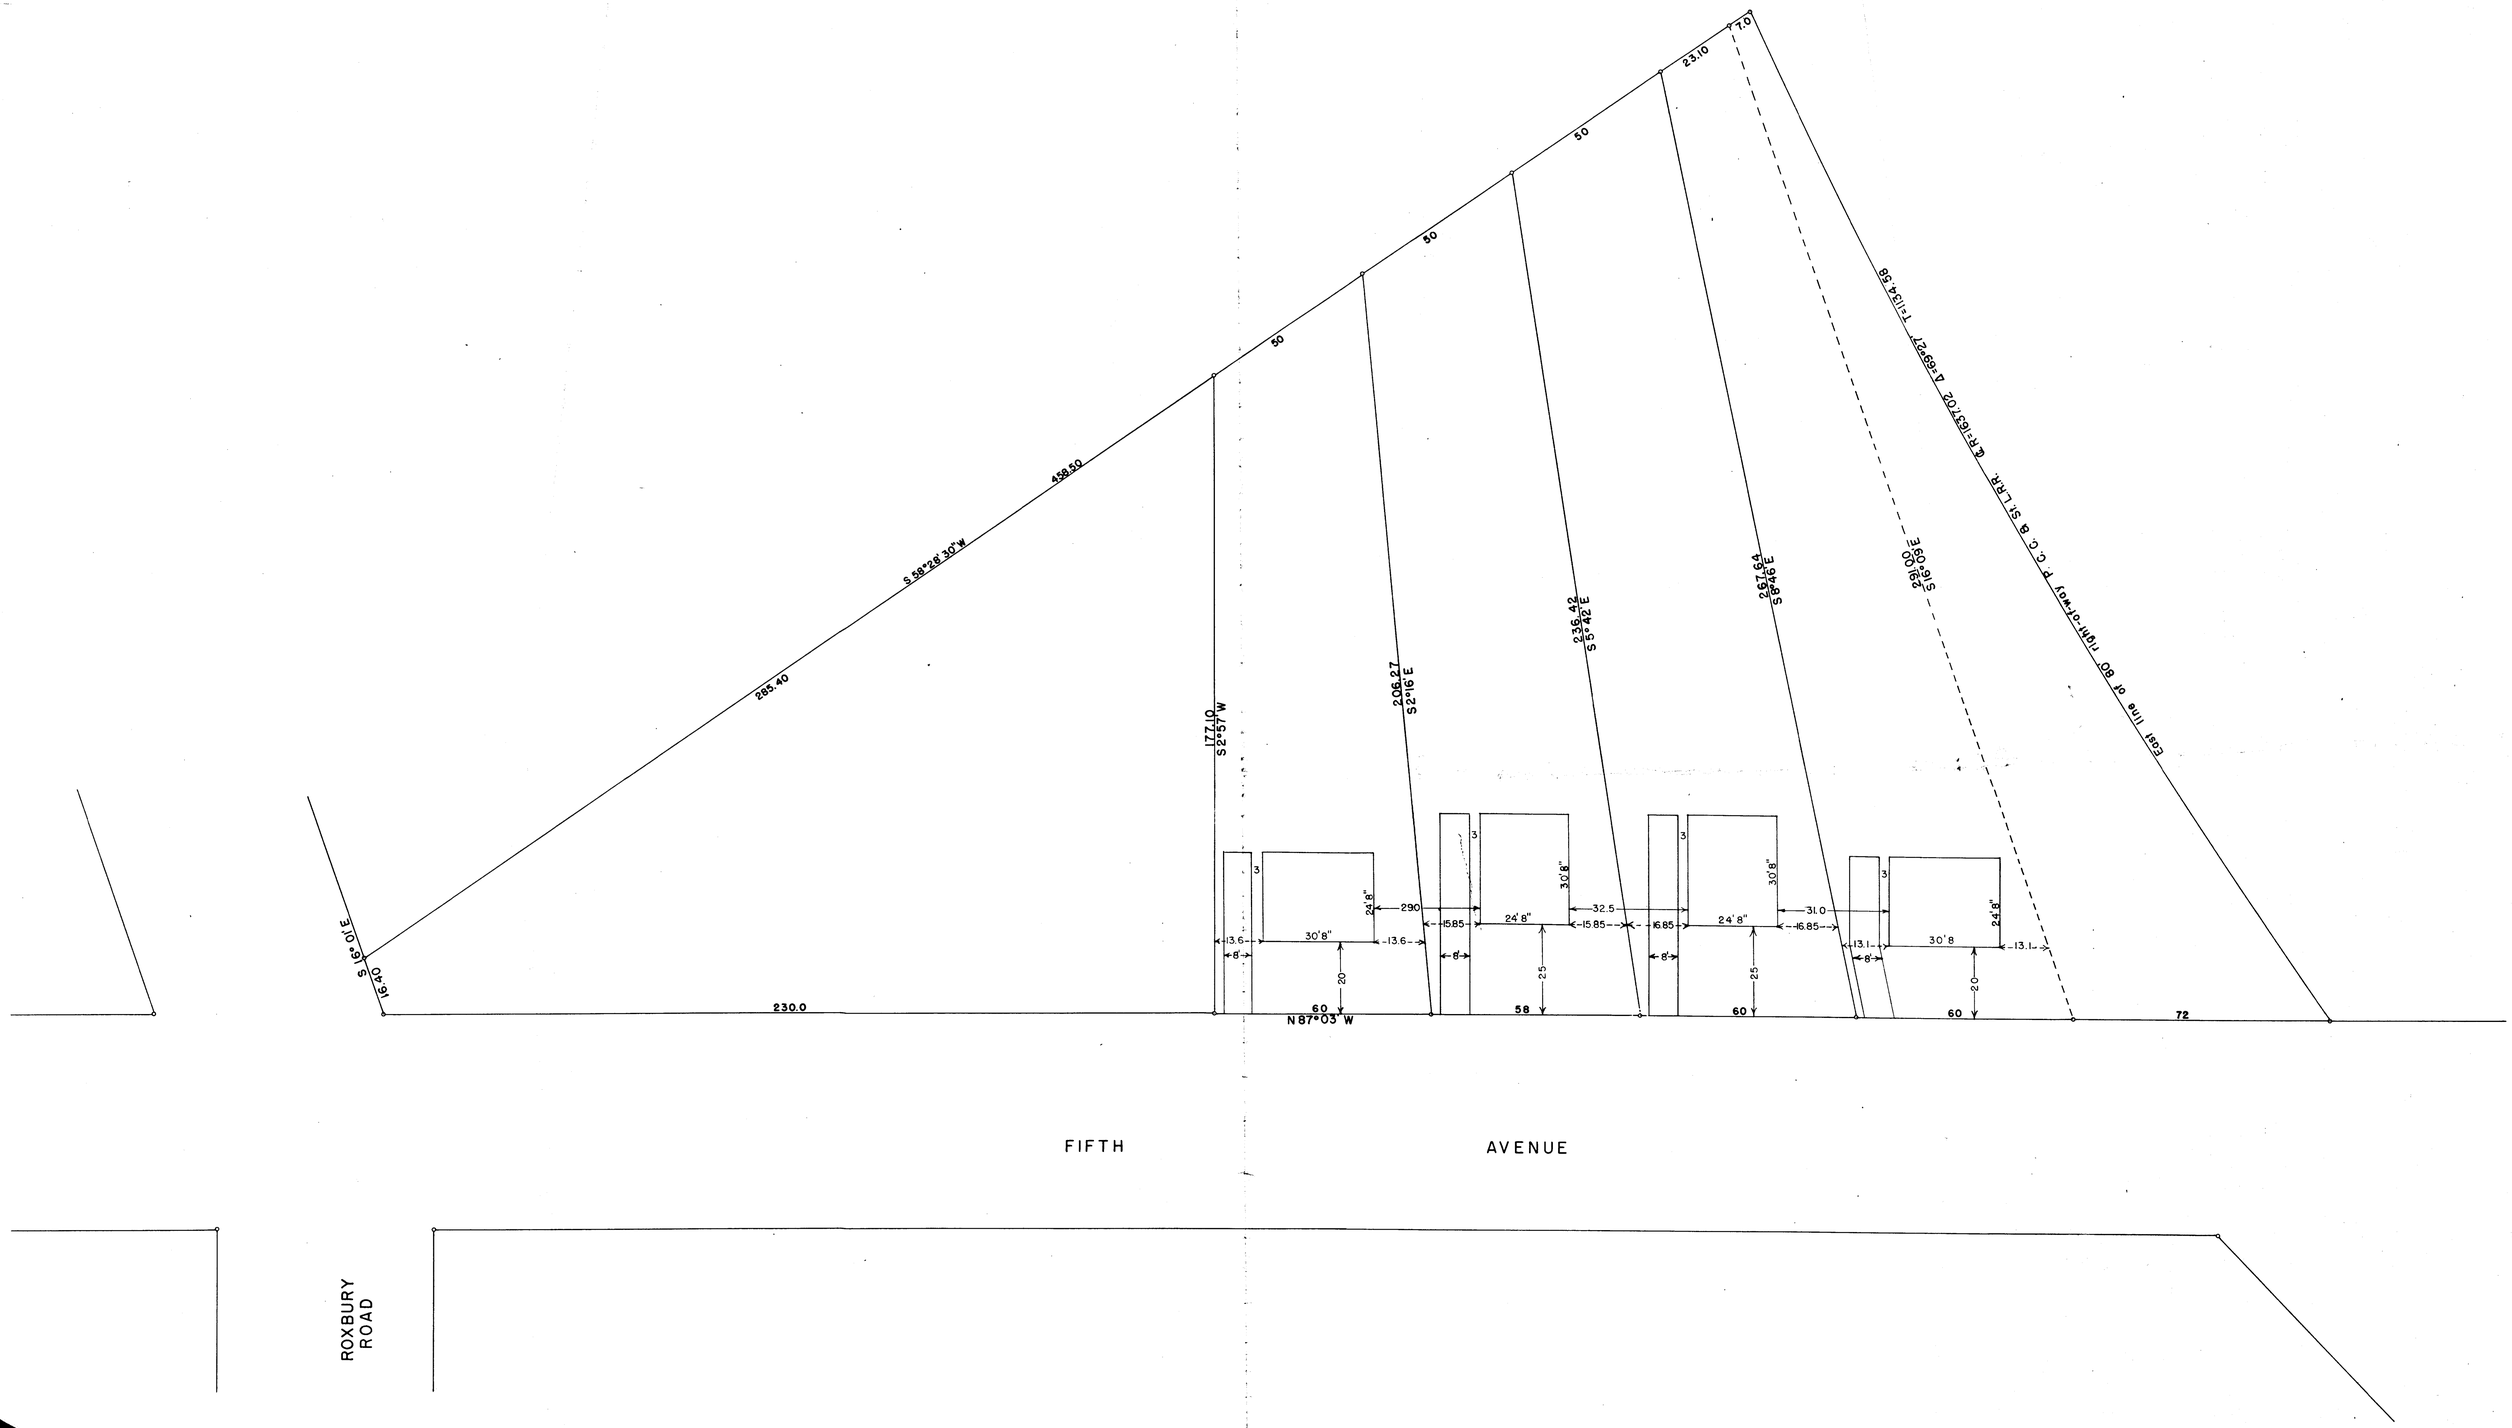
East line of 60' right-of-way P.C.C. & St. L.R.R. & R=1637.02' Δ=69°27' T=1134.58'
S 16°09' E
7.0
23.10
50
50
50
50
458.50
S 58°28' 30" W
285.40
S 2°57' W
177.10
206.27
S 2°16' E
236.42
S 5°42' E
S 8°46' E
S 16°09' E
291.00
S 16°09' E
1.91
230.0
N 87°03' W
60
58
60
60
72
3
3
3
3
30'8"
24'8"
30'8"
24'8"
30'8"
24'8"
30'8
24'8"
13.6
8'
13.6
8'
15.85
8'
15.85
16.85
8'
16.85
13.1
8'
13.1
20
25
25
20
29.0
32.5
31.0
FIFTH
AVENUE
ROXBURY
ROAD