


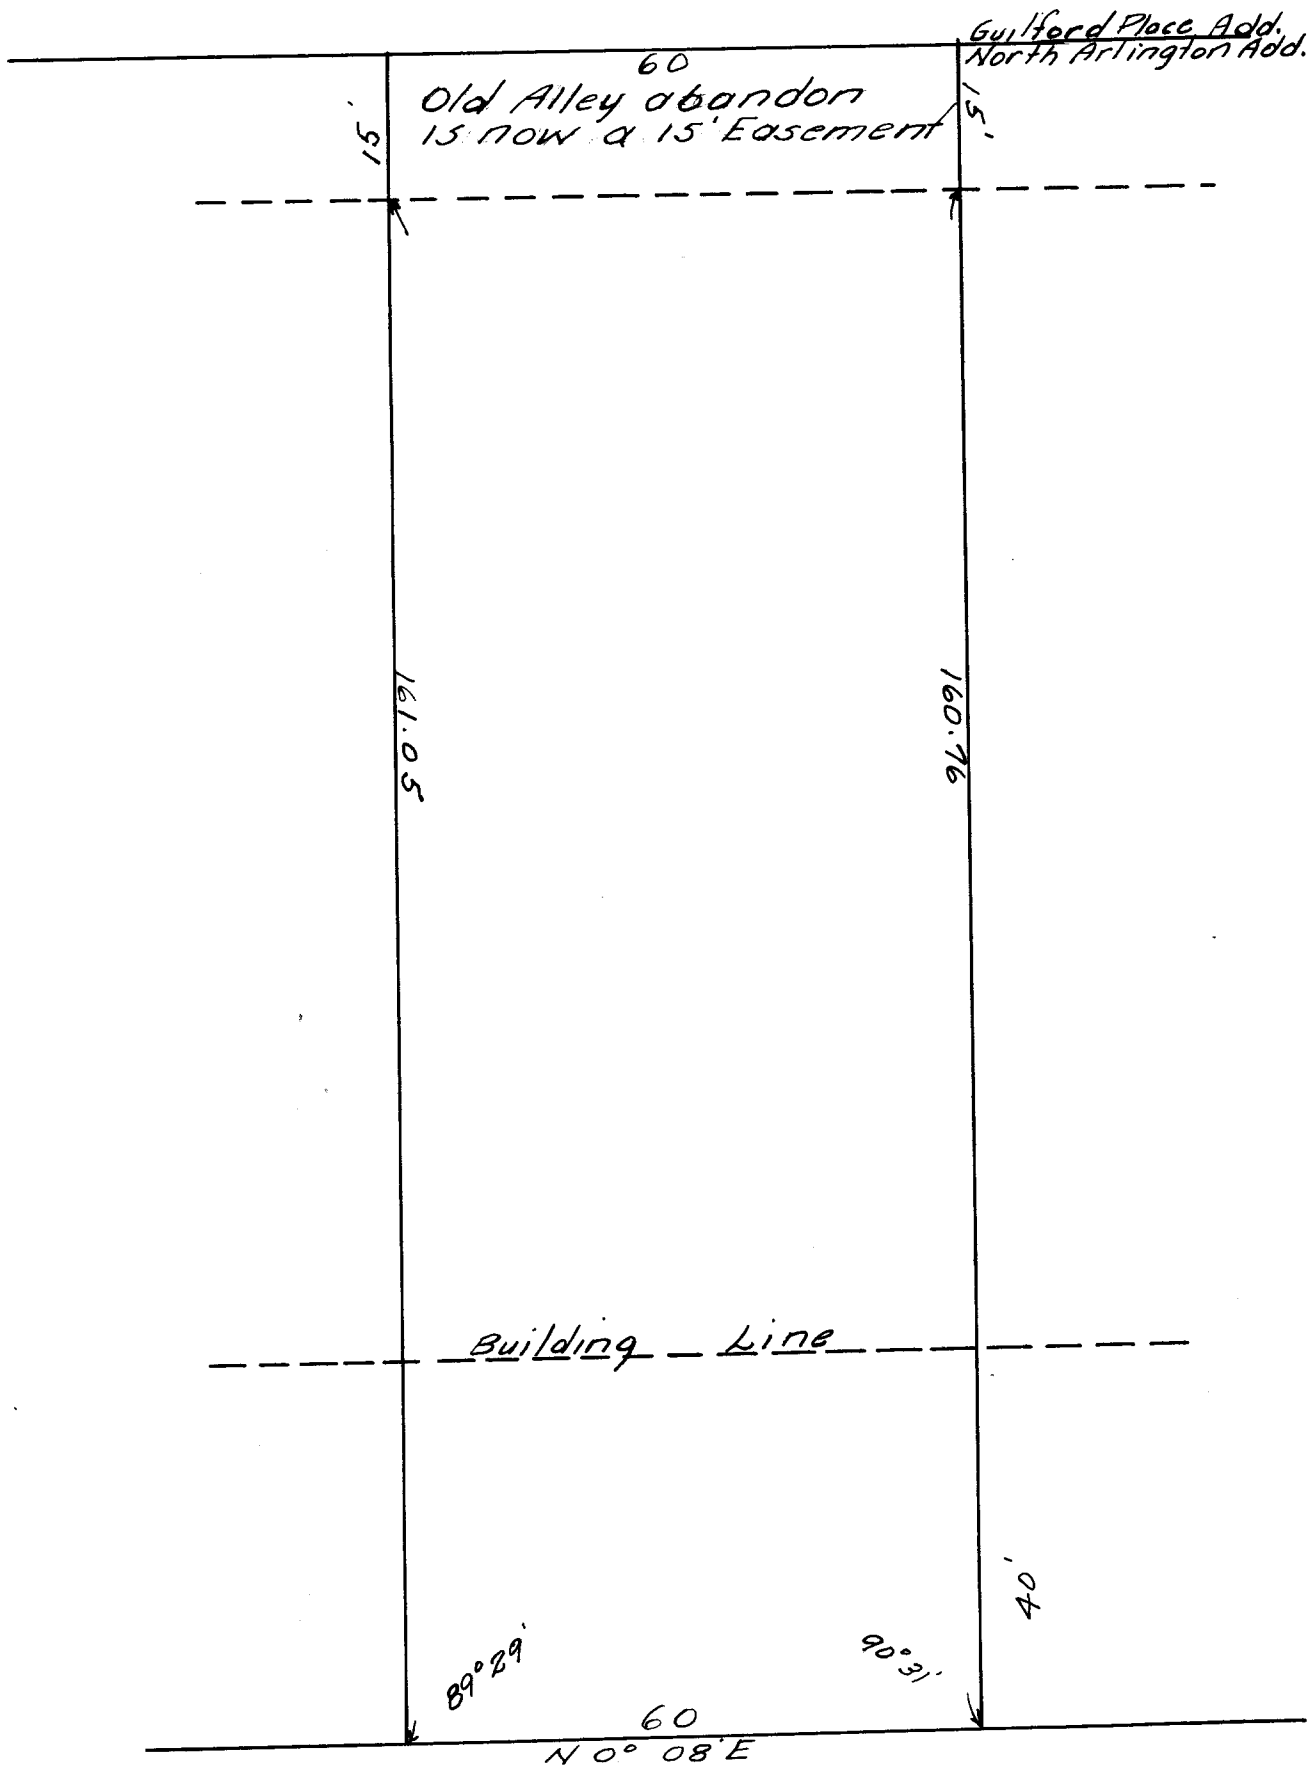

BERWYN

ROAD

Sketch of Lot 9, North Arlington Addition in the Village of Upper Arlington, Franklin Co. Ohio. Scale 1" = 20'

I hereby certify that this sketch is in accordance with the Plat of Record at the Recorders office Franklin Co. Ohio, and that this Lot was surveyed and staked in accordance with this sketch. There are no Encroachments on this Lot.

D.B. Sayers.
Civil Engineer

Date 9-6-40