


Survey of Lot 192, B.F. Martins Western Add.
and Location of Double and 9" Firewall on same.

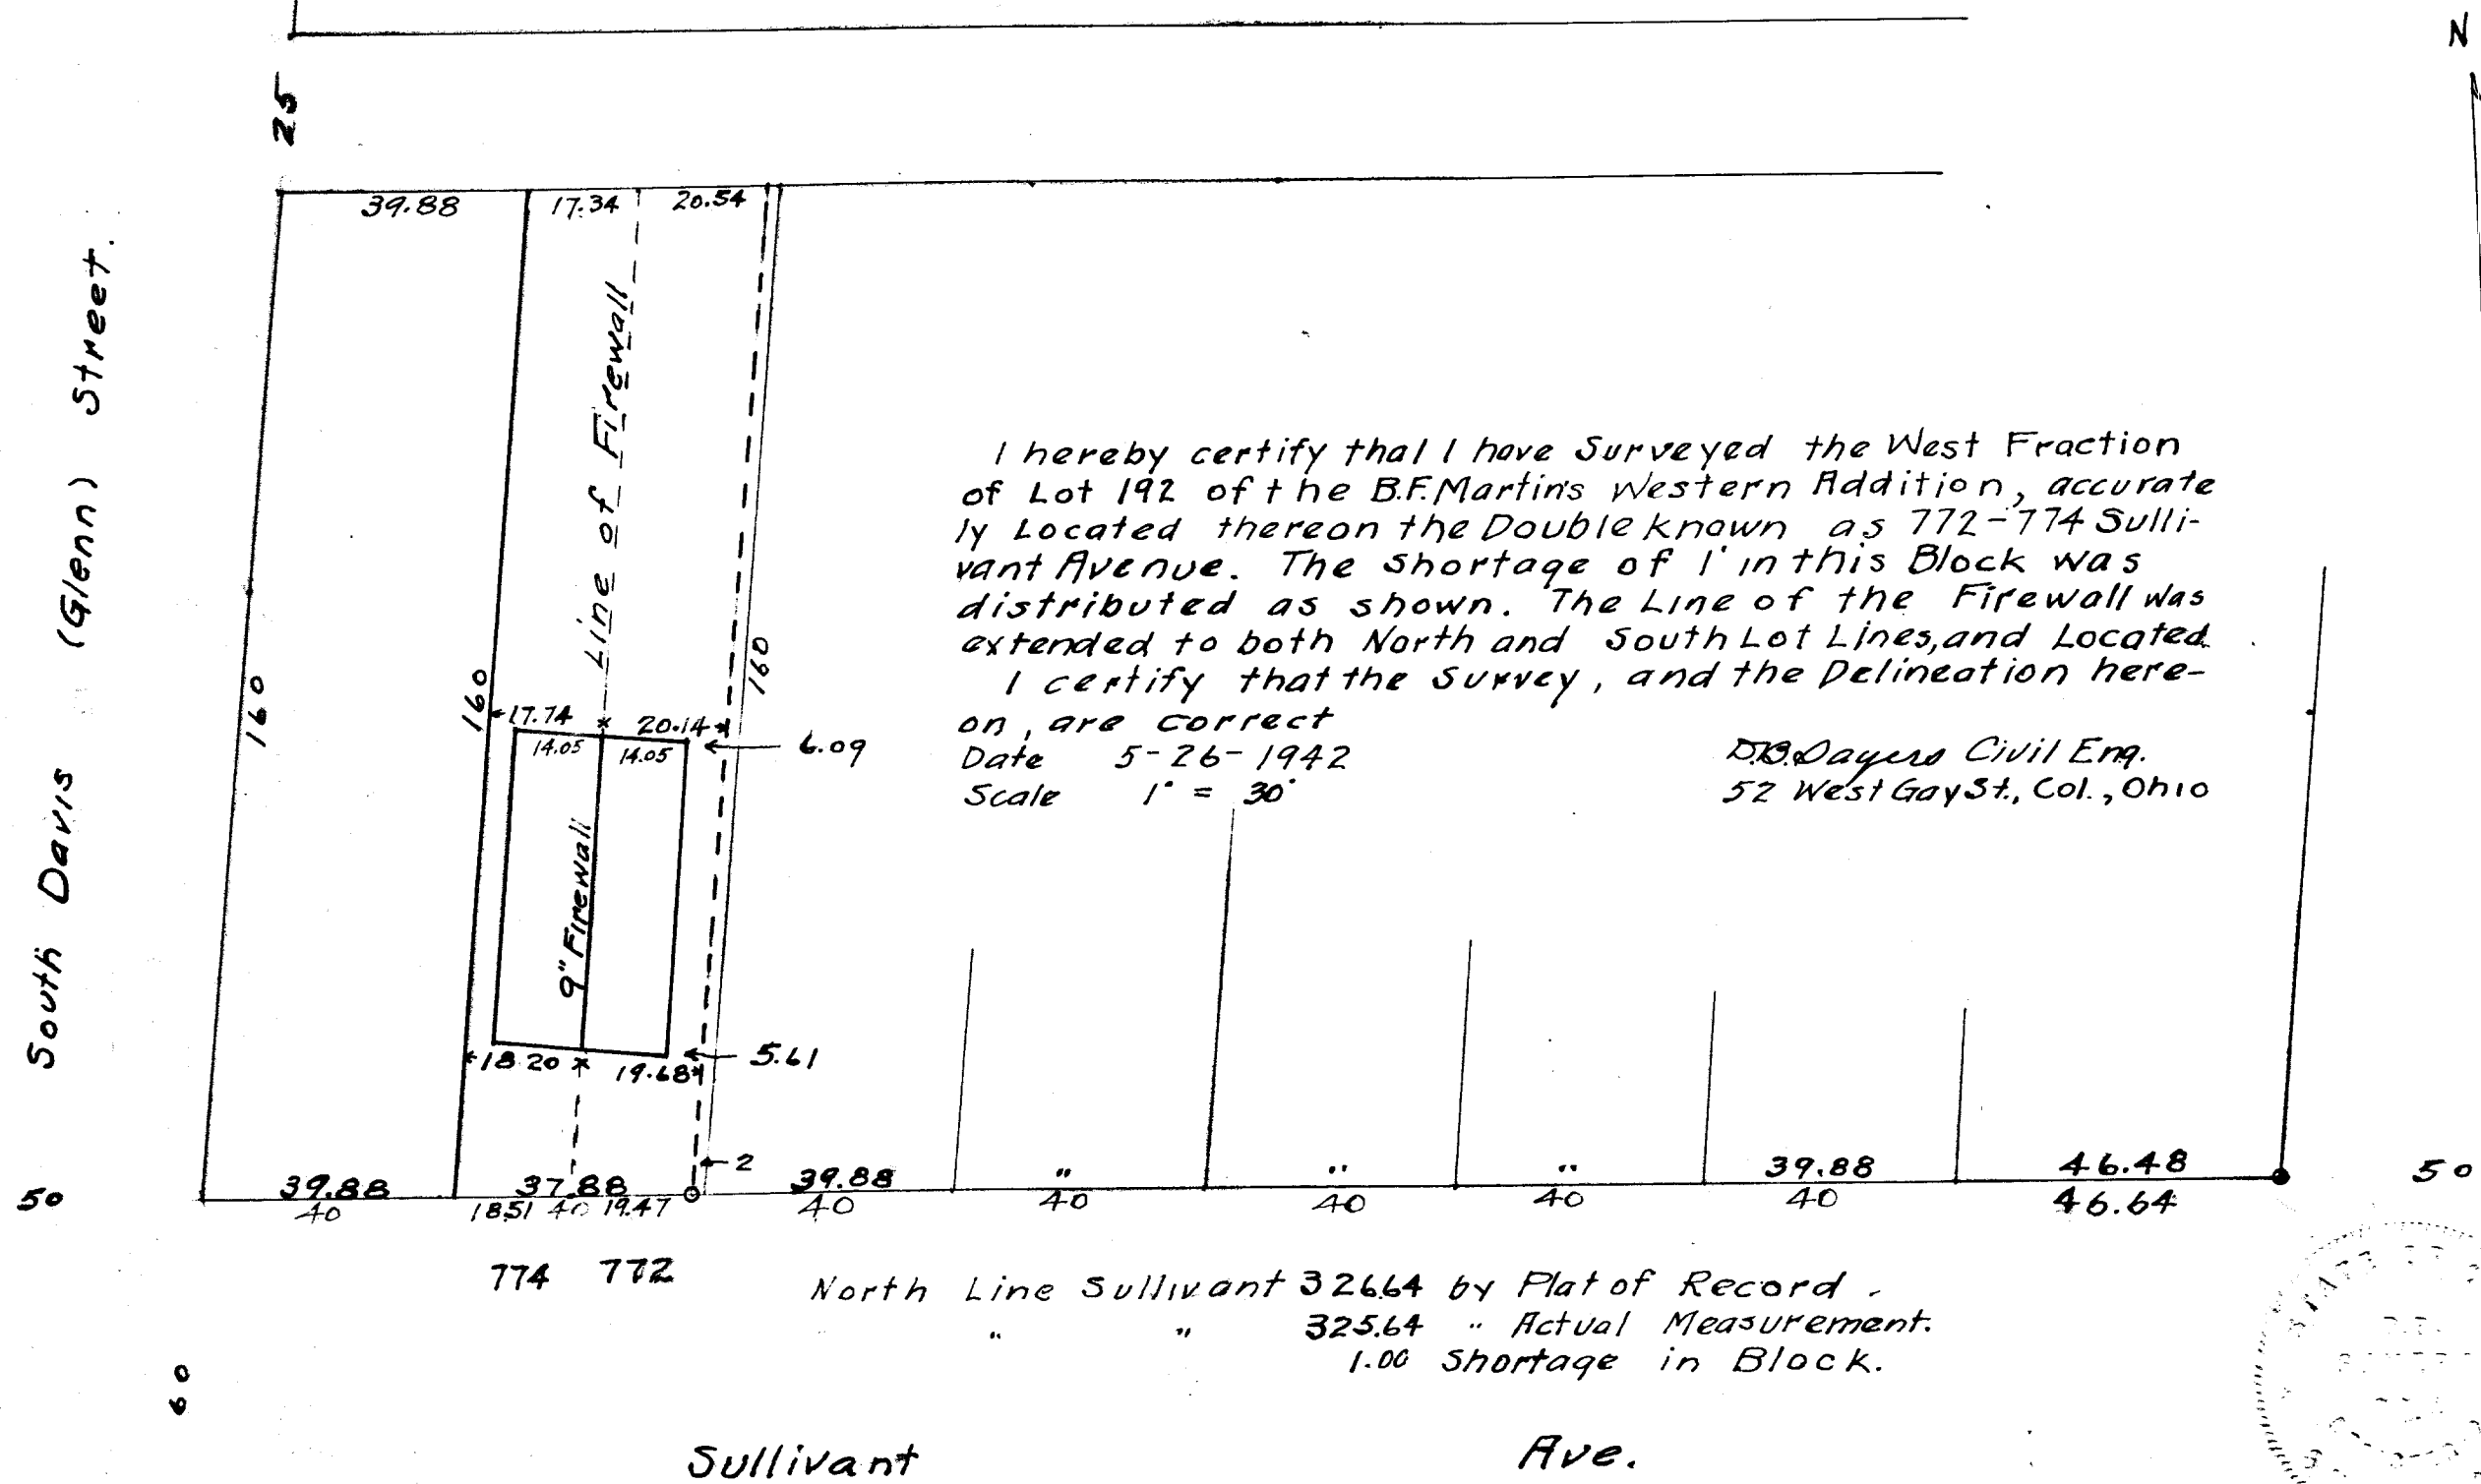

I hereby certify that I have Surveyed the West Fraction of Lot 192 of the B.F. Martins Western Addition, accurately Located thereon the Double known as 772-774 Sullivant Avenue. The shortage of 1' in this Block was distributed as shown. The Line of the Firewall was extended to both North and South Lot Lines, and Located.

I certify that the Survey, and the Delineation hereon, are correct
 Date 5-26-1942
 Scale 1" = 30'

D.B. Dayer Civil Eng.
52 West Gay St., Col., Ohio

North Line Sullivant 326.64 by Plat of Record -
 " " 325.64 " Actual Measurement.
 1.00 Shortage in Block.

