


SURVEY OF LOTS NOS. 9,10,11,12 BLOCK NO. 226 MOUNTVIEW PLACE ADD. EXT. NO. 2
 CITY OF UPPER ARLINGTON, PERRY TOWNSHIP, FRANKLIN COUNTY, OHIO.

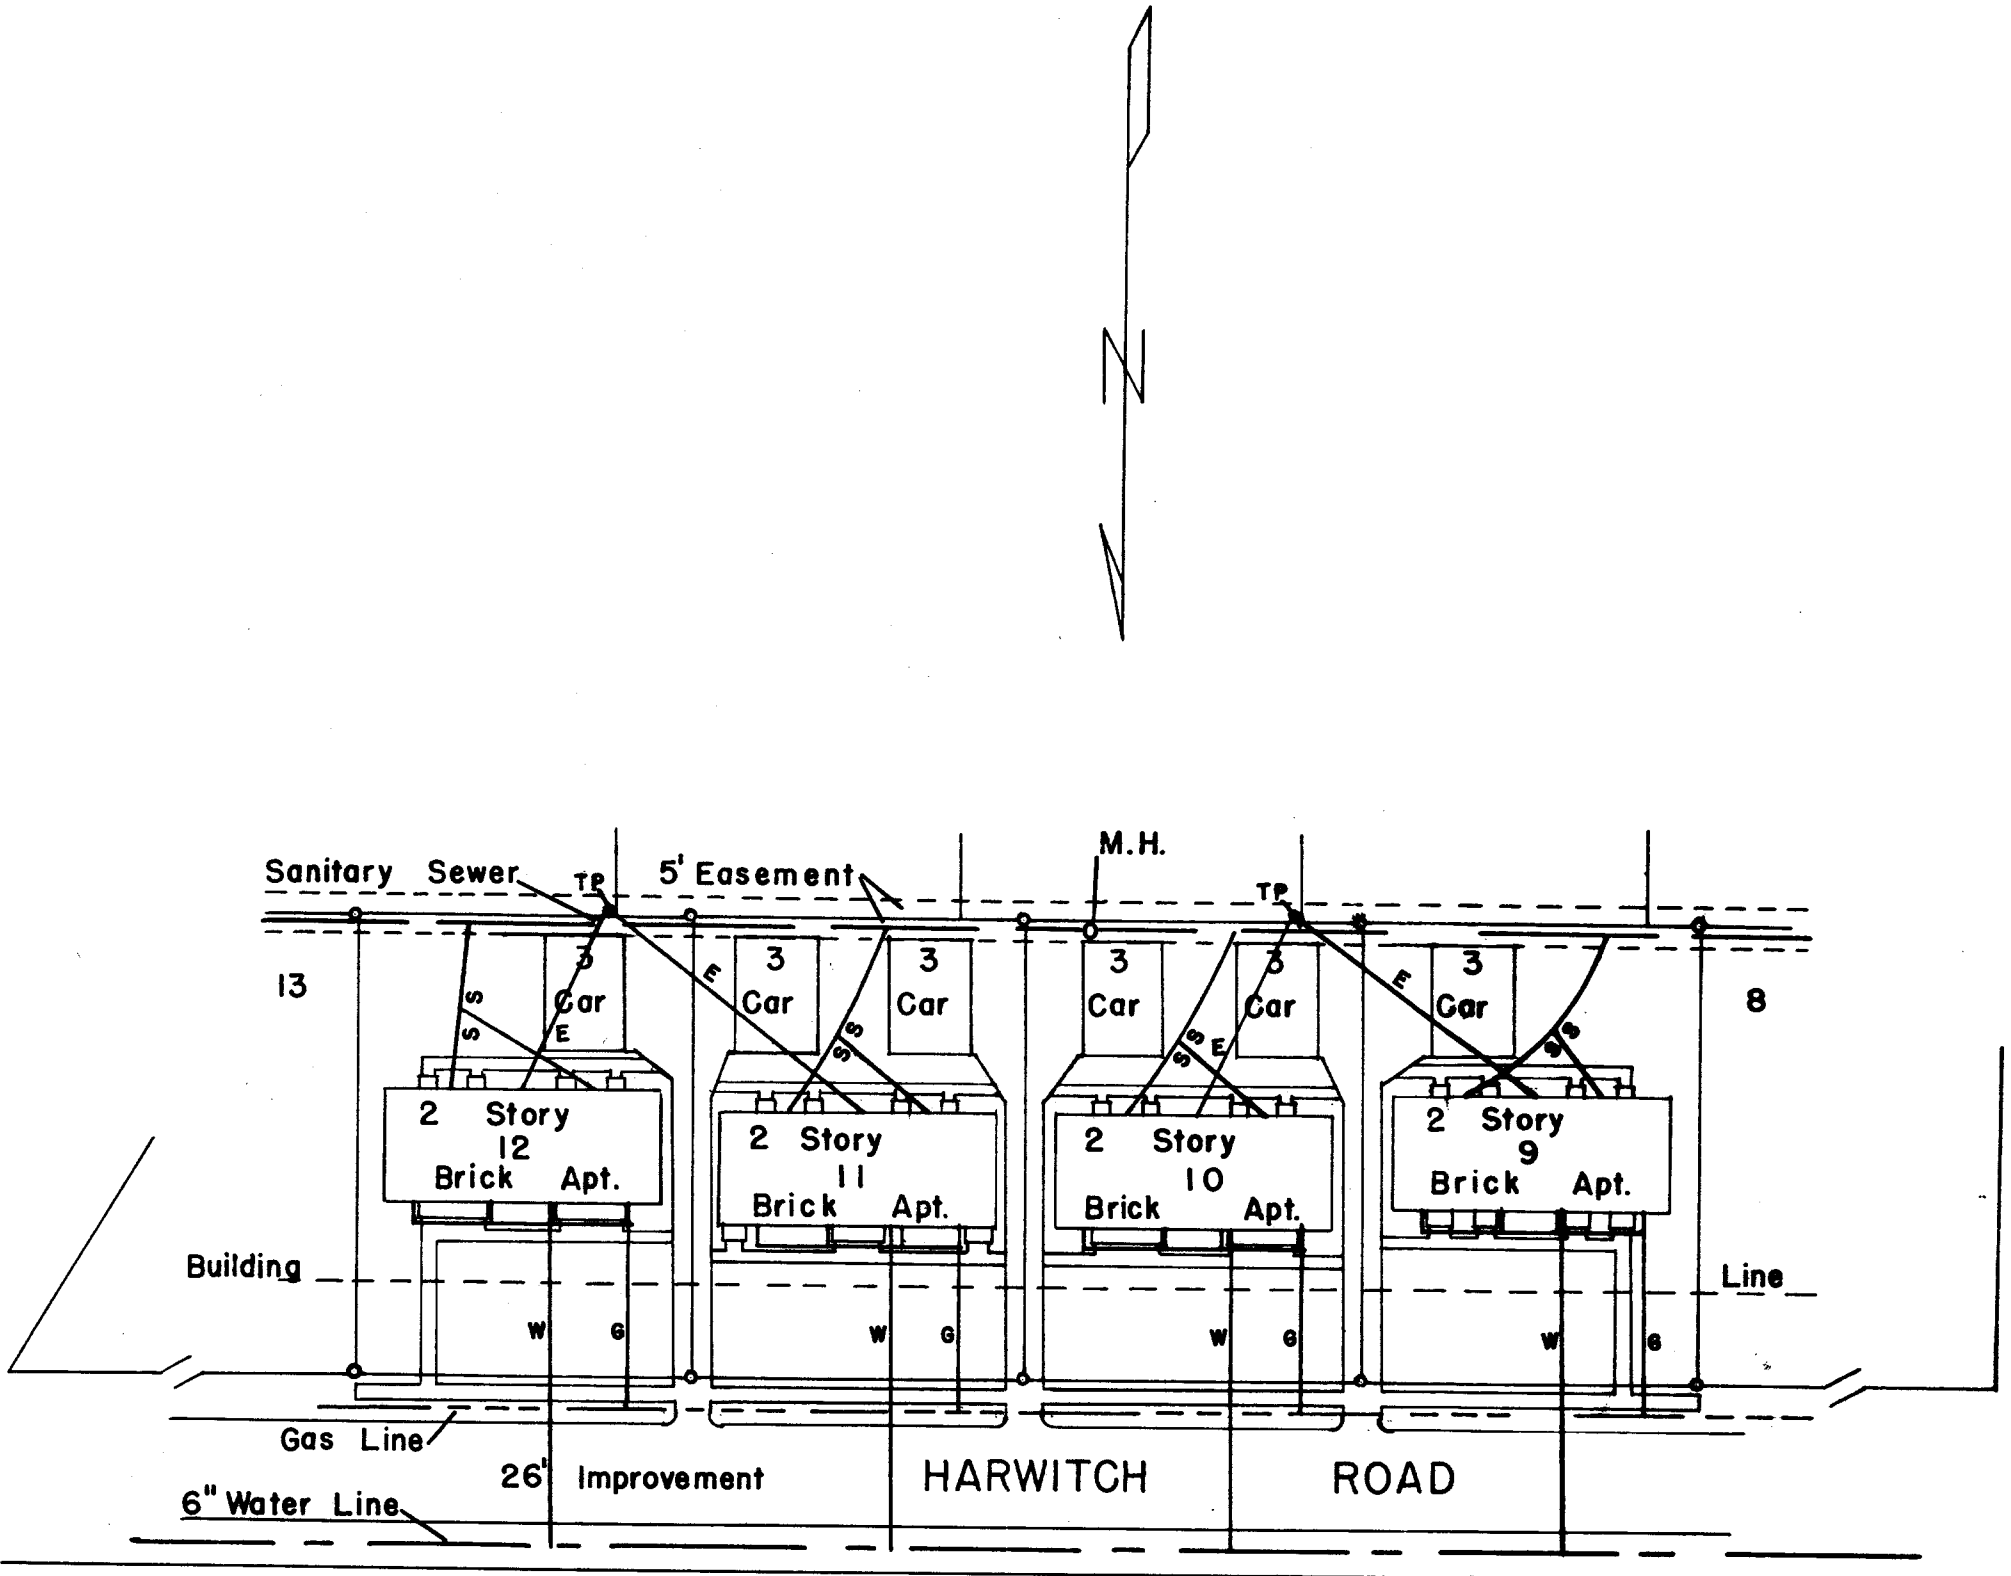

TO ALL PARTIES INTERESTED IN TITLE TO PREMISES SURVEYED.

Scale: 1" = 50'

MAY 19, 1950

This survey made for the benefit of John Hancock Mutual Life Insurance Company, F. H. A., and the Ohio Title Corporation.

I hereby certify that this survey shows the buildings and utilities as located on the premises, that the buildings and utilities are erected and installed entirely upon the land covered by the mortgage and within the building restriction lines on said land, and does not overhang or encroach upon any easement or right-of-way of others.

TP = ELECT. POLE
 SS = SANITARY SEWER
 W = WATER

E = ELECTRICITY
 G = GAS

Frank T. Sayers
 FRANK T. SAYERS
 Reg. Surveyor. 3144