


SURVEY OF LOTS NOS.9,10,11,12. BLOCK NO.226. MOUNTVIEW PLACE ADD. EXT. NO. 2
 CITY OF UPPER ARLINGTON, PERRY TOWNSHIP, FRANKLIN COUNTY, OHIO.

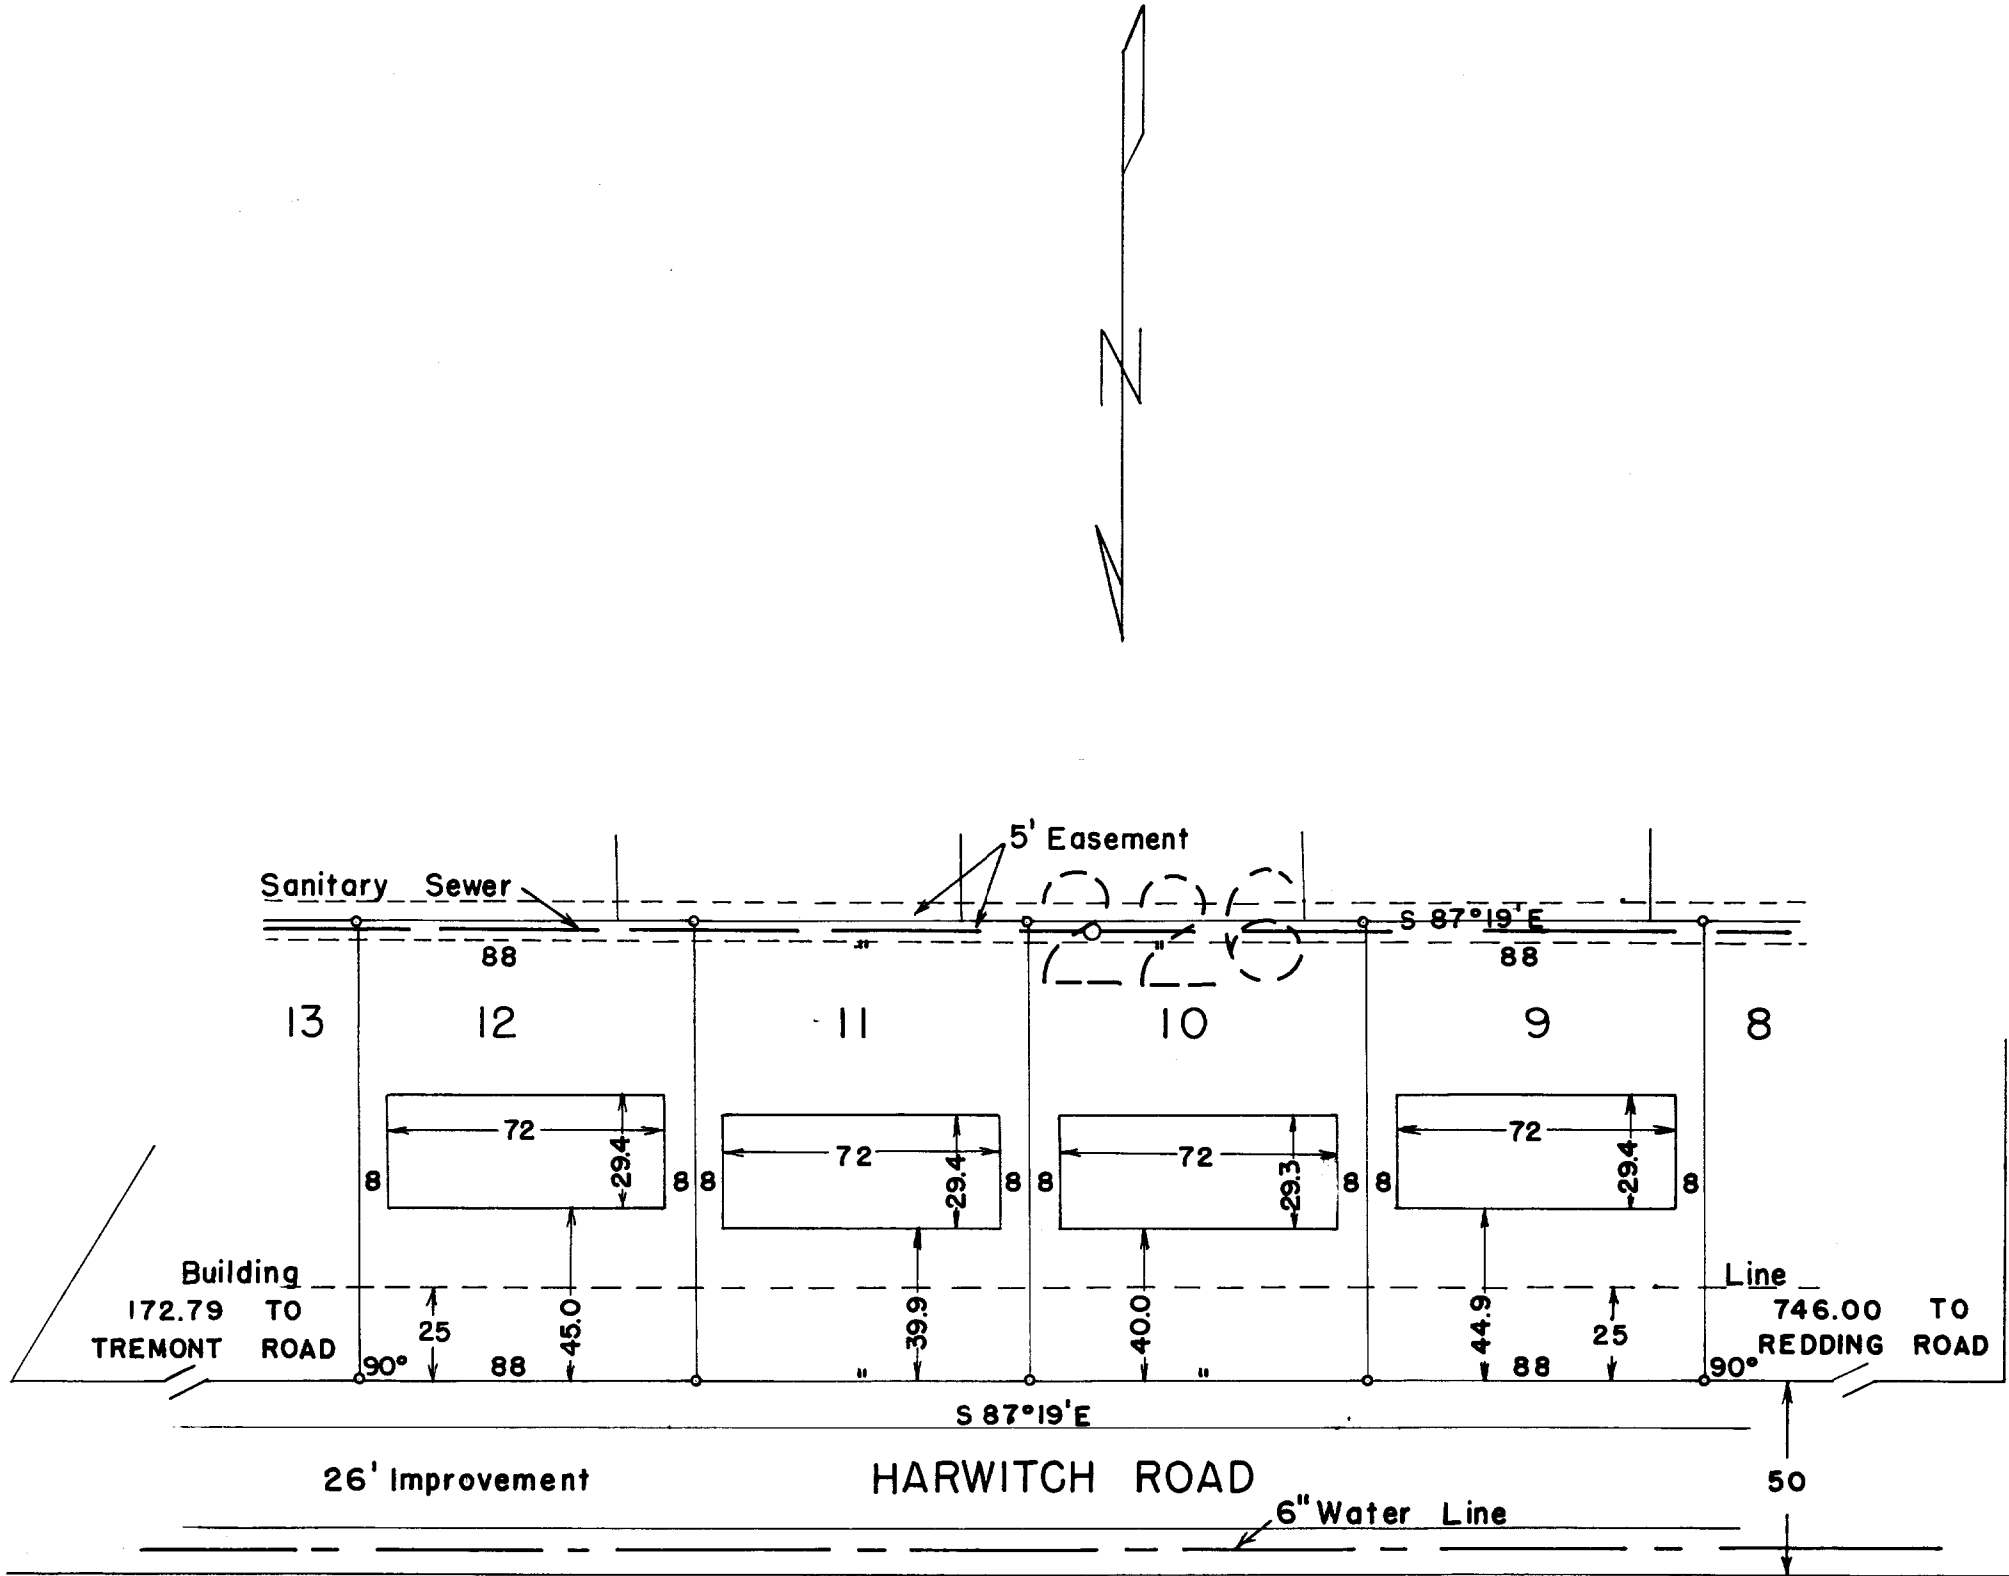

TO ALL PARTIES INTERESTED IN TITLE TO PREMISES SURVEYED.

Scale: 1" = 50'

Dec. 24, 1949.

This survey made for the benefit of John Hancock Mutual Life Insurance Company, Federal Housing Administration, Ohio Title Corporation.

I certify that I have surveyed Lots Nos.9,10,11, 12, Block No.226, Upper Arlington and have located the foundations thereon.

Frank T. Sayers

FRANK T. SAYERS.
 Reg. Surveyor. 3144.