


Proposed Layout - Florence Lakin Acreage.

127580-1493-520  
= 2.013 AC

Fairfax Road S86°25'E 832.80

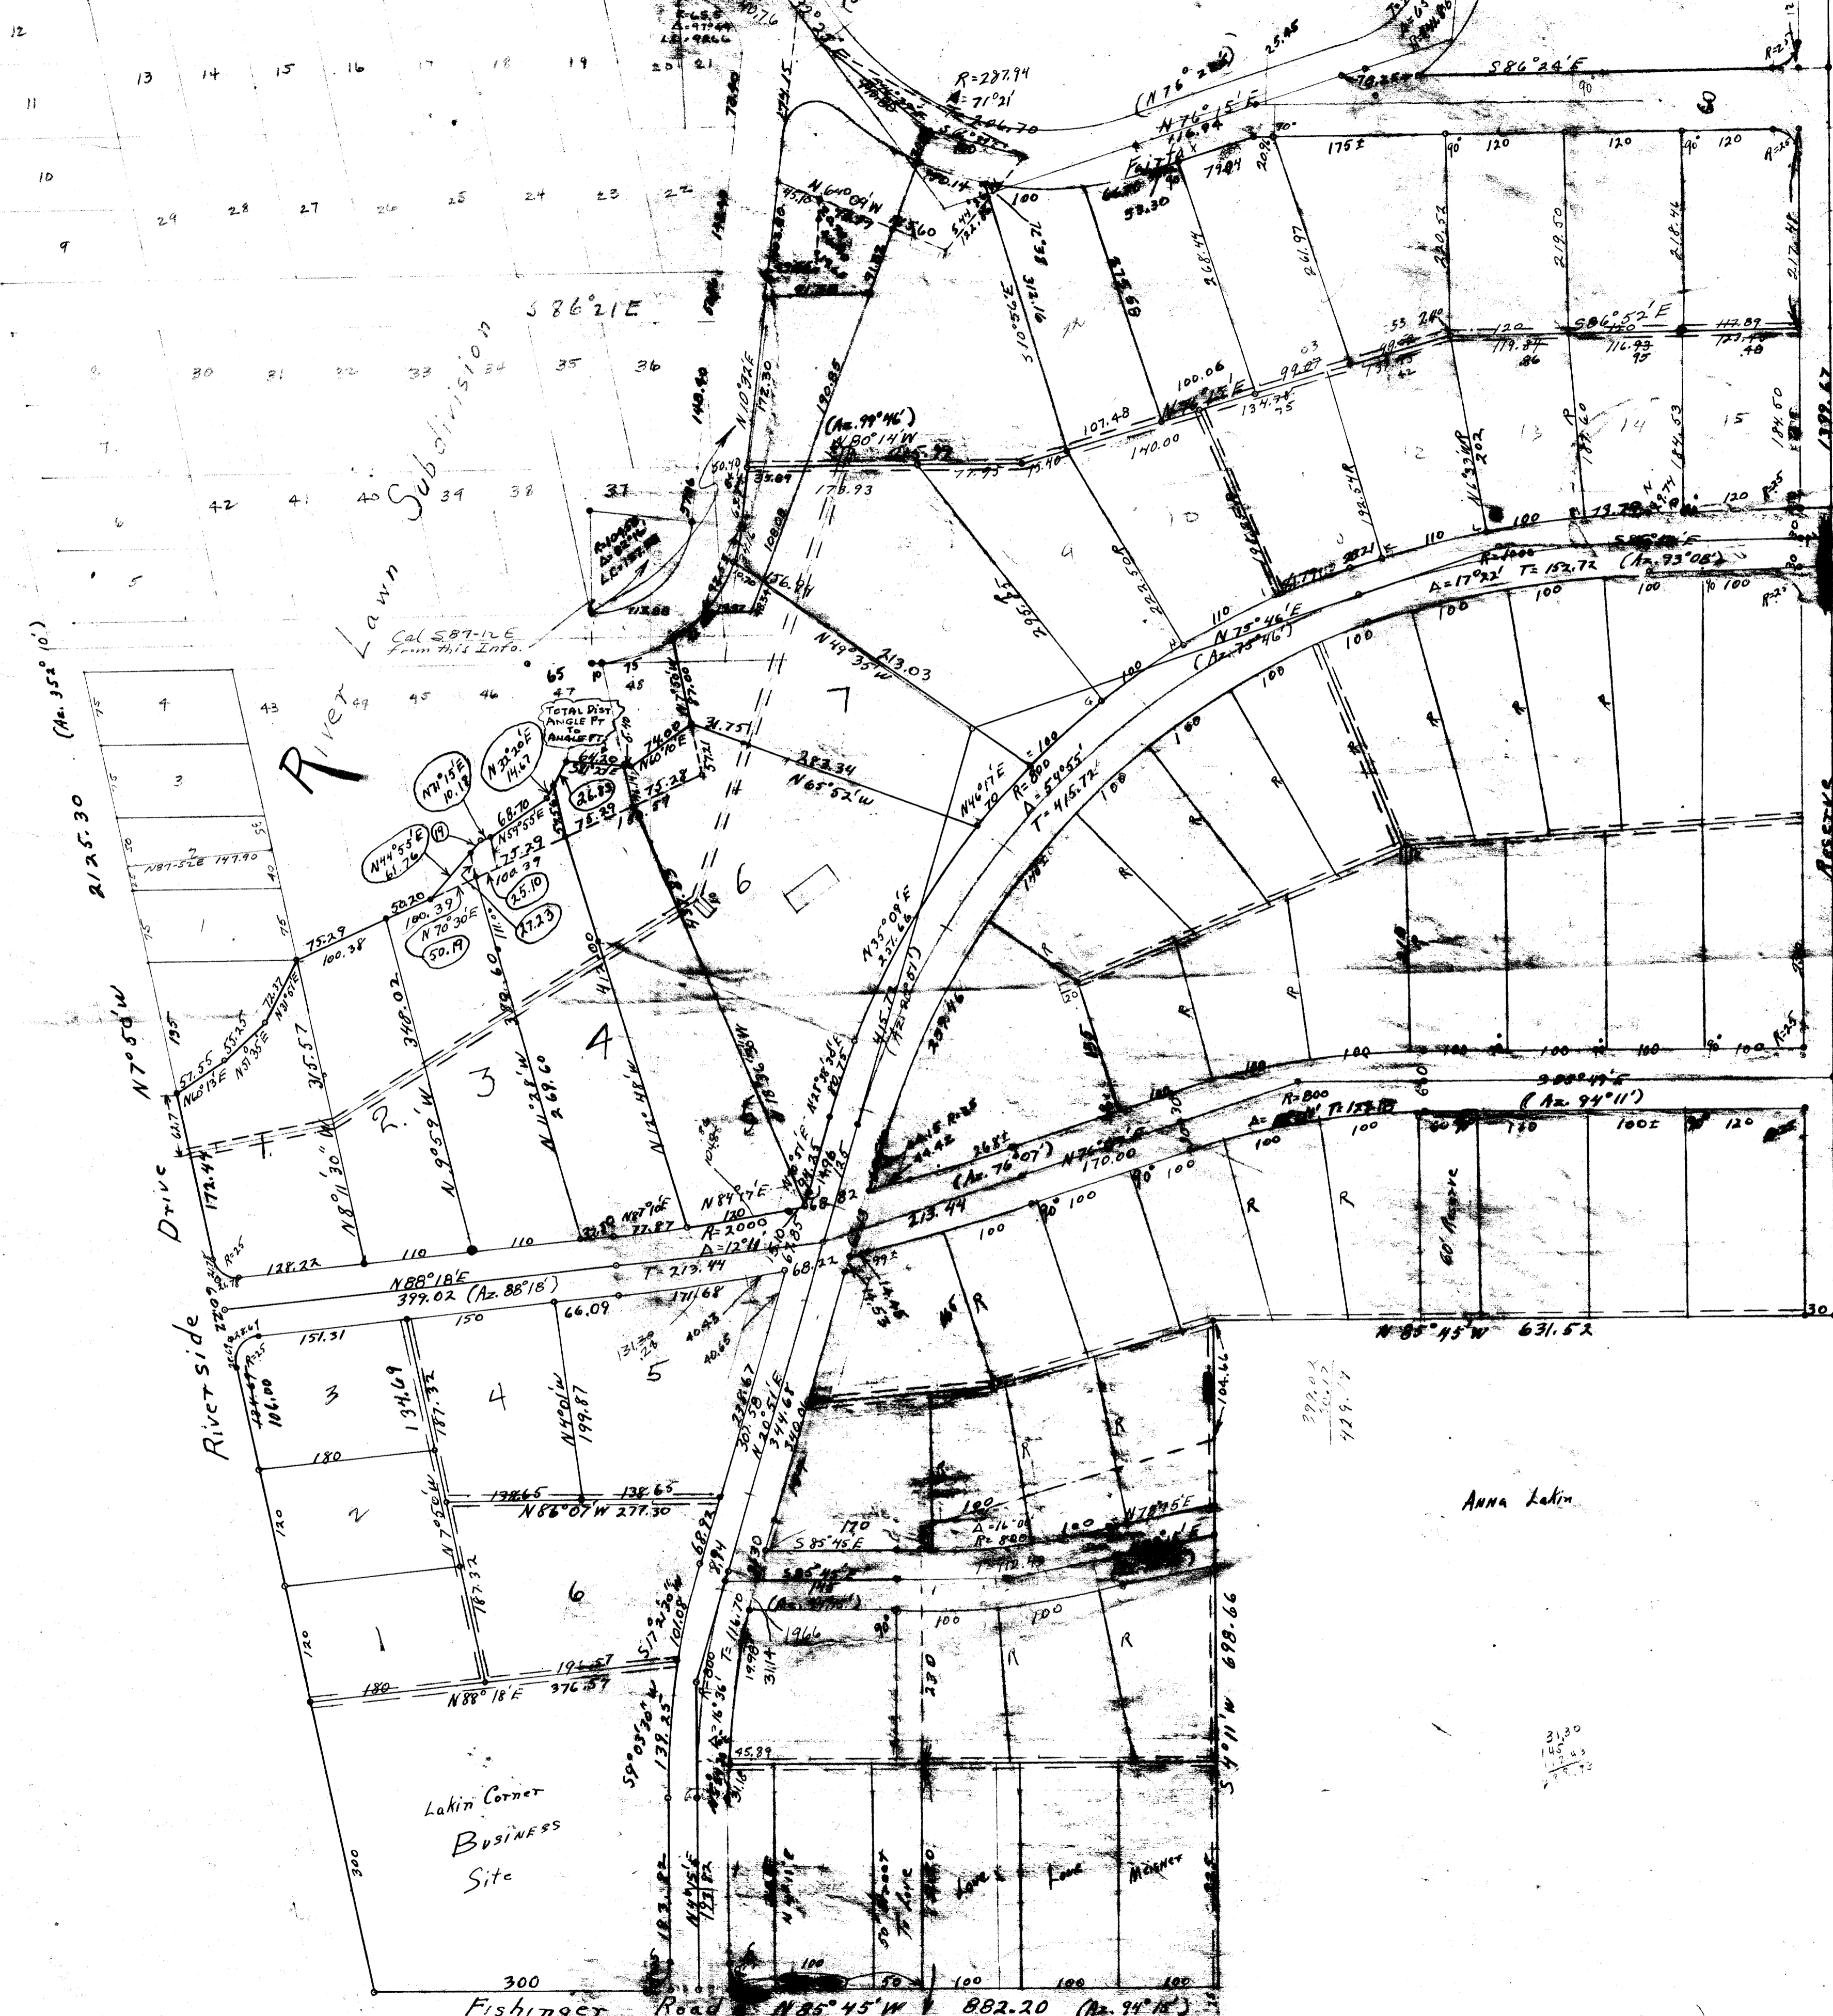

Subdivision  
Cal 587-11E  
from this info.

River  
River side Drive  

TOTAL DIST  
ANGLE PR  

68.70  
N70°55'E  
100.37  
N70°55'E  
50.19  
50.19  

Lakin Corner  
BUSINESS  
Site

ANNA Lakin

Fishinger Road N85°45'W 882.20 (Az. 94°11')

Scale: 100' = 1" Sept. 7, 1949

Frank T. Sawyer