




HB = Hackberry Tree

 

Plat showing partial survey of Lot 1, RIVERSIDE PARK ADDITION, of record in Plat Book 22, Pg. 58, Recorder's Office, Franklin County, Ohio, in the City of Upper Arlington.
 for
 Daniel Cline AIA
 Harry H. Greene
 Sept. 4, 1981
 Scale 1" = 10'