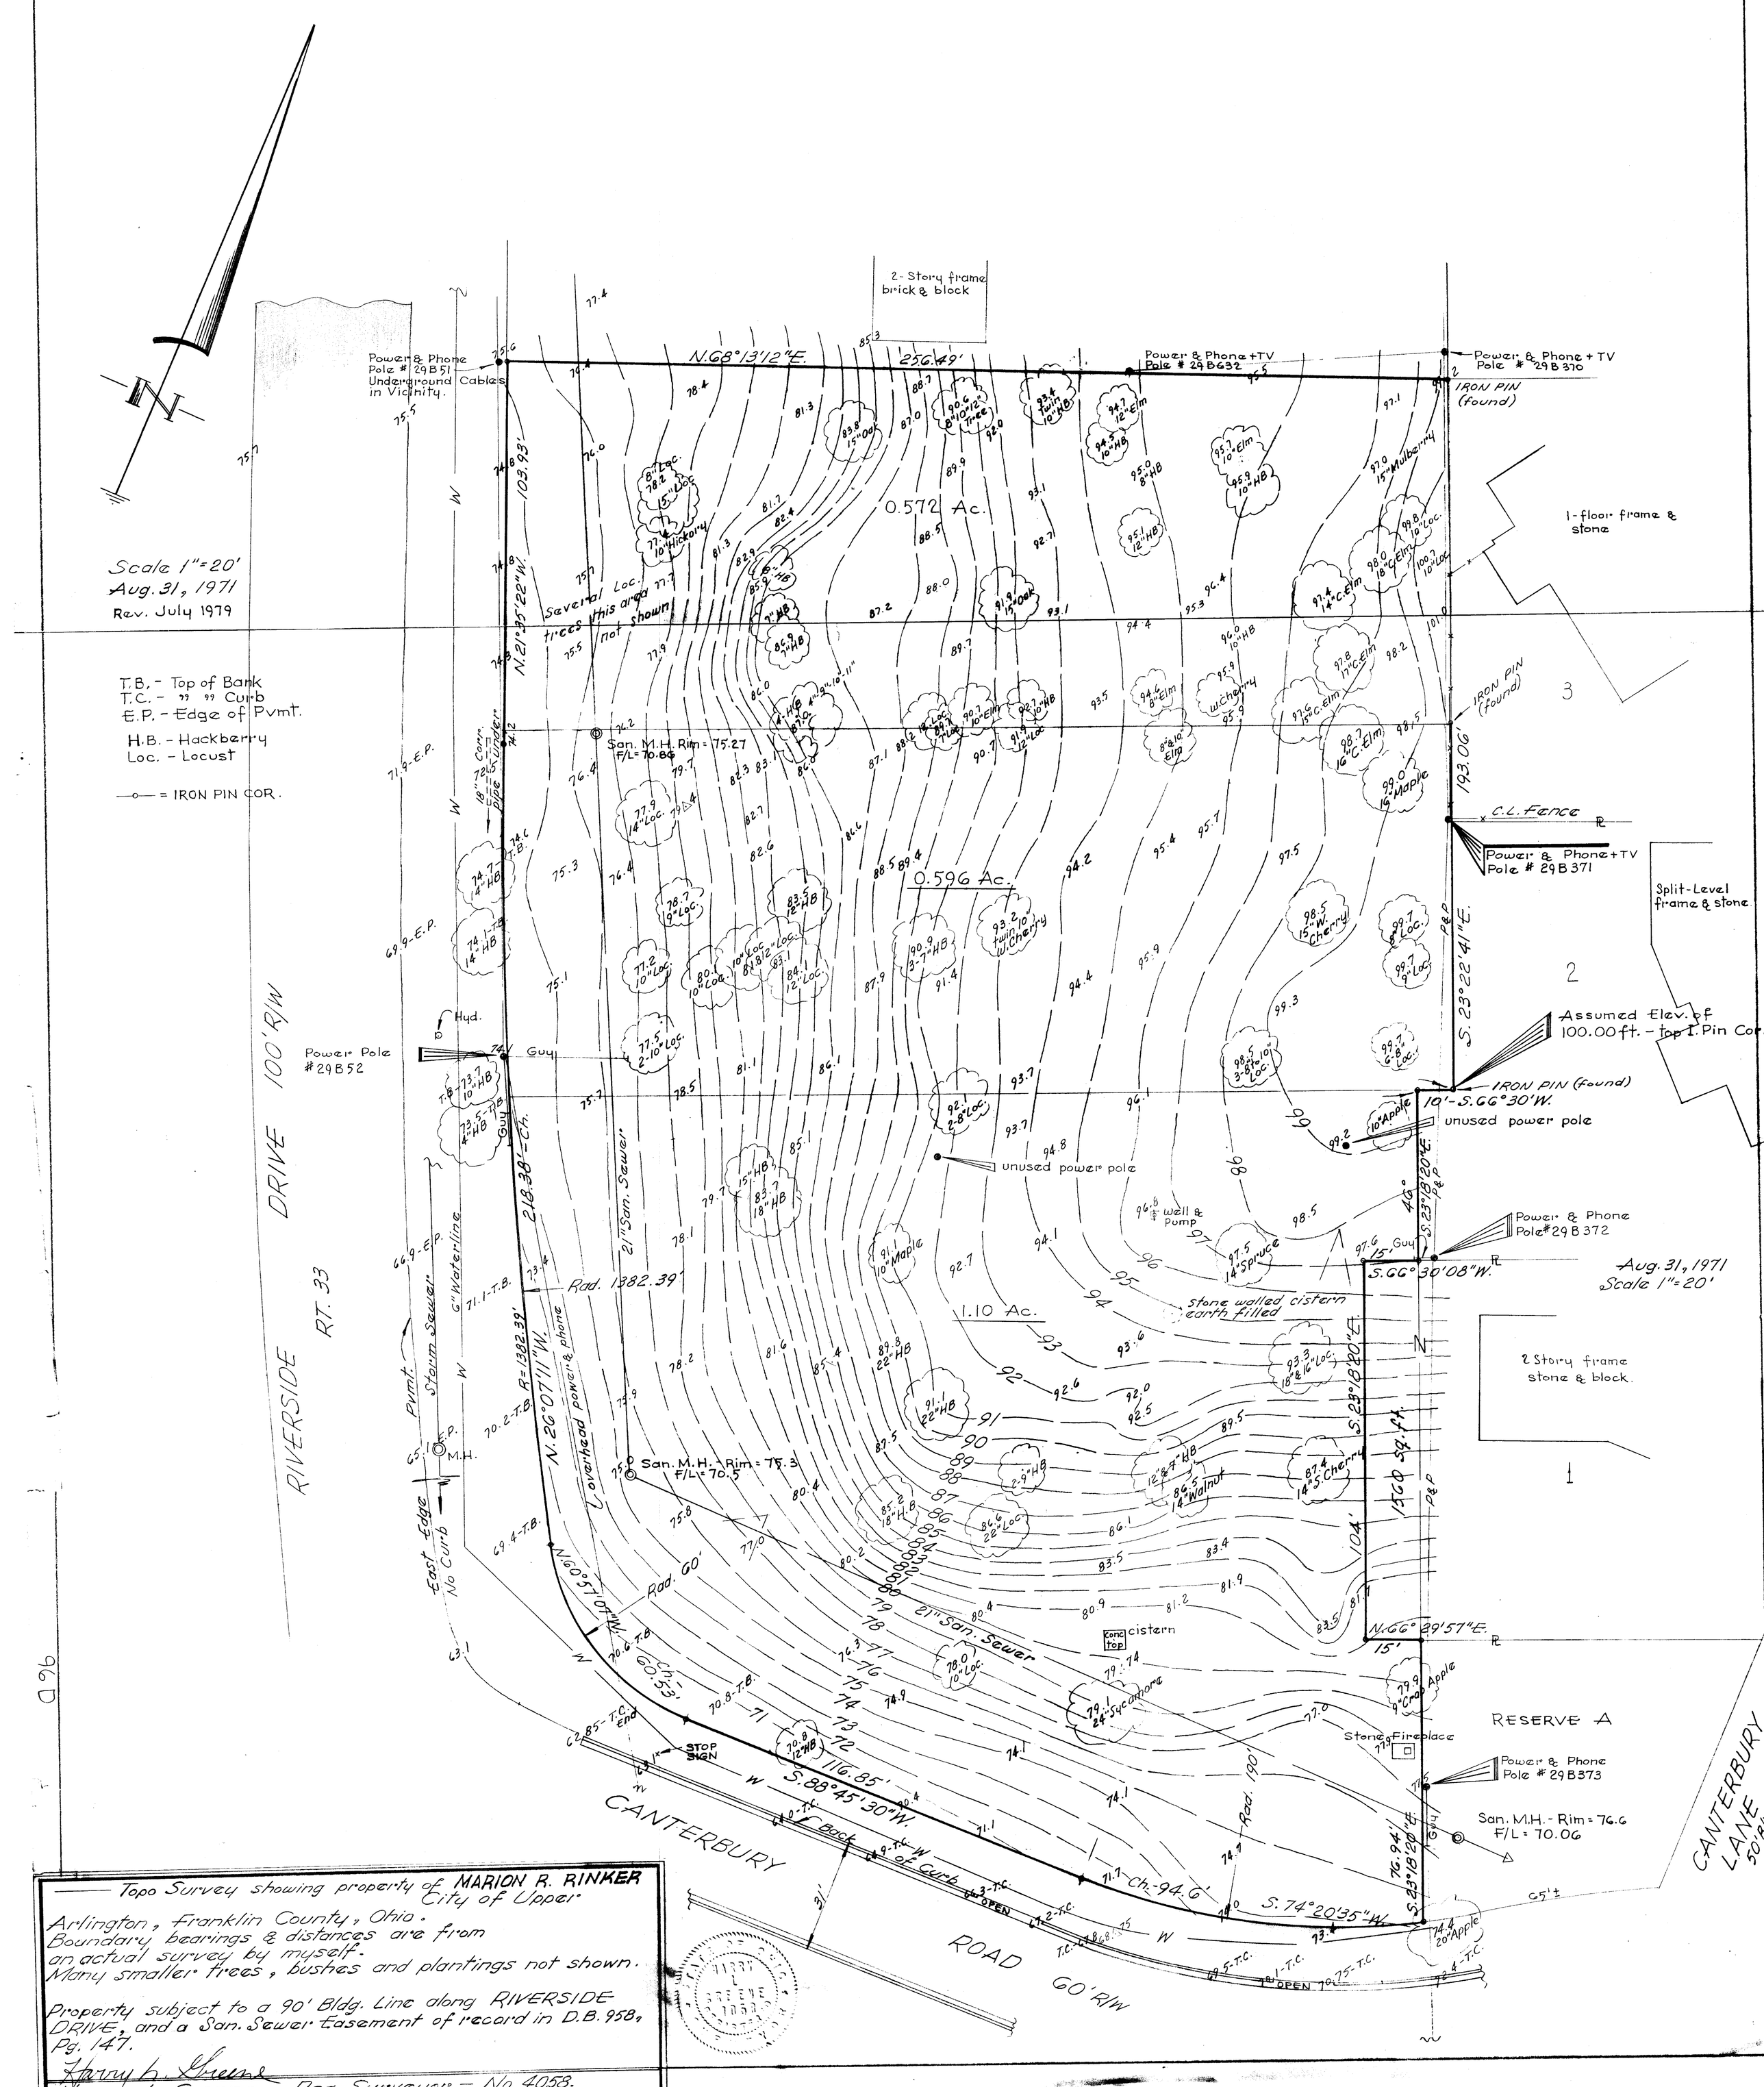

Topo Survey showing property of MARION R. RINKER City of Upper Arlington, Franklin County, Ohio.
Boundary bearings & distances are from an actual survey by myself.
Many smaller trees, bushes and plantings not shown.

Property subject to a 90' Bldg. Line along RIVERSIDE DRIVE, and a San. Sewer Easement of record in D.B. 958, Pg. 147.

Harry L. Greene

Harry L. Greene, Reg. Surveyor - No. 4058.

D 96