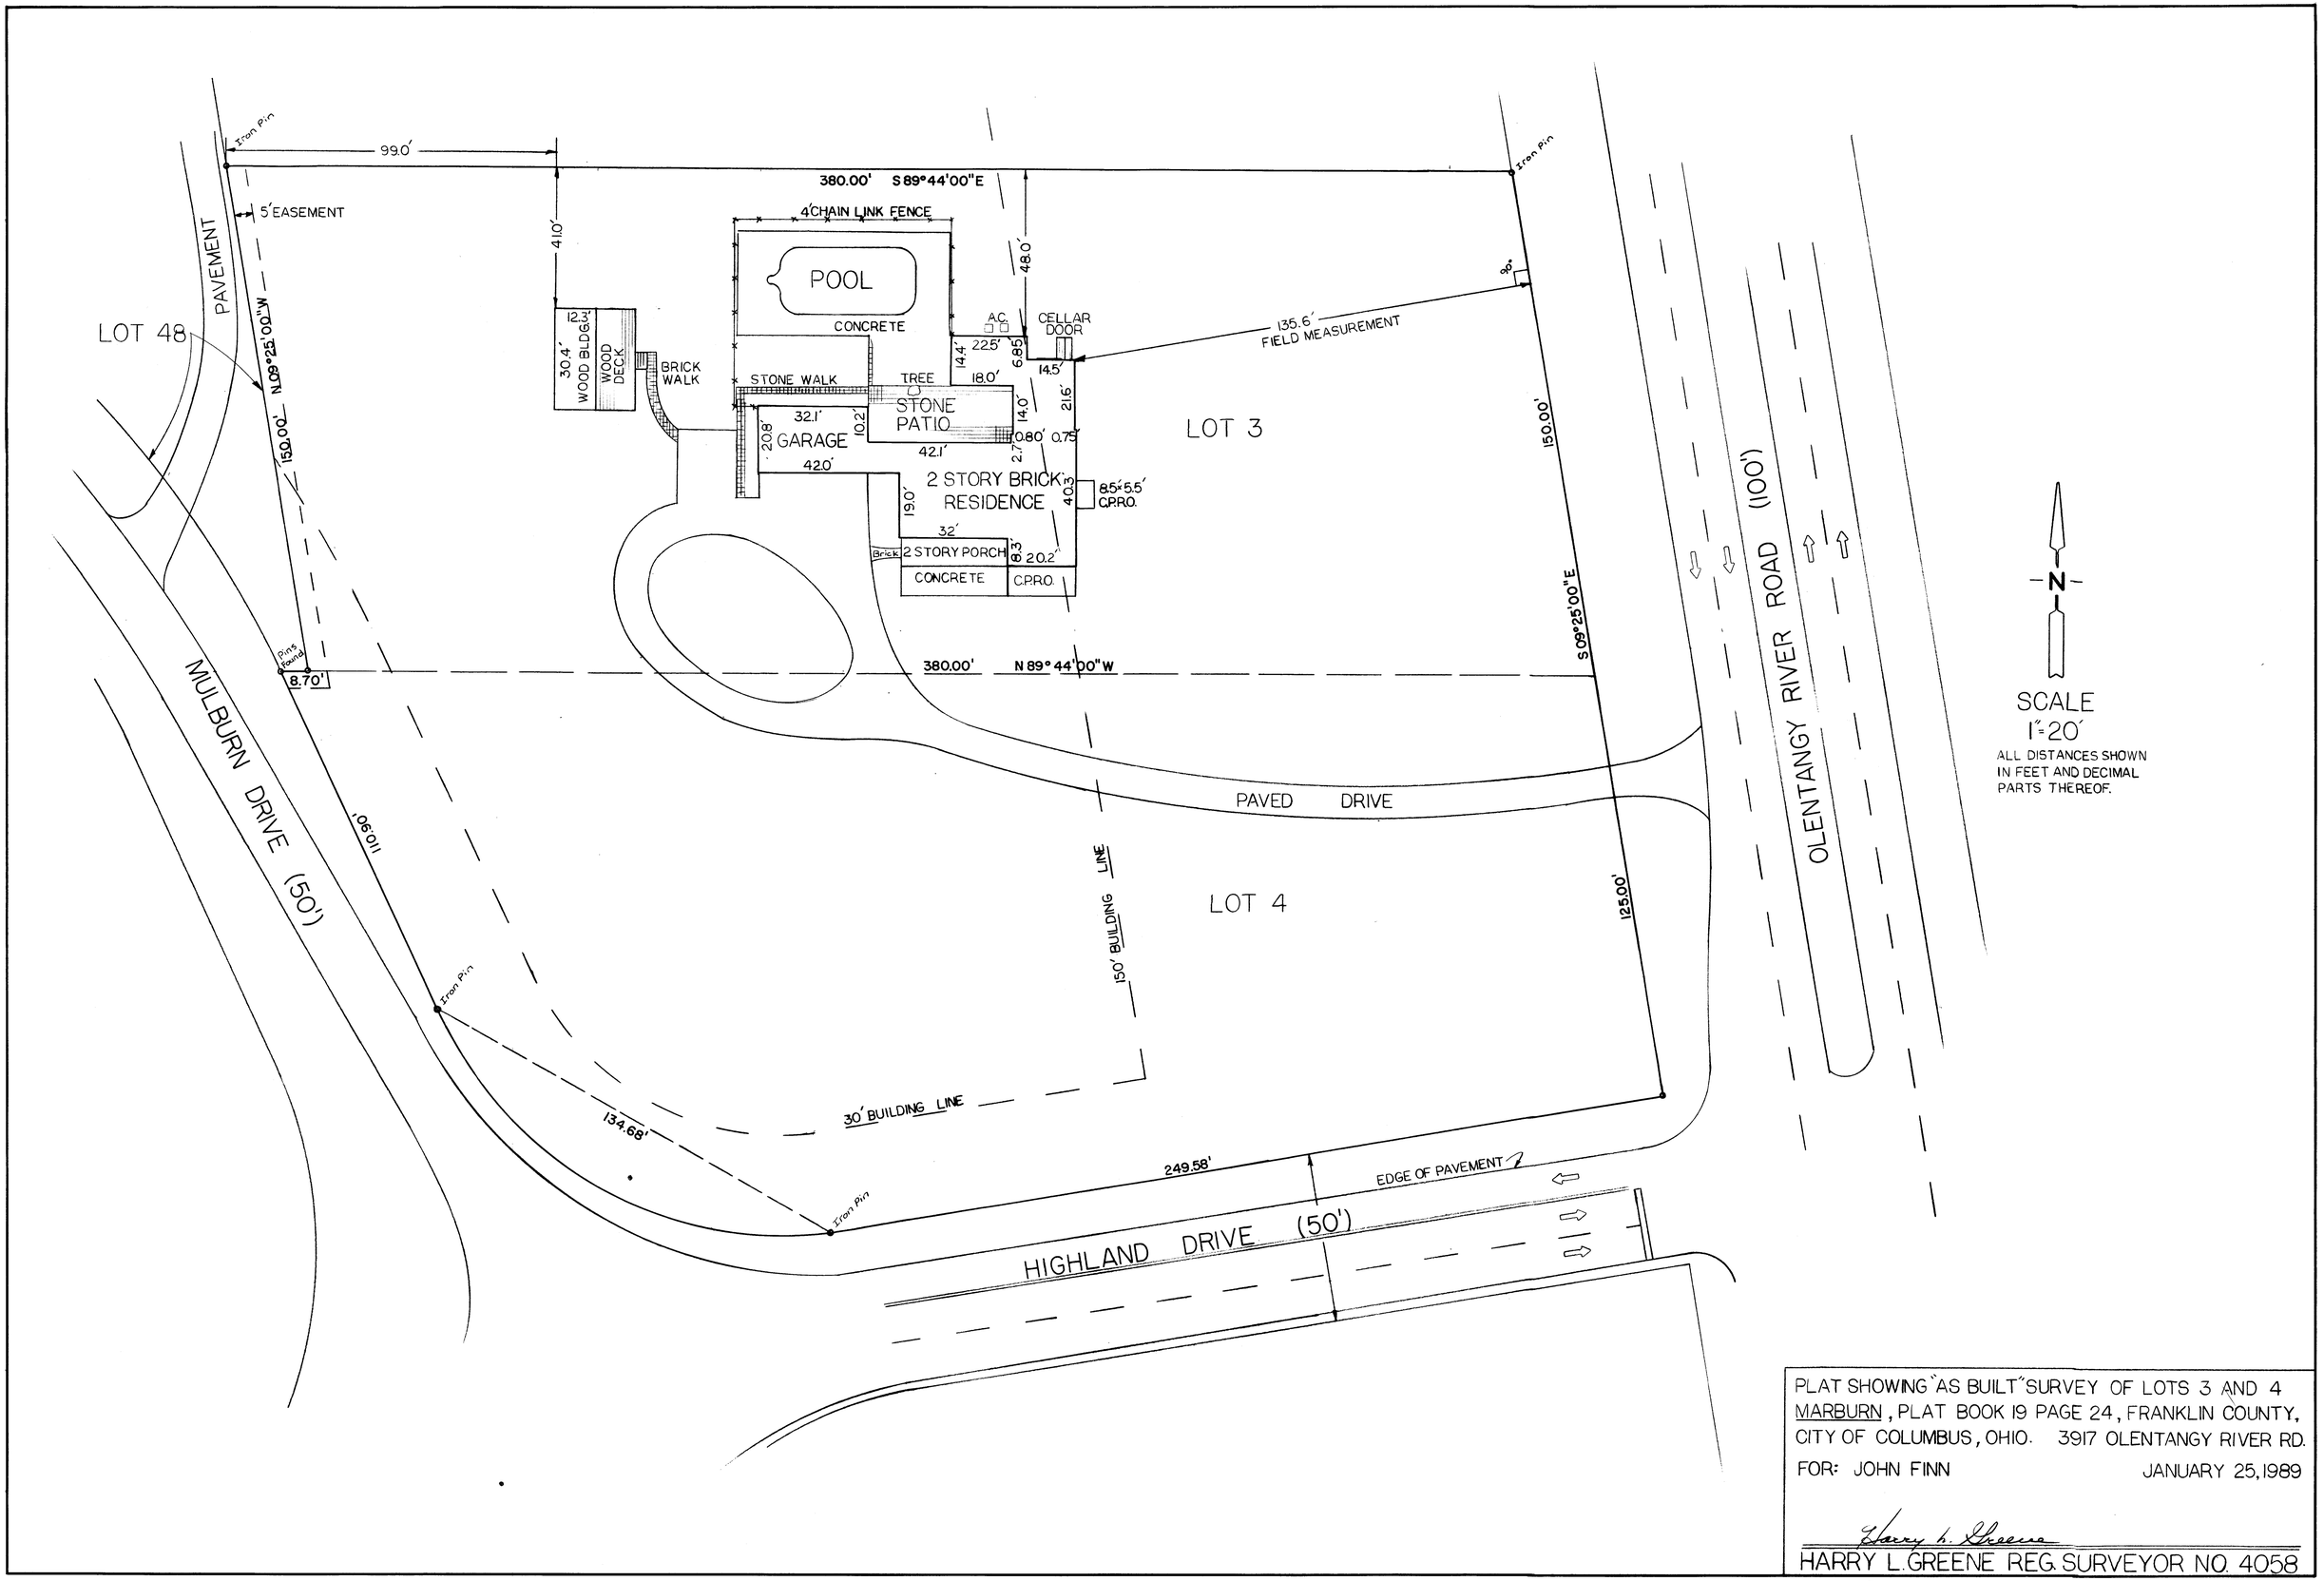

PLAT SHOWING "AS BUILT" SURVEY OF LOTS 3 AND 4
MARBURN, PLAT BOOK 19 PAGE 24, FRANKLIN COUNTY,
CITY OF COLUMBUS, OHIO. 3917 OLENTANGY RIVER RD.

FOR: JOHN FINN JANUARY 25, 1989

Harry L. Greene

HARRY L. GREENE REG. SURVEYOR NO. 4058

91 Q