

H.S. & E.R. Lynn
87.56 Ac.

N. 72° 22' 00" E.

1344.32'

Stone

1879.83'

N. 18° 46' 57" W.

S. 19° 44' 38" E.

1402.61'

H.S. Clarkson &
Link L. Davis
146.065 Ac.

John H. Fisher, Jr.
D.B. 2969, Pg. 131
(56.99 Ac. deed, one Exception of
2.137 Ac.) less 1.308 Ac. to Robin L. Fisher,
Net remaining 54.0427 Ac. - This survey.

M.W. & F.M. Rings
55.564 Ac.

Mary L.
Heimbush
0.356 Ac.

S. 69° 00' 00" W.

200'

470.37' S. 12° 50' 00" E.

R.D. & J.P.
Palmer
2.137 Ac.
D.B. 2837,
Pg. 351

N. 12° 50' 00" W.
245.37'

S. 69° 00' 00" W.

240'

Robin L. Fisher
1.308 Ac.
D.B. 3562, Pg. 841

222.72' N. 21° 00' 00" W.

W.H. & V.L.
Schneider
1.714 Ac.

399.65' S. 20° 15' 30" E.

396.91' S. 69° 20' 51" W.

HAYDEN RUN ROAD

200'


271.96'

509.96' S. 69° 00' 00" W.

90'

June 1977
Scale 1" = 100'
—○— = Iron Pin or Spike

Survey of 54.0427 Ac., being a part of Survey 2418,
Virginia Military District, Washington Township,
Franklin County, Ohio.

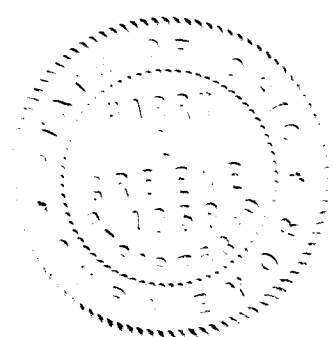

Harry L. Greene
Harry L. Greene, Reg. Surveyor - 4058.