

City of Upper Arlington
Board of Education
0.876 Ac. D.B. 2320, Pg. 578

City of Upper Arlington
Board of Education
1.163 Ac. D.B. 2249, Pg. 92



1.163 Ac. Original 15.814 Ac.
D.B. 2042, Pg. 29

City of Upper Arlington
1.168 Ac. D.B. 2250, Pg. 185

MOUNTVIEW ROAD

MANCHESTER PLACE ADDITION

11
10
9
8
7
6
5

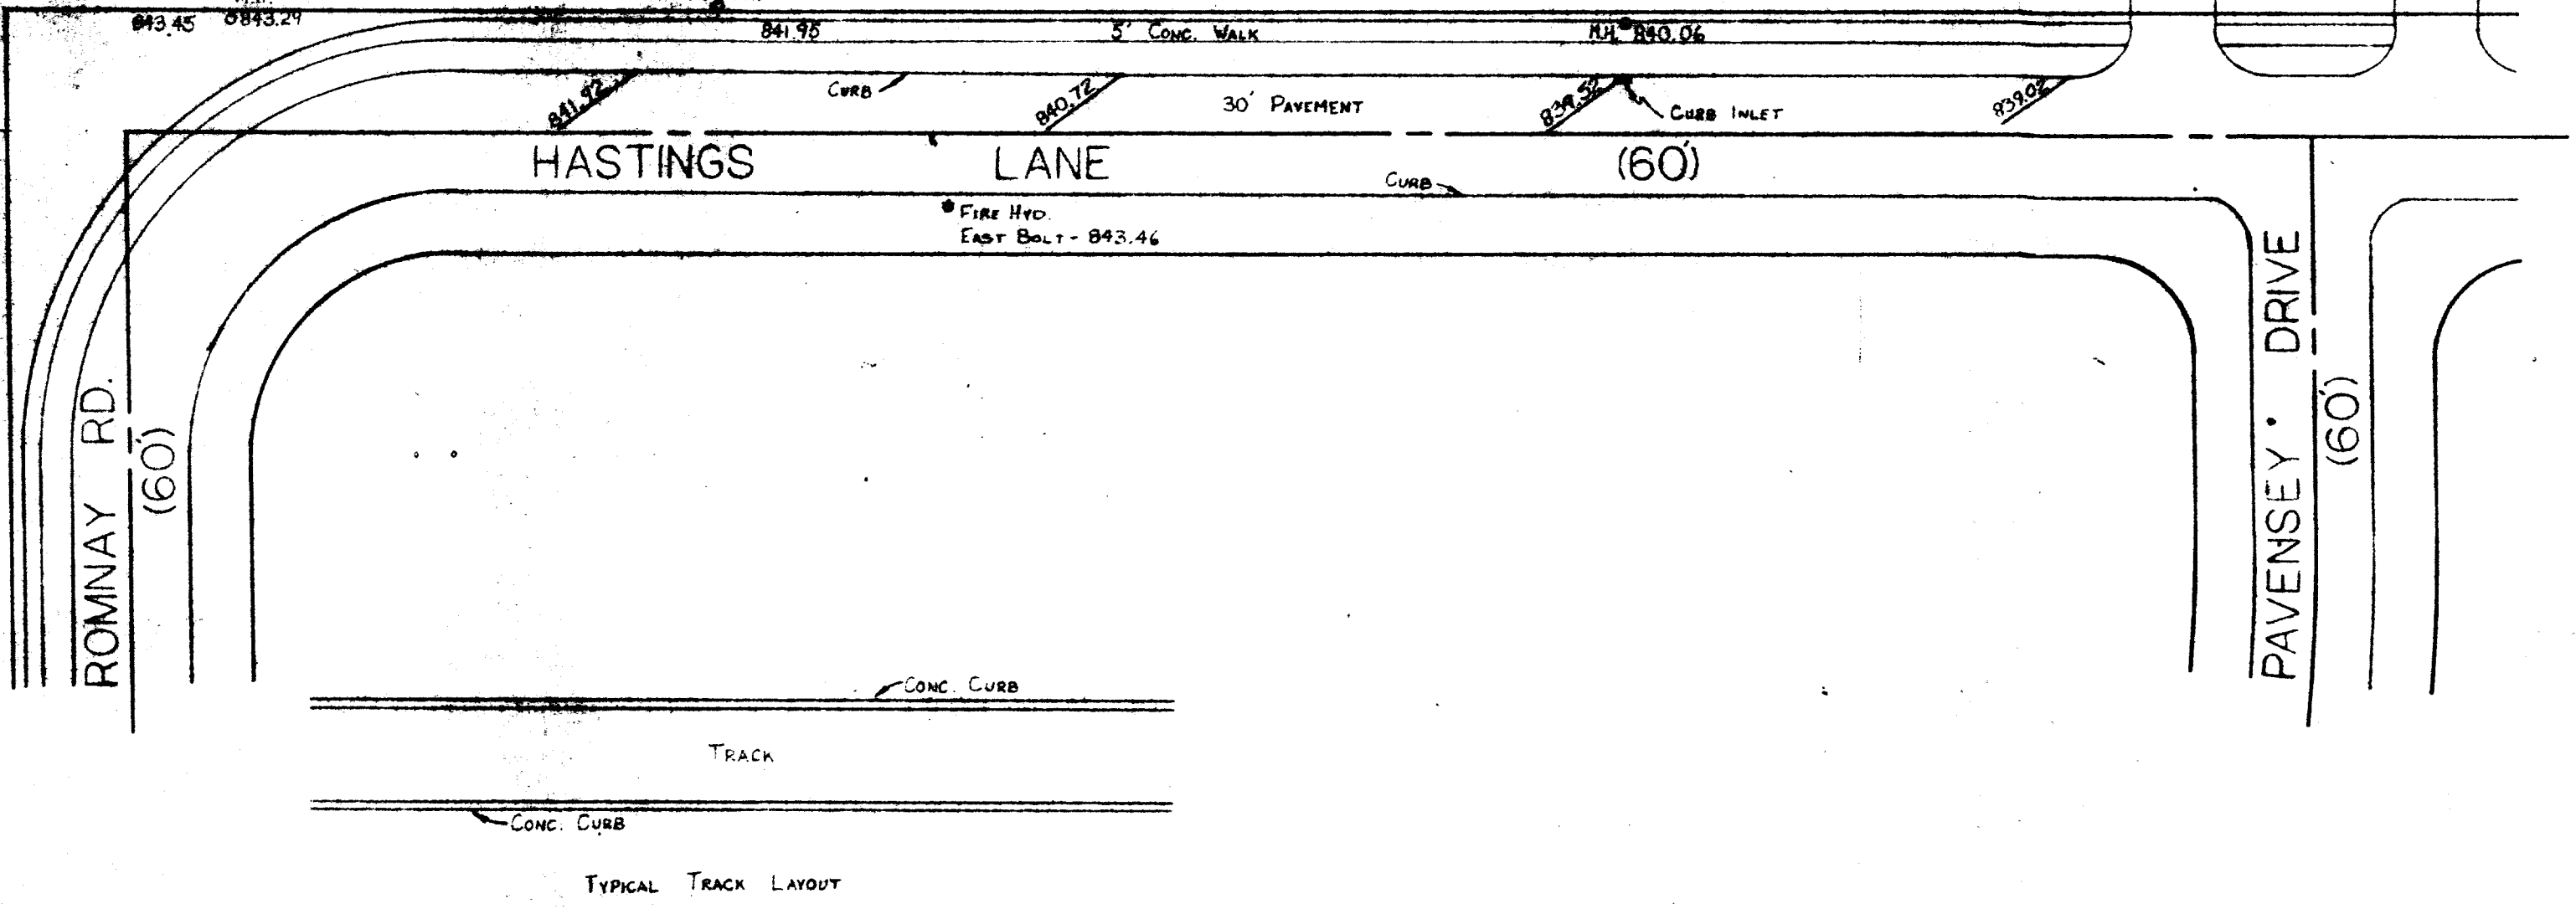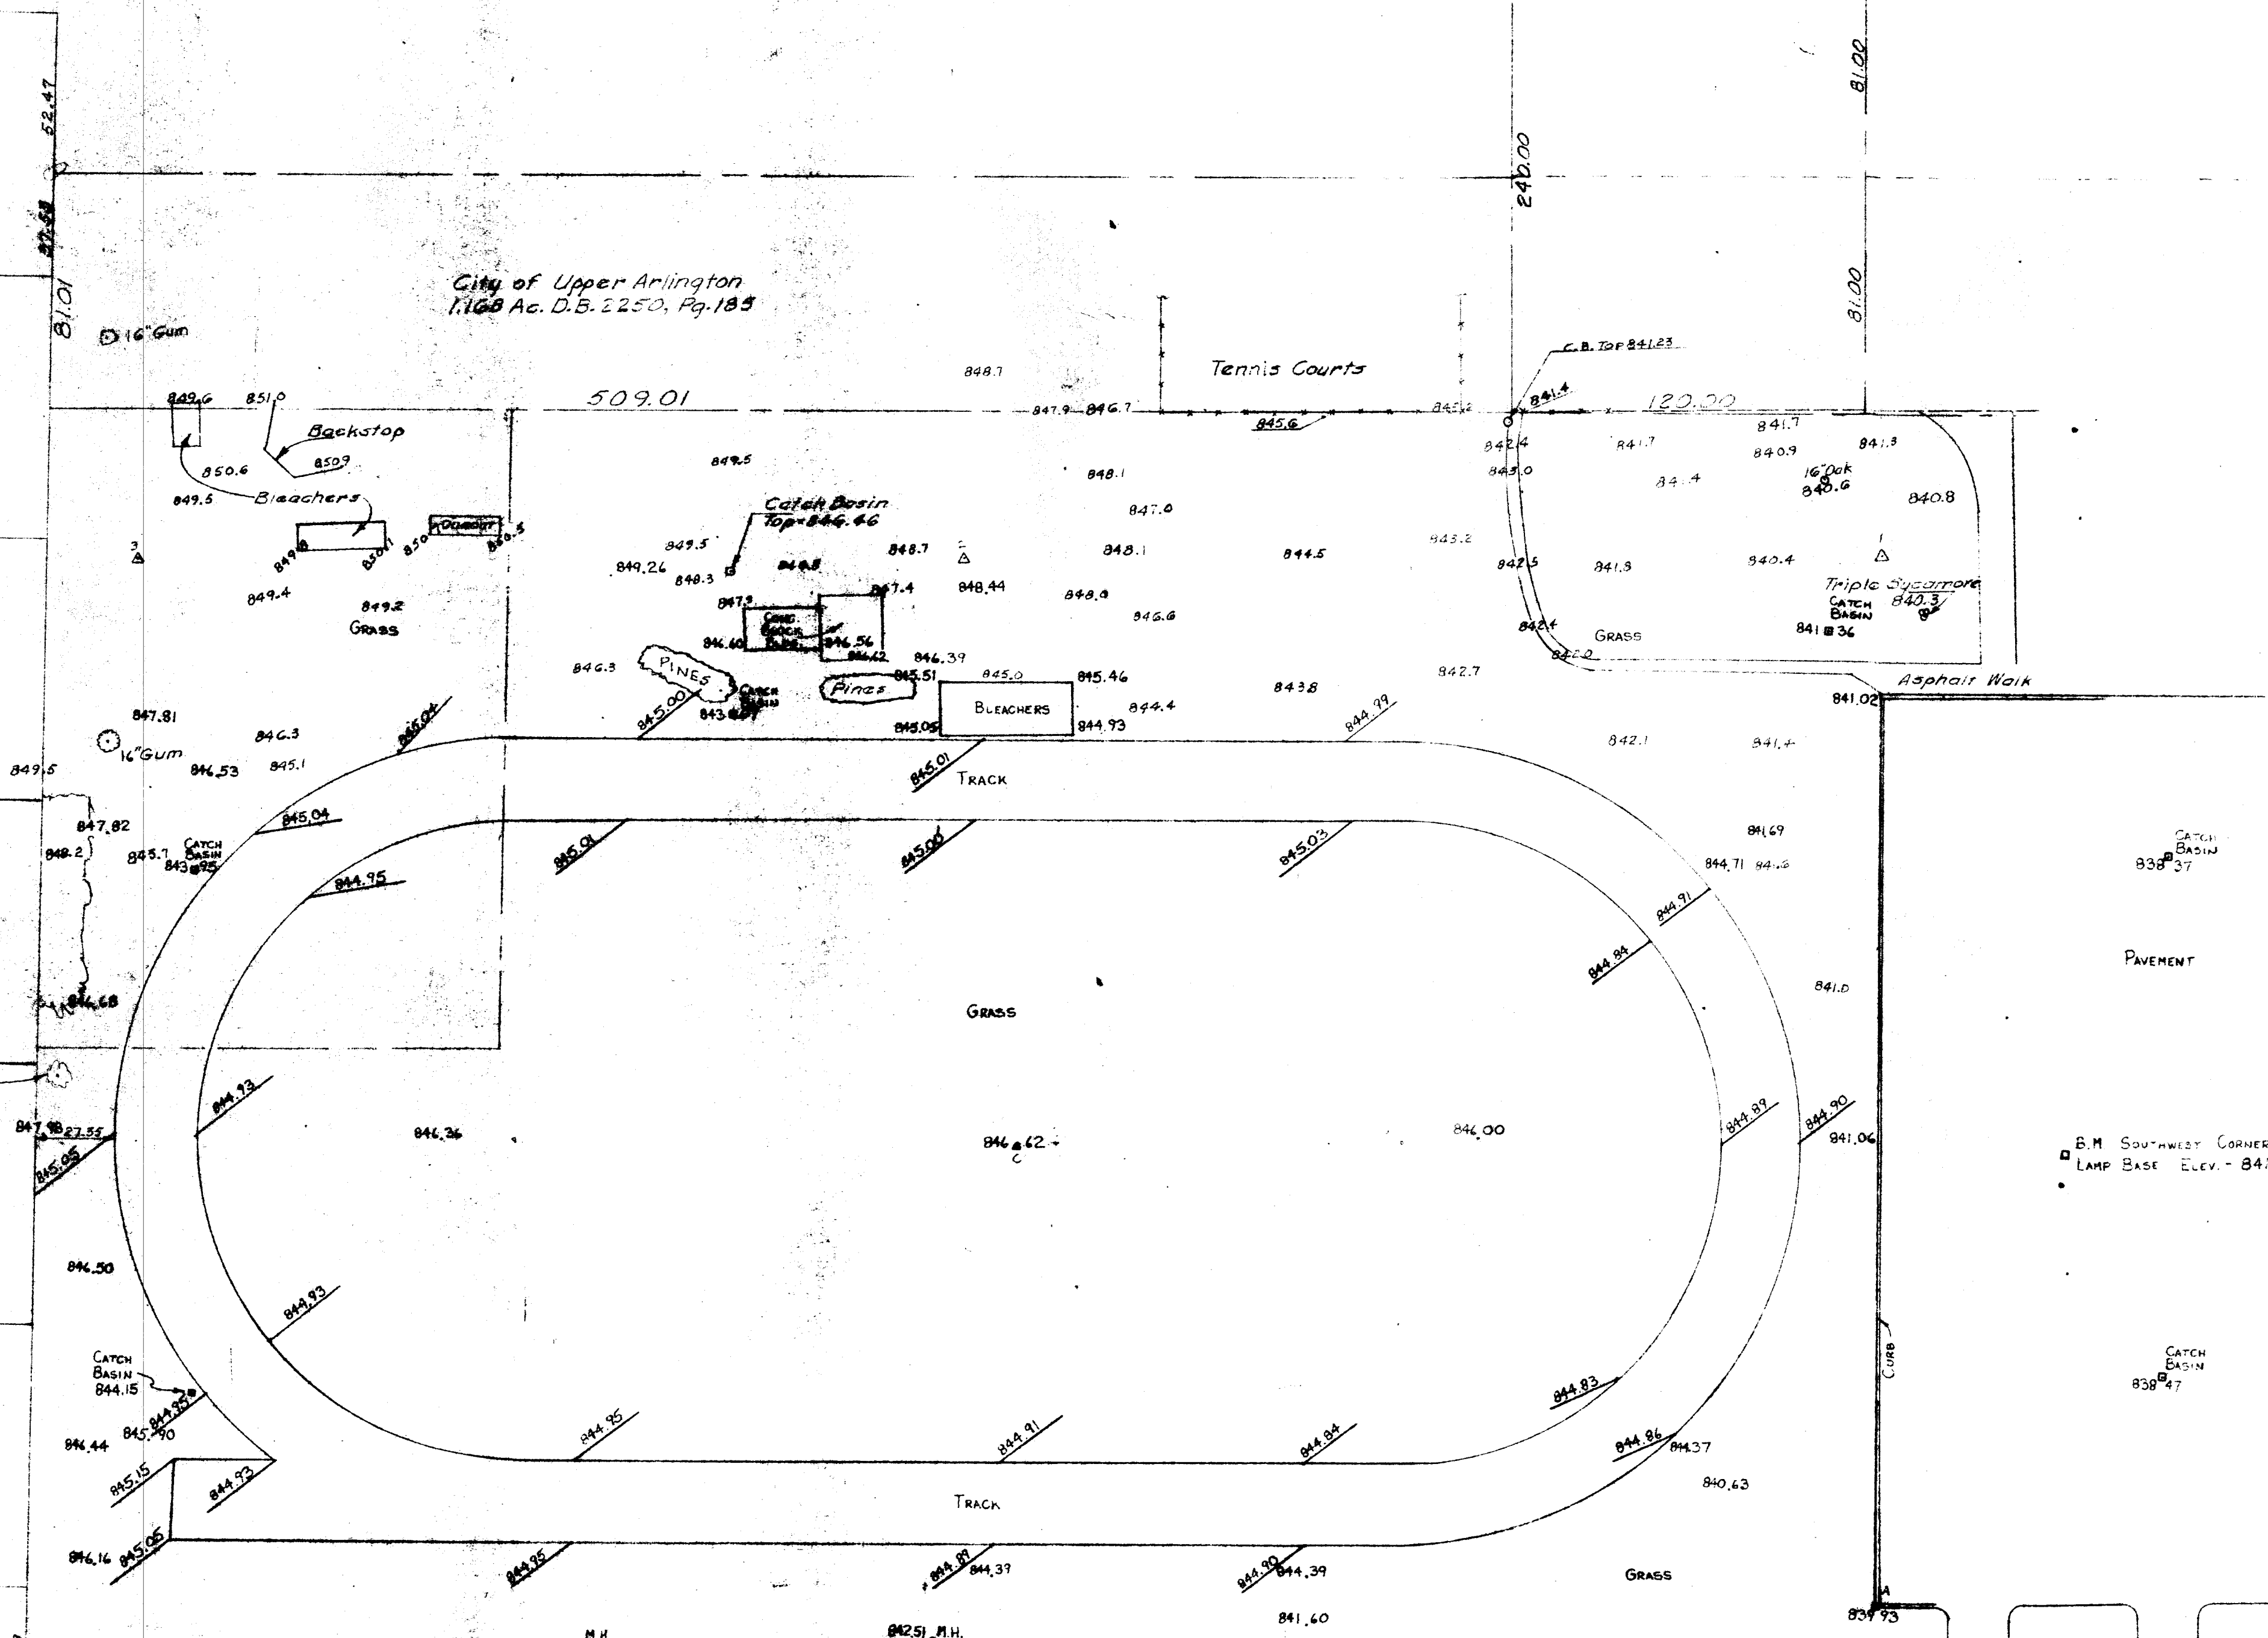

PLAT SHOWING TOPO OF THE TRACK AND FIELD AREA AT THE HASTINGS JUNIOR HIGH SCHOOL, CITY OF UPPER ARLINGTON, FRANKLIN COUNTY, OHIO.

SCALE: 1" = 40'
MARCH 31, 1987
Revised March 26, 1992

CURRY WILLIS & GROVE, INC.
Engineers and Surveyors
2160 Tremont Center Columbus Ohio 43221

Harry L. Greene
HARRY L. GREENE, REG. SURVEYOR - NO. 4058