EXHIBIT A

GRANT-OAK CONDOMINIUM

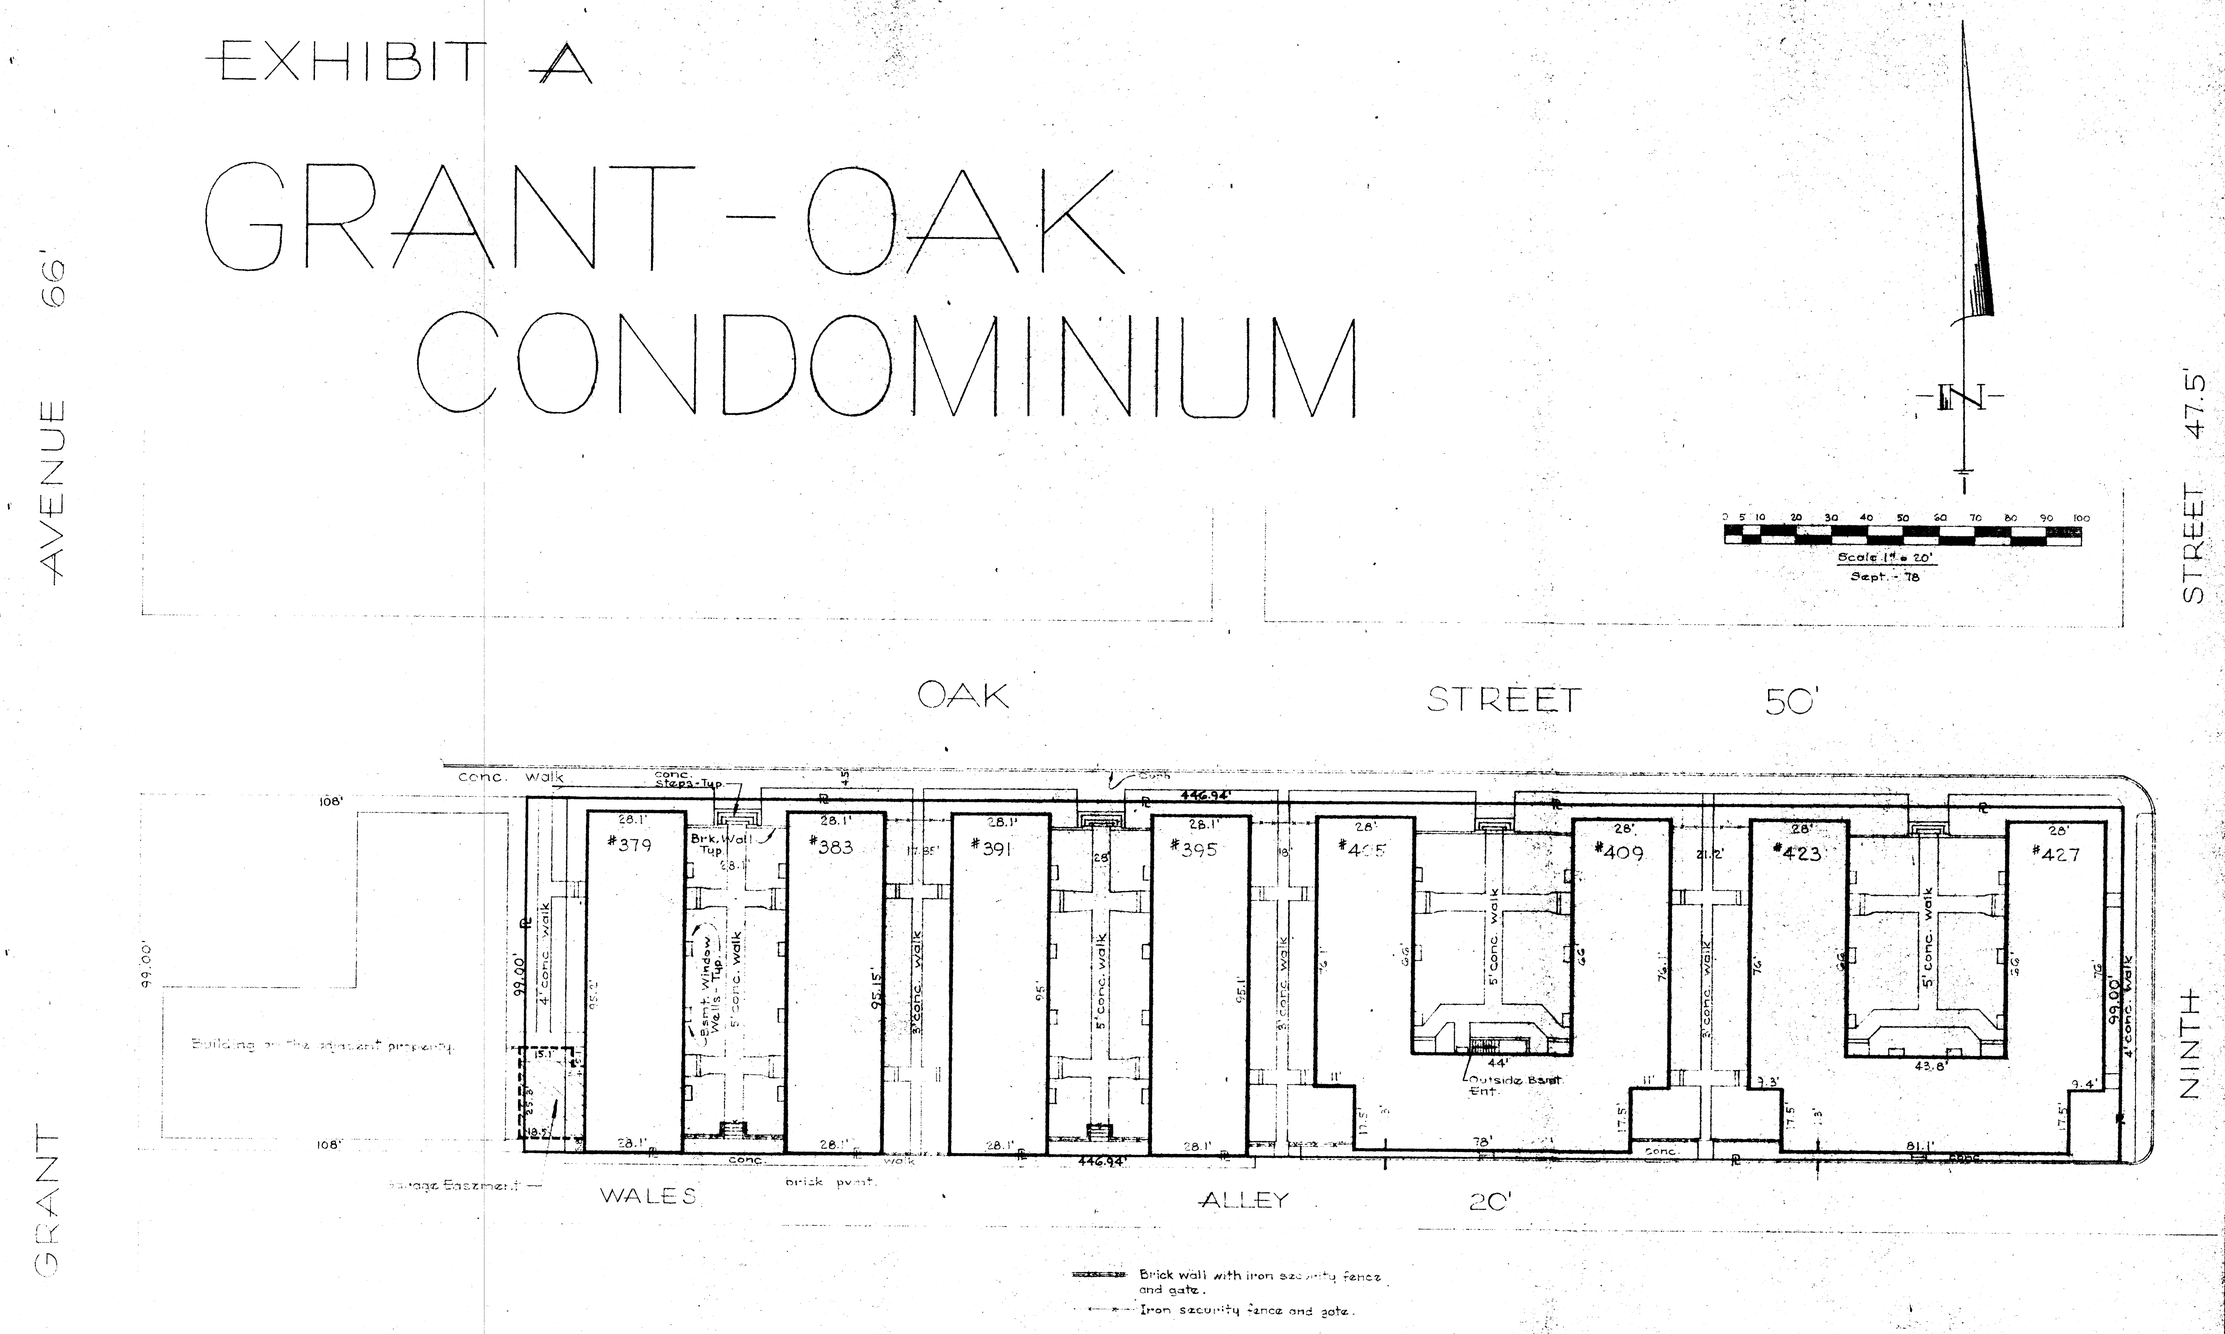

I hereby certify that this drawing accurately shows the buildings and other improvements as located and as constructed at GRANT-OAK CONDOMINIUM, and that there are no encroachments on any abutting premises.

Use This

Harry L. Greene

Harry L. Greene, Reg. Surveyor - 4058.

No.	DATE	BY	REVISIONS

PRELIM. FINAL AS BLT.

PRELIMINARY
BIDDING
CONSTRUCTION

PLAN NO.