


OSCAR L. THOMAS CO. 2.590 ACRES D.B. 2899 P. 219

N 40° 41' 22" W 287.69'
10' EASEMENT D.B. 3488 Pg. 910
25' INGRESS - EGRESS & UTILITY EASEMENT D.B. 3307 Pg. 671
5' EASEMENT D.B. 3402 Pg. 25

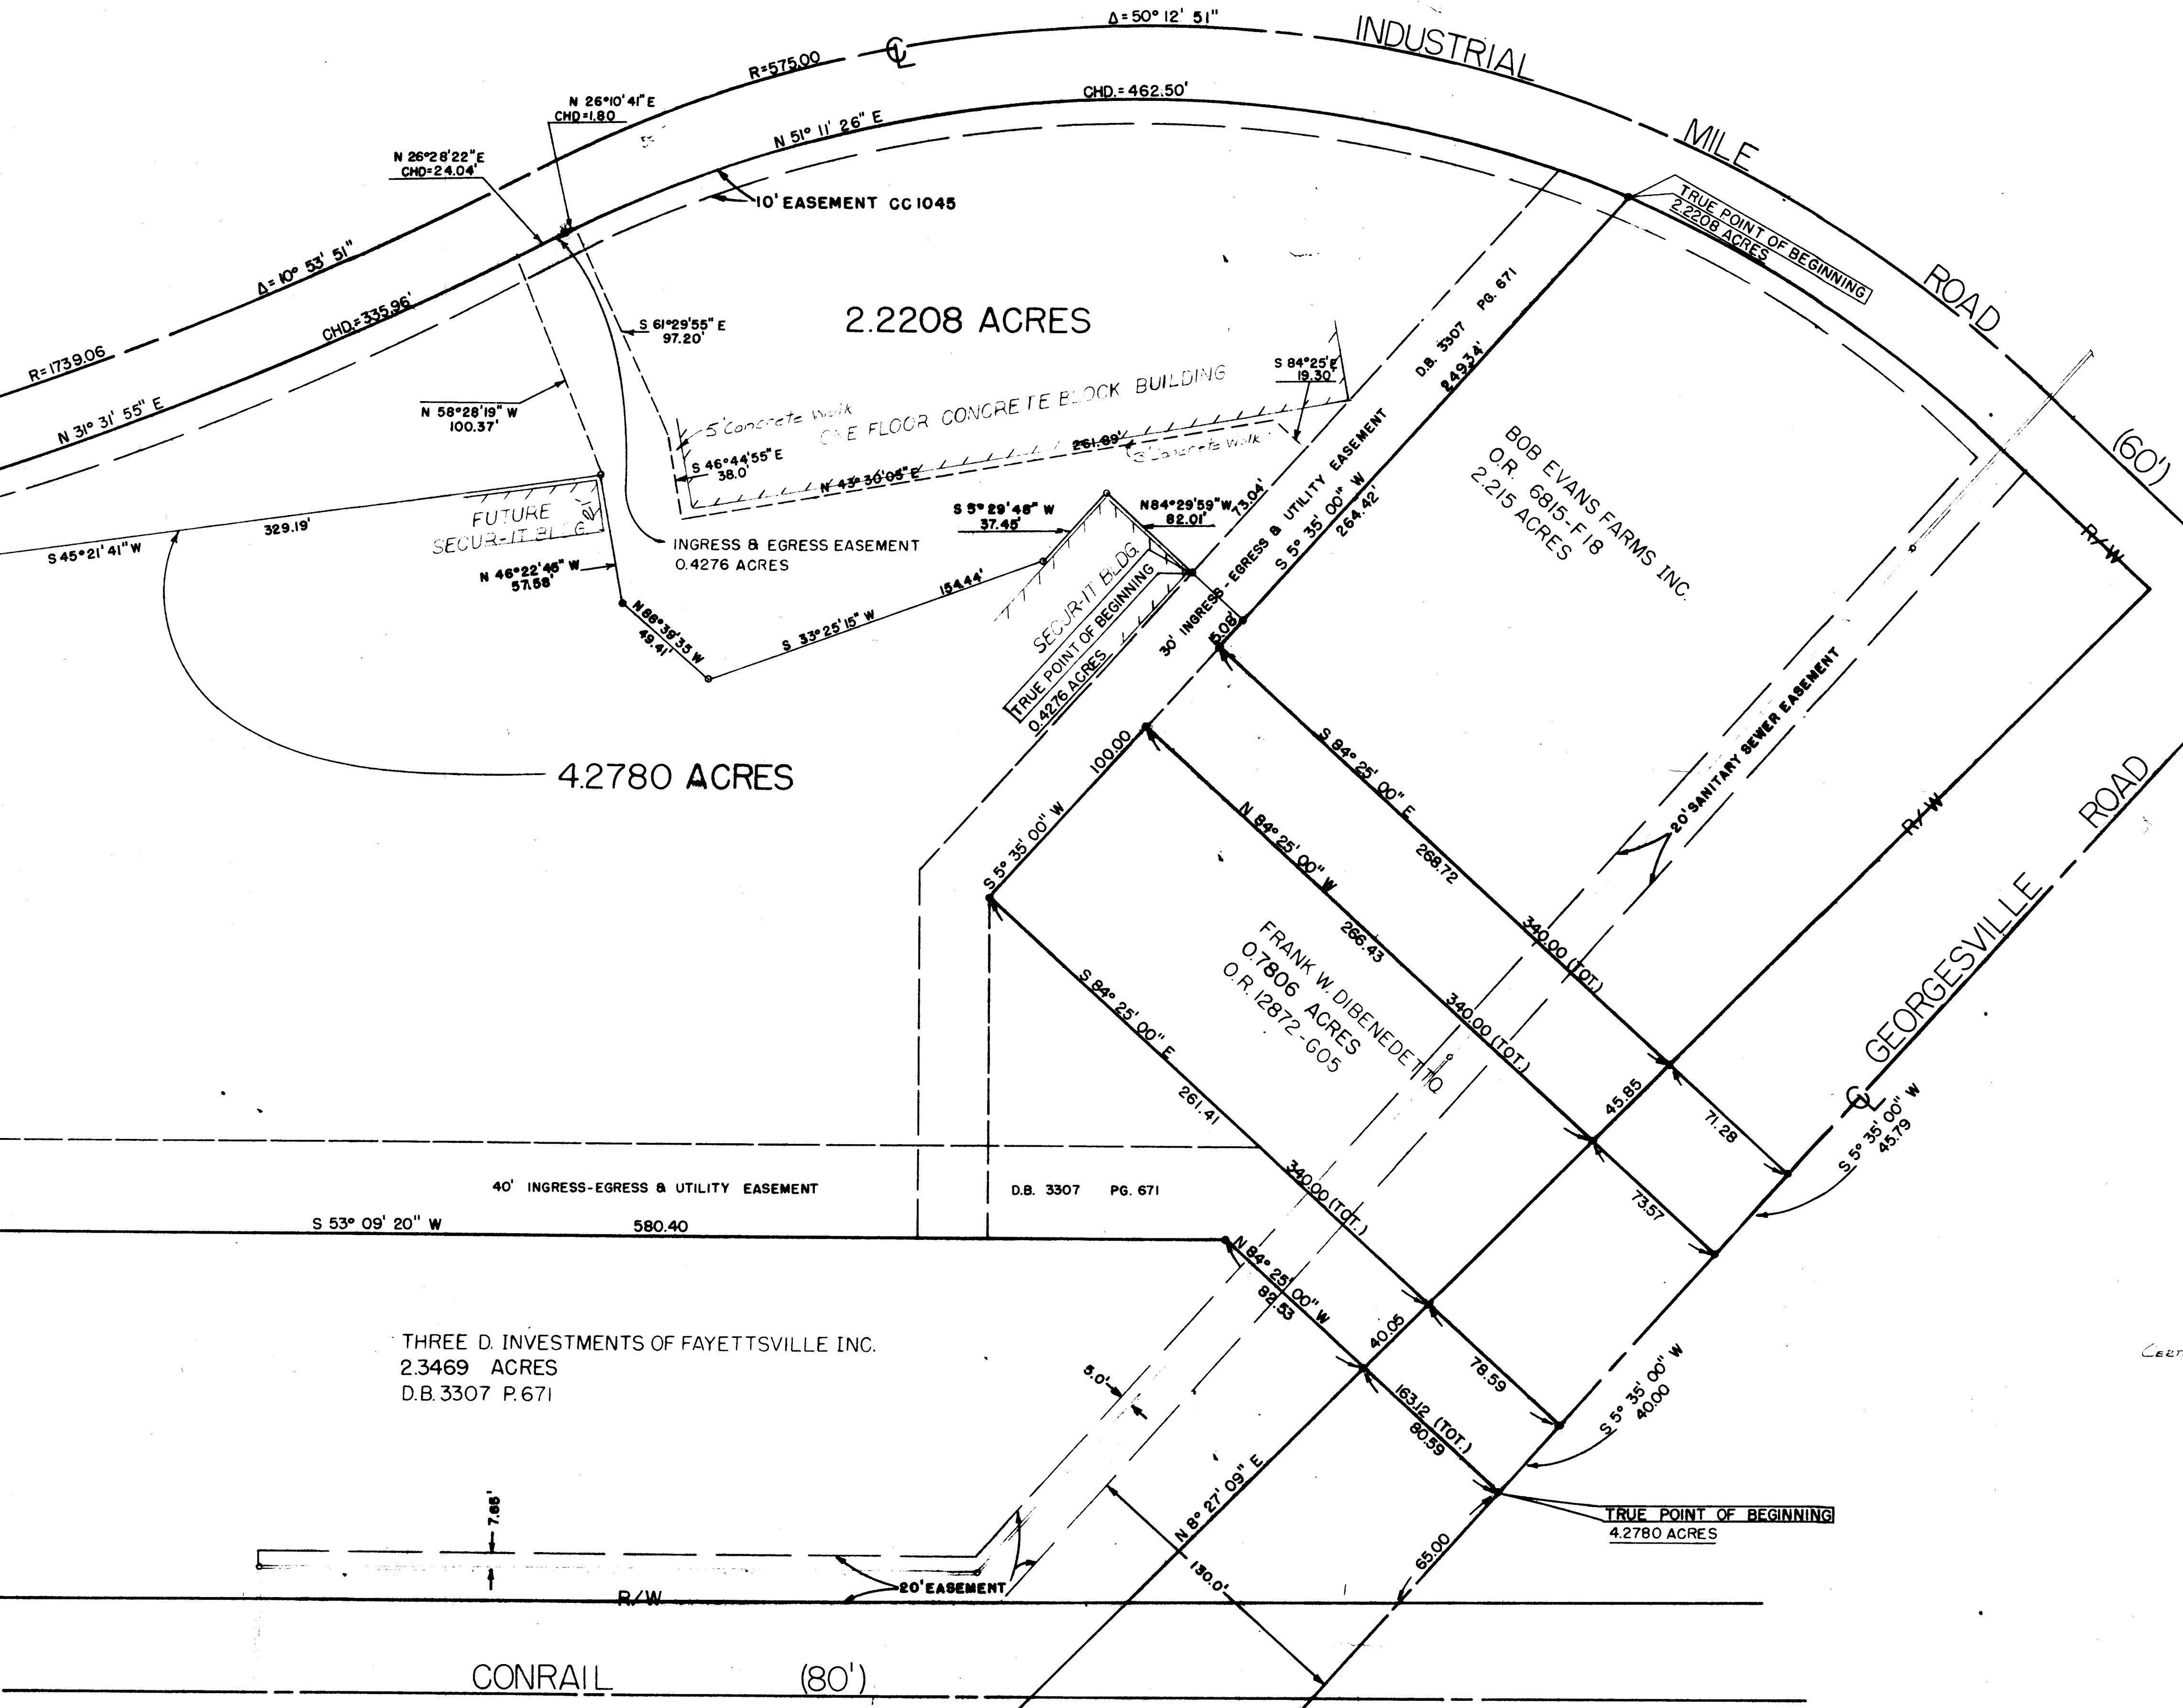

THREE D. INVESTMENTS OF FAYETTSVILLE INC.
2.3469 ACRES
D.B. 3307 P. 671

CERTIFIABLE TO: GEORGESVILLE STORAGE ASSOCIATES
STATE SAVINGS BANK, AND THE OHIO BAR TITLE INSURANCE CO.
Re: 6.4987 ACRES SITUATED IN FRANKLIN COUNTY, OHIO.

I hereby certify the above plat has been prepared from actual survey of the premises. ALL DIMENSIONS SHOWN IN FEET AND DECIMAL FEET THEREOF DIMENSIONS SHOWN ALONG CURVES ARE SPEED MEASUREMENTS.

PLAT SHOWING SURVEY OF A 6.4987 ACRE TRACT CONVEYED TO GEORGESVILLE STORAGE ASSOCIATES BY DEED OF RECORD IN OFFICIAL RECORDS 9616-002, RECORDER'S OFFICE, FRANKLIN COUNTY OHIO.

SCALE: 1" = 40'
APRIL 29, 1987
REVISED TO SHOW 2.2208 AC. & 4.2780 AC. Revised April 25, 1988
AUGUST 28, 1989

Harry L. Greene
HARRY L. GREENE, REGISTERED SURVEYOR - NO. 4059