


TREMONT

ROAD

BLVD.


NORTHWEST

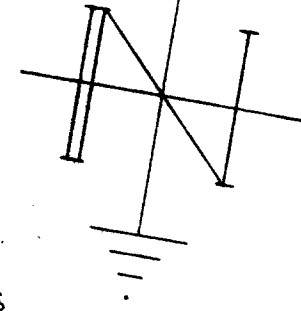

July 1958  

Revised for HUMBLE OIL & REFINING COMPANY  
OHIO DIVISION - July 29 - 1960.

Harry L. Greene  
Harry L. Greene, Reg. Surveyor No. 4058.

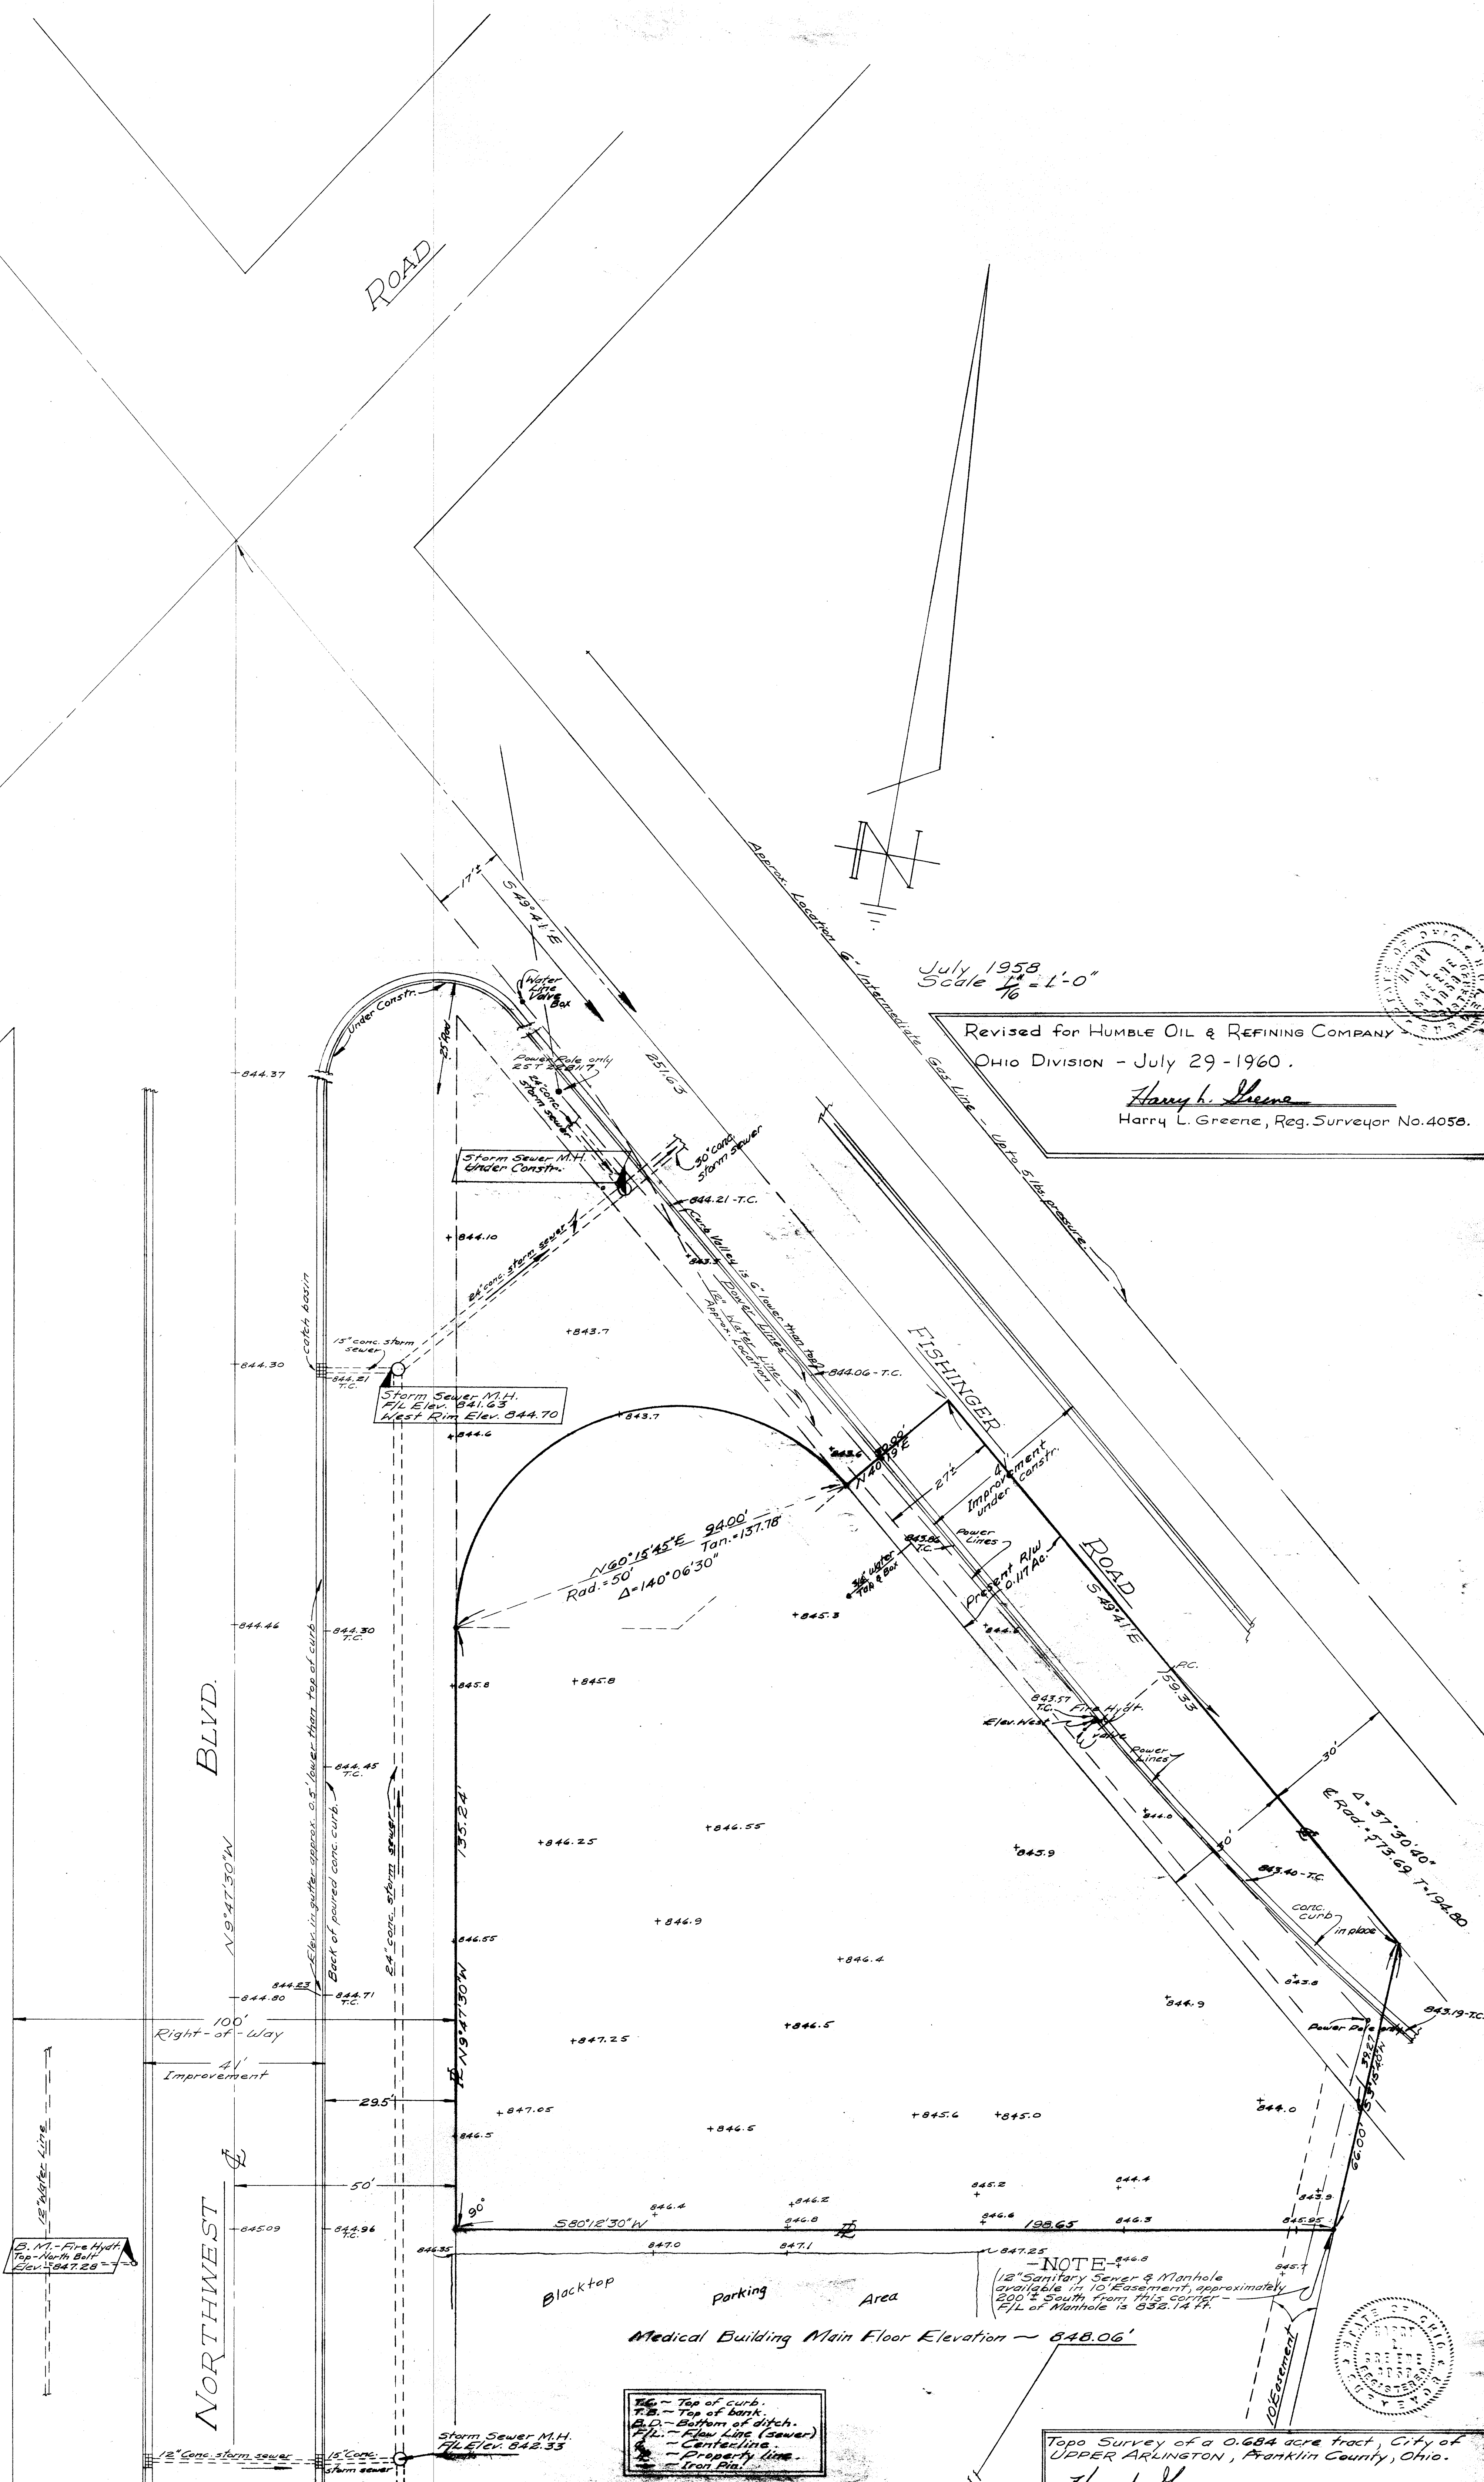

TC - Top of curb.  
TB - Top of bank.  
BD - Bottom of ditch.  
FL - Flow Line (sewer)  
CL - Centerline.  
PL - Property line.  
IR - Iron Pipe.

NOTE -  
12" Sanitary Sewer & Manhole available in 10' Easement, approximately 200' South from this corner - F.L. of Manhole is 838.14 FF.

Topo Survey of a 0.684 acre tract, City of UPPER ARLINGTON, Franklin County, Ohio.  
Harry L. Greene  
Harry L. Greene - Reg. Surveyor, No. 4058  
2160 Tremont Center, Columbus, 21, Ohio

