


S.W. Cor. Greenhouse

Delroy Rd. 50' no curbs

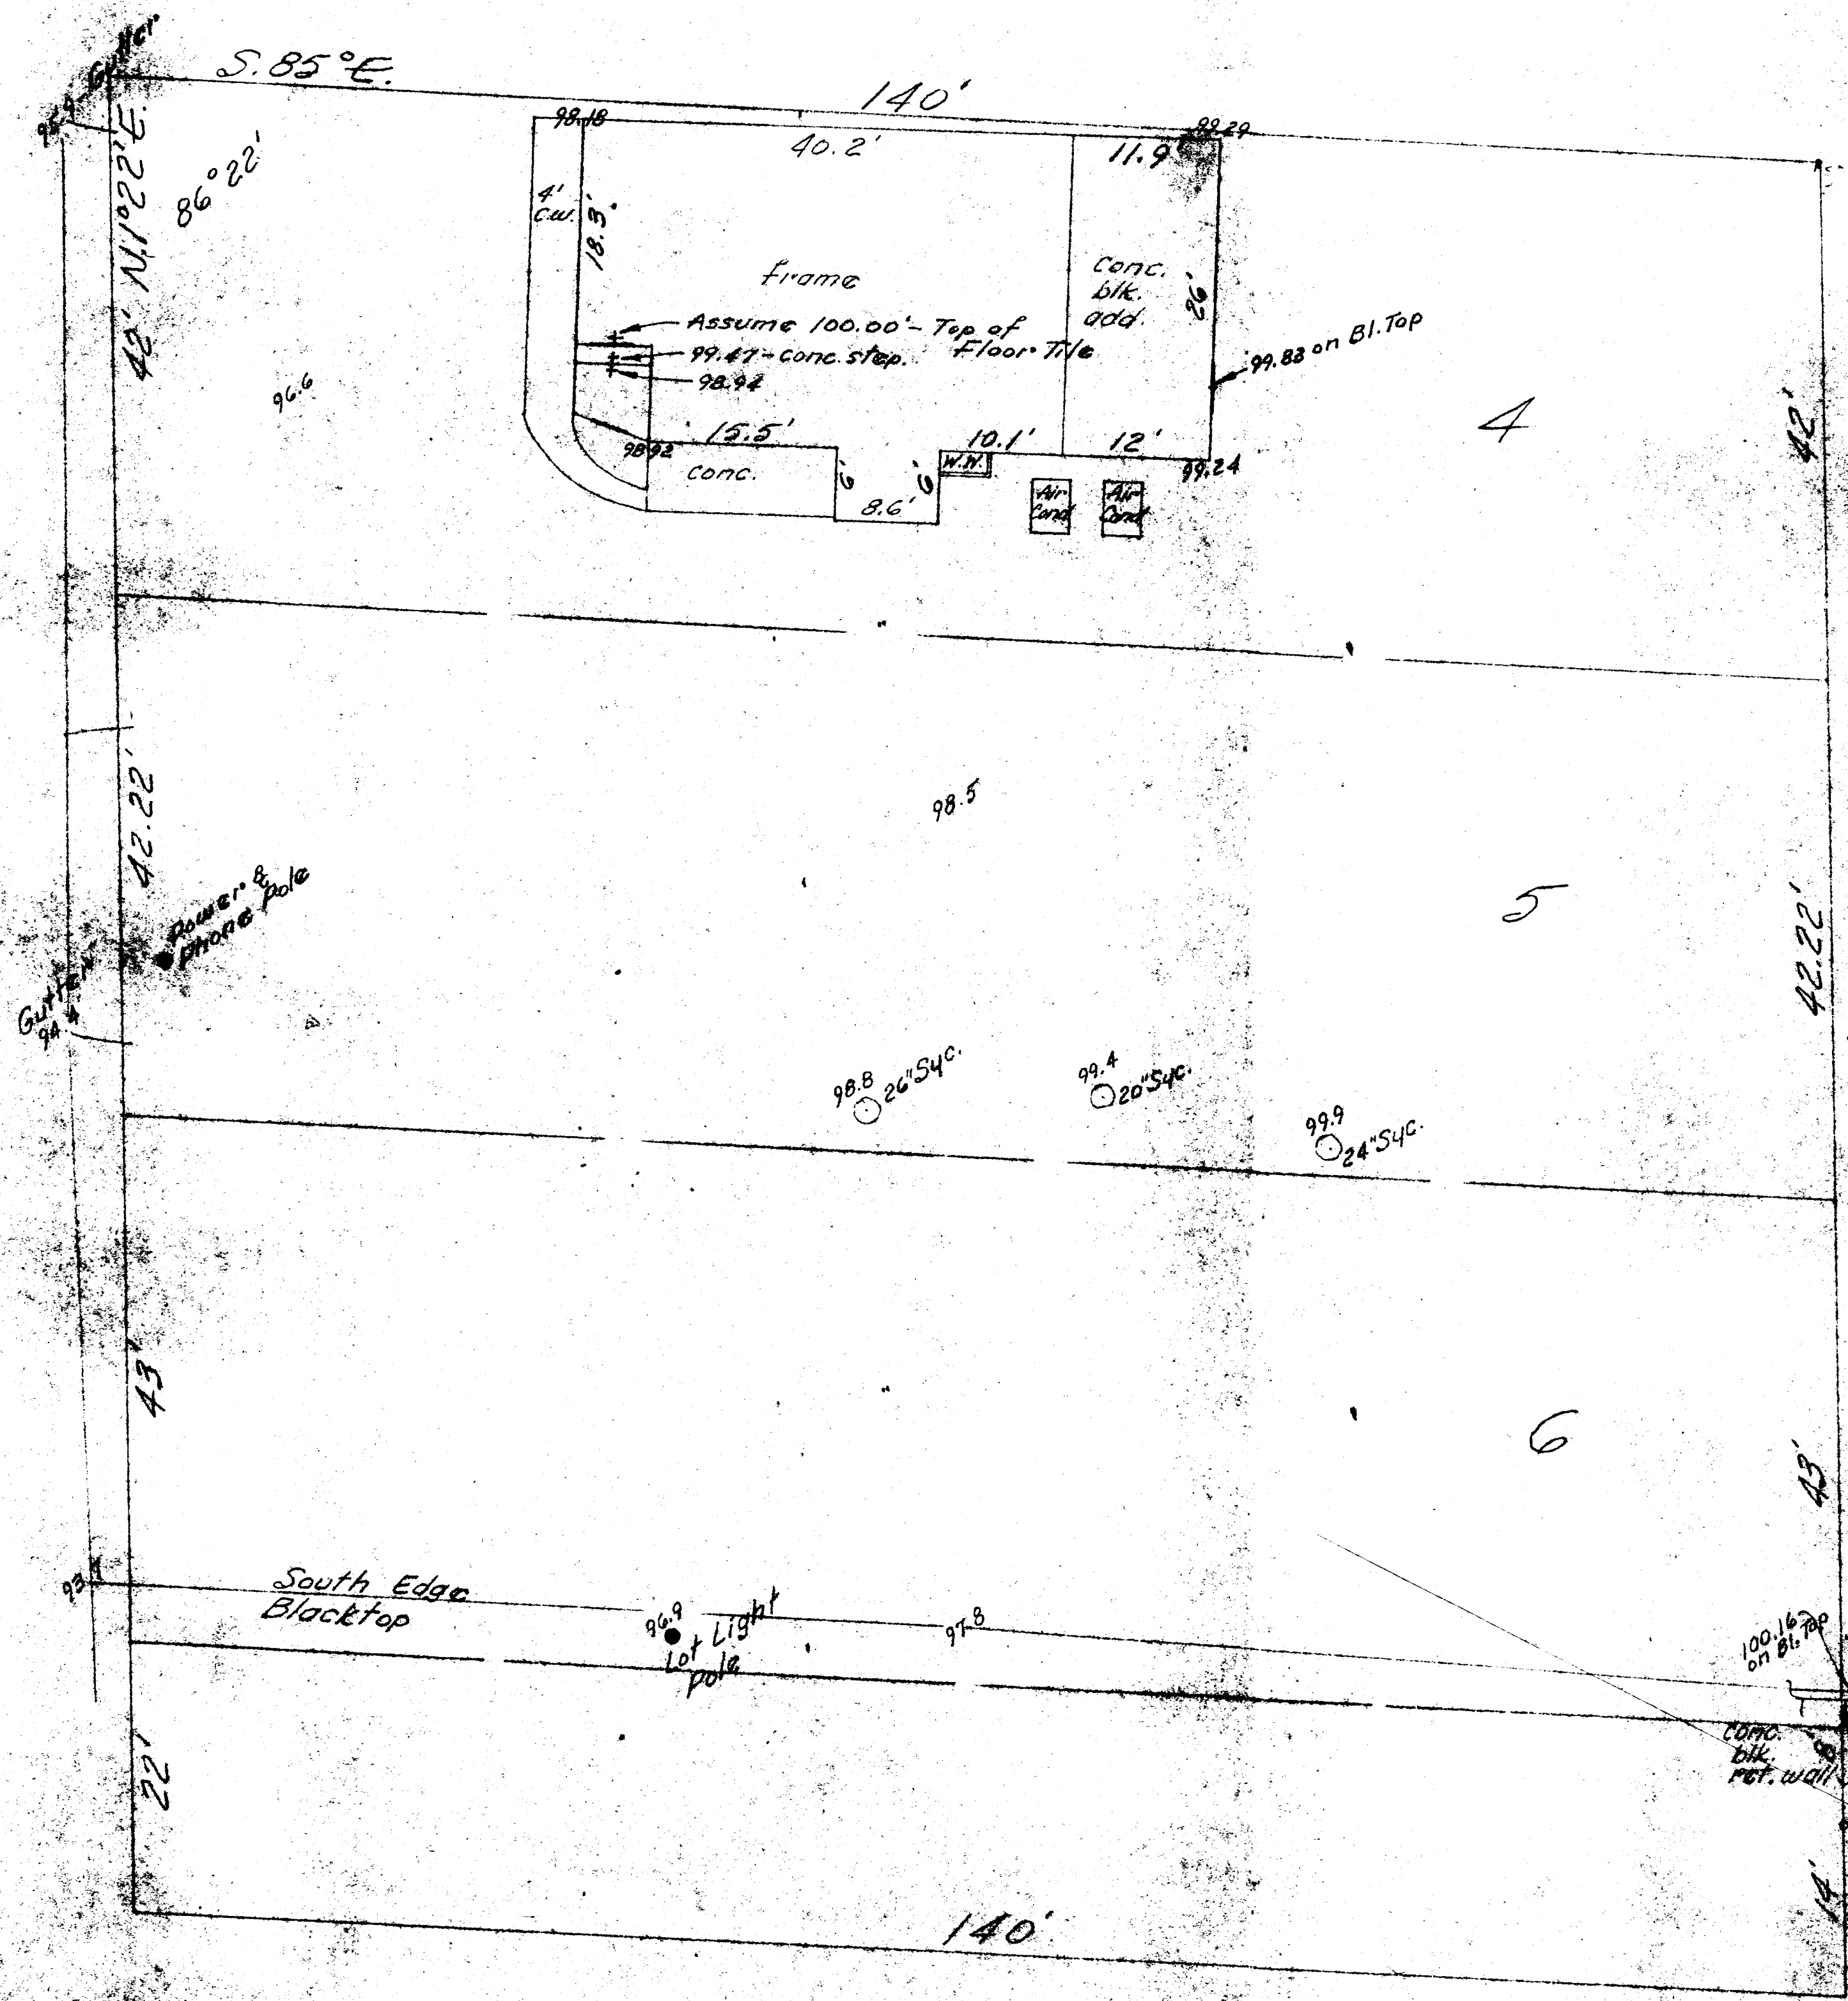

1" = 10'  
Nov. 26 - 75

S. High St. 66'

S. 85° E.

42' N11°22'E

86°22'

140'

42.22'

43'

22'

140'

42'

42.22'

43'

15' alley

16' alley

4

5

6

96.8

99.0

96.6

98.5



99.9 24" Sq.



100.16 on Bl. Top

conc. blk. ret. wall

1.5' P.P.