


IRON PIN or Spike Cors. Set, this date. Jan. 15-1968.

I hereby certify that I have surveyed & staked the above shown 14.2053 Ac. Tract and said survey is correct.

- NOTE -

Deeds of record in D.B. 924, pg. 475 & D.B. 957, pg. 442, refer to easements to Col's. Railway Power & Light Co., over, across, thru & upon property along the highways known as Henderson Road, Rds

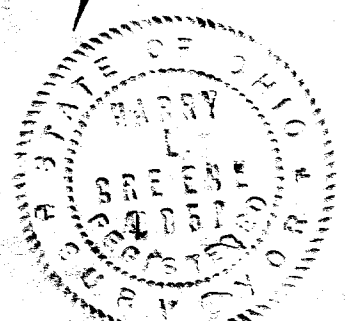

**Zayre Shopping Center**

City of Upper Arlington, Franklin County, Ohio. (Columbus)

Chase Manhattan Bank - Chicago Title Insurance Company

Re: **KIMCO DEVELOPMENT CORPORATION.** ARTHUR W. ...

Blue Print Survey ~ SIDNEY ...

I hereby certify that I have prepared the above plat from survey and inspection of herein described premises and existing conditions are as shown above. Being more particularly described per attached description.

Drawn June 20-1967, Revised Jan. 15-1968 and further Revised Aug. 14-1968, to show Bldg. Constr. ... Revised July 11-1974

