

Myers Surveying Company, Inc.

2740 East Main Street, Columbus 43209 (Bexley), Ohio
614-235-8677 FAX:614-235-4559


A Boundary Survey prepared for and certified to:

Abdallah Aljakhsi and Abdallah Aljacksy

Legal Description: Situated in The State of Ohio, County of Franklin, City of Columbus, Being Lot 214, 215 and Part of Lot 213, Swaynes Addition, Plat Book 2, Page 35

Applicant:

Posted Address: 741 S. 17th Street, Columbus, Ohio

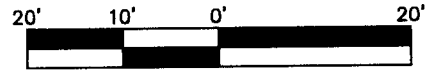


Scale 1" = 20'

Date: 08/23/2022



PUTNAM ALLEY 20'

(formerly Central Alley until 11/26/1900)

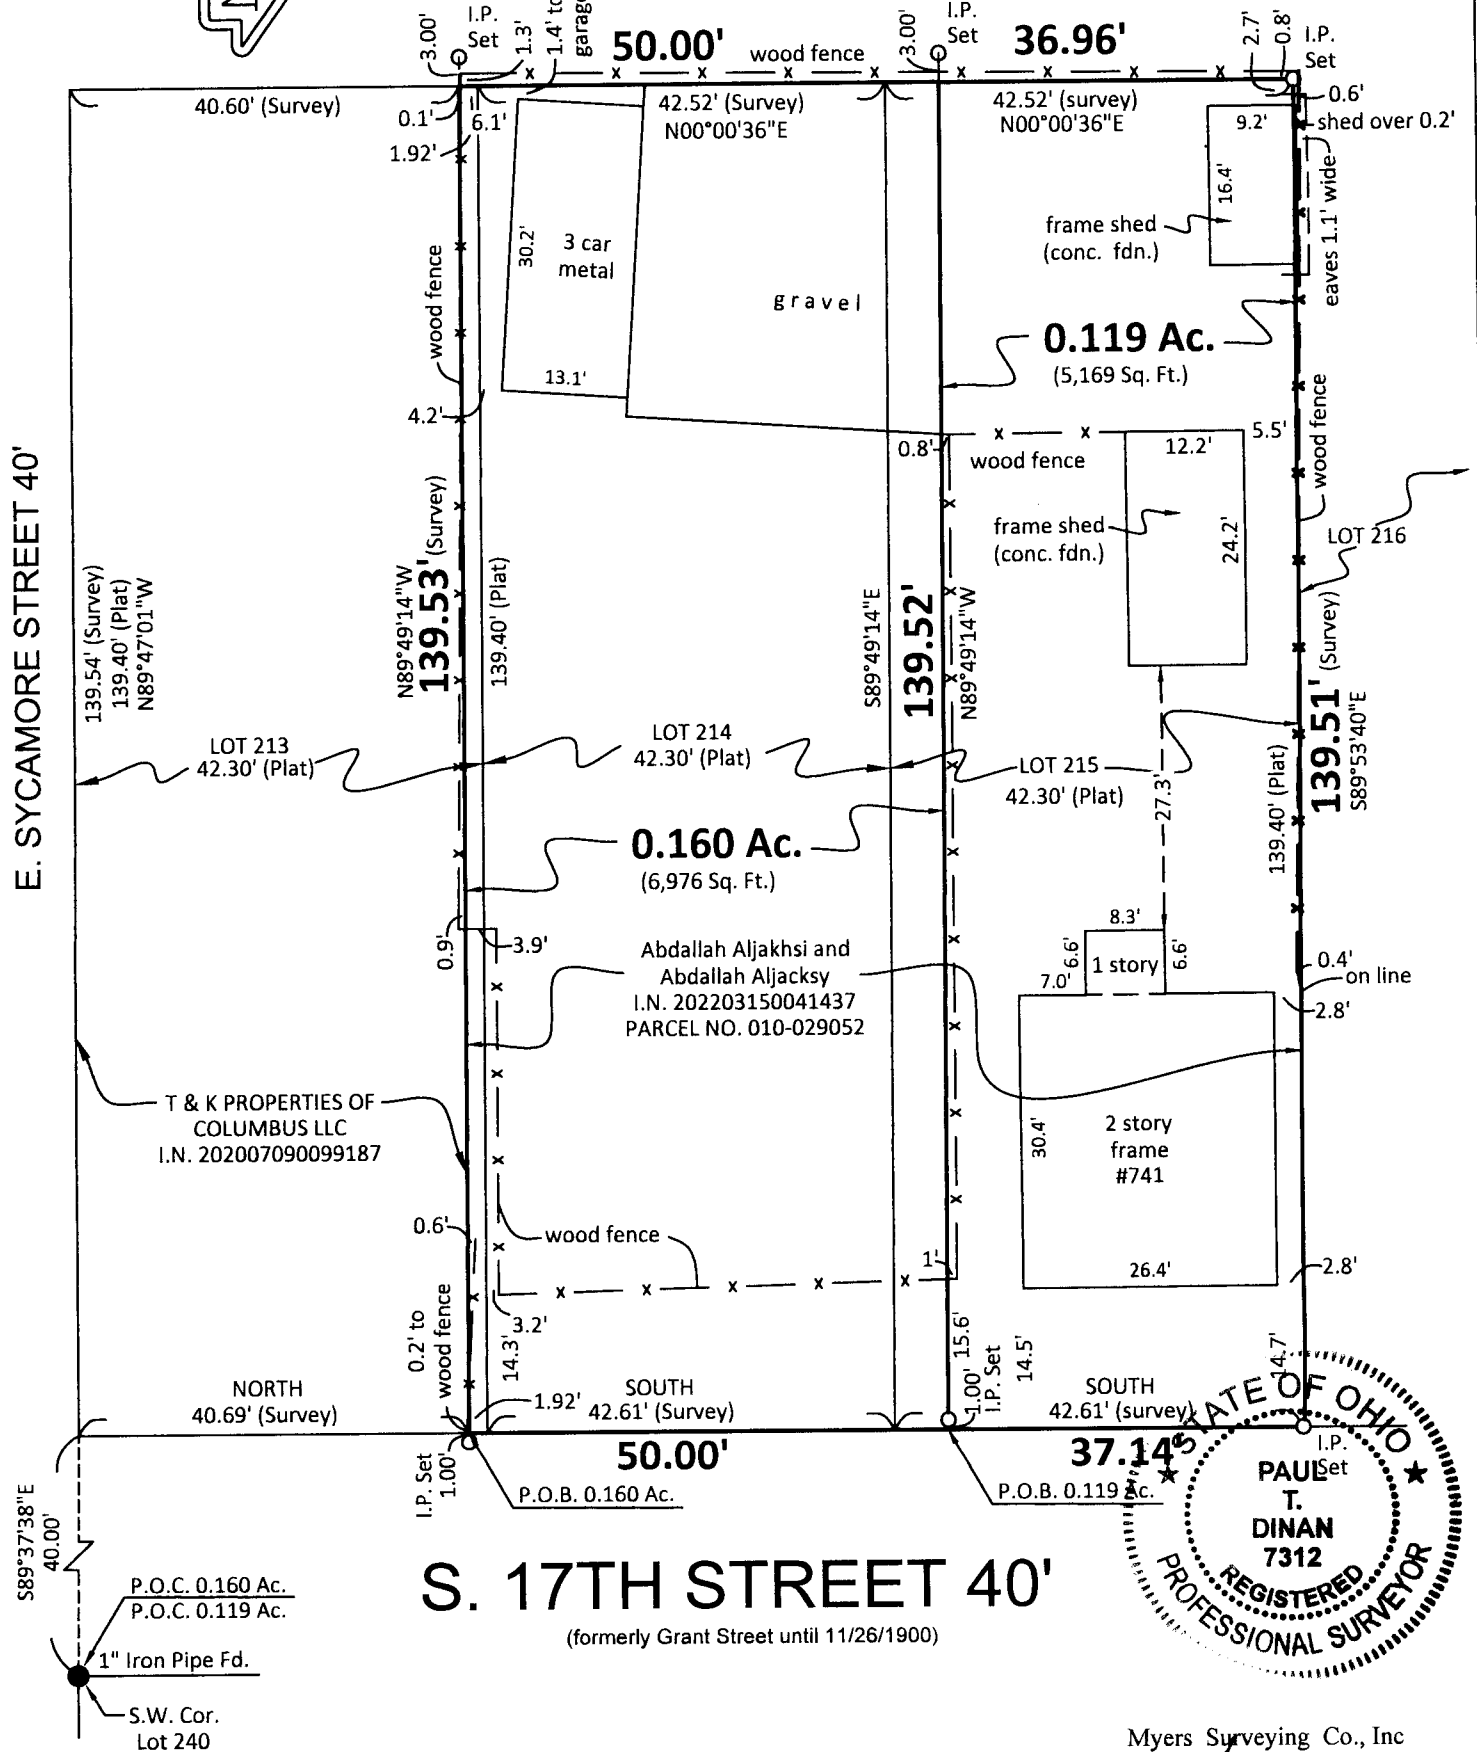

Myers Surveying Co., Inc

By *Paul T. Dinan*

Professional Surveyor

We hereby certify that the foregoing Boundary Survey was prepared from actual field measurements in accordance with Chapter 4733-37 Ohio Administrative Code. Iron pipes set are 30"x1" O.D. with an orange plastic plug inscribed "MYERS P.S. 6579", unless otherwise noted. Basis of bearings is the west line of South 17th Street as assumed North.

Myers Order No.-4-06/10/2022	Rec.	Field	DWG.	Ltr.	Ck.
		RO	KK		