# LOT SPLIT

EXHIBIT "A"

SITUATED IN THE STATE OF OHIO, COUNTY OF FRANKLIN, TOWNSHIP OF JEFFERSON, AND BEING PART OF LOT 7, QUARTER TOWNSHIP 1, TOWNSHIP 1, RANGE 16, OF THE UNITED STATES MILITARY LANDS, AND BEING PART OF A 7.481 ACRE TRACT AS CONVEYED TO KURTIS D. & KELLI S. STROYER OF RECORD IN INSTRUMENT # 202012160200689, OF THE FRANKLIN COUNTY RECORDER'S RECORDS.

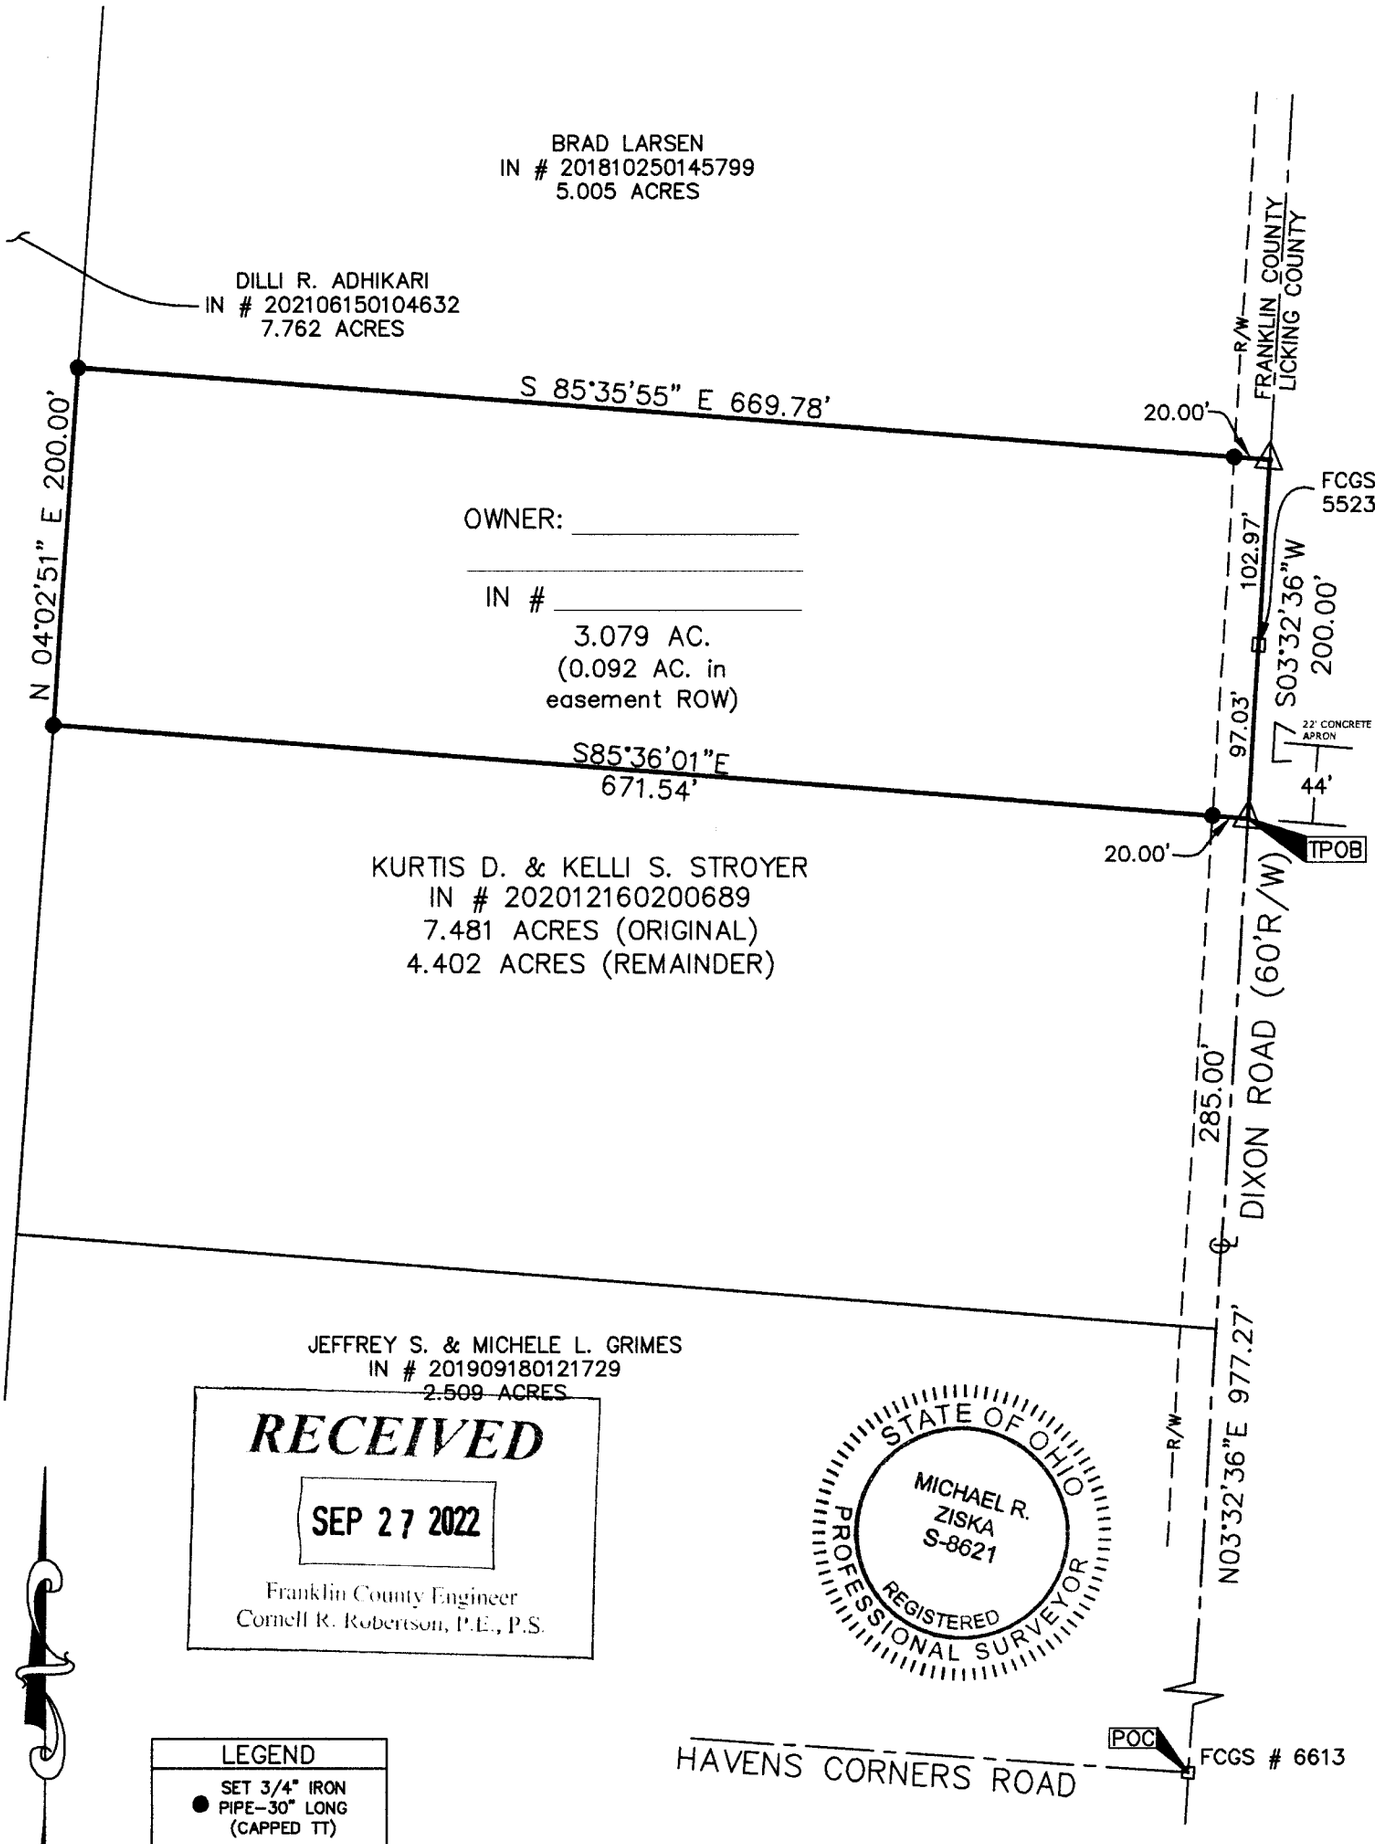


RECEIVED
SEP 27 2022
Franklin County Engineer
Cornell R. Robertson, P.E., P.S.

STATE OF OHIO
MICHAEL R. ZISKA
S-8621
REGISTERED PROFESSIONAL SURVEYOR

NORTH

| LEGEND |
|---|
| ● SET 3/4" IRON PIPE–30" LONG (CAPPED TT) |
| △ PK NAIL SET |

GRAPHIC SCALE

100 0 50 100

1 inch = 100 ft.

Basis of Bearings:
Bearings are based on the County Line between Franklin and Licking County being N03°32'36"E as delineated in IN # 202012160200689.

Columbus, Ohio
TERRATEK INC
LAND SURVEYING & MAPPING

**LOT SPLIT**

Situated in the State of Ohio, County of Franklin, Township of Jefferson,

**CERTIFICATION:** THIS PLAT IS PREPARED FROM RECORDS ON FILE AT THE FRANKLIN COUNTY AUDITOR, RECORDER & ENGINEER'S OFFICES AND BASED ON AN ACTUAL FIELD SURVEY PERFORMED UNDER THE DIRECT SUPERVISION OF MICHAEL R. ZISKA, REGISTERED SURVEYOR #8621 DURING AUGUST 9, 2021 AND IS TRUE AND CORRECT TO THE BEST OF MY KNOWLEDGE.

BY: _____

**Michael R. Ziska** REGISTERED STATE OF OHIO
PROFESSIONAL SURVEYOR No. 8621
DATE OF PLAT: 7/30/2022