



8510-24

SURVEY OF 9.0874 ACRES FOR FRANK L. WILCOX

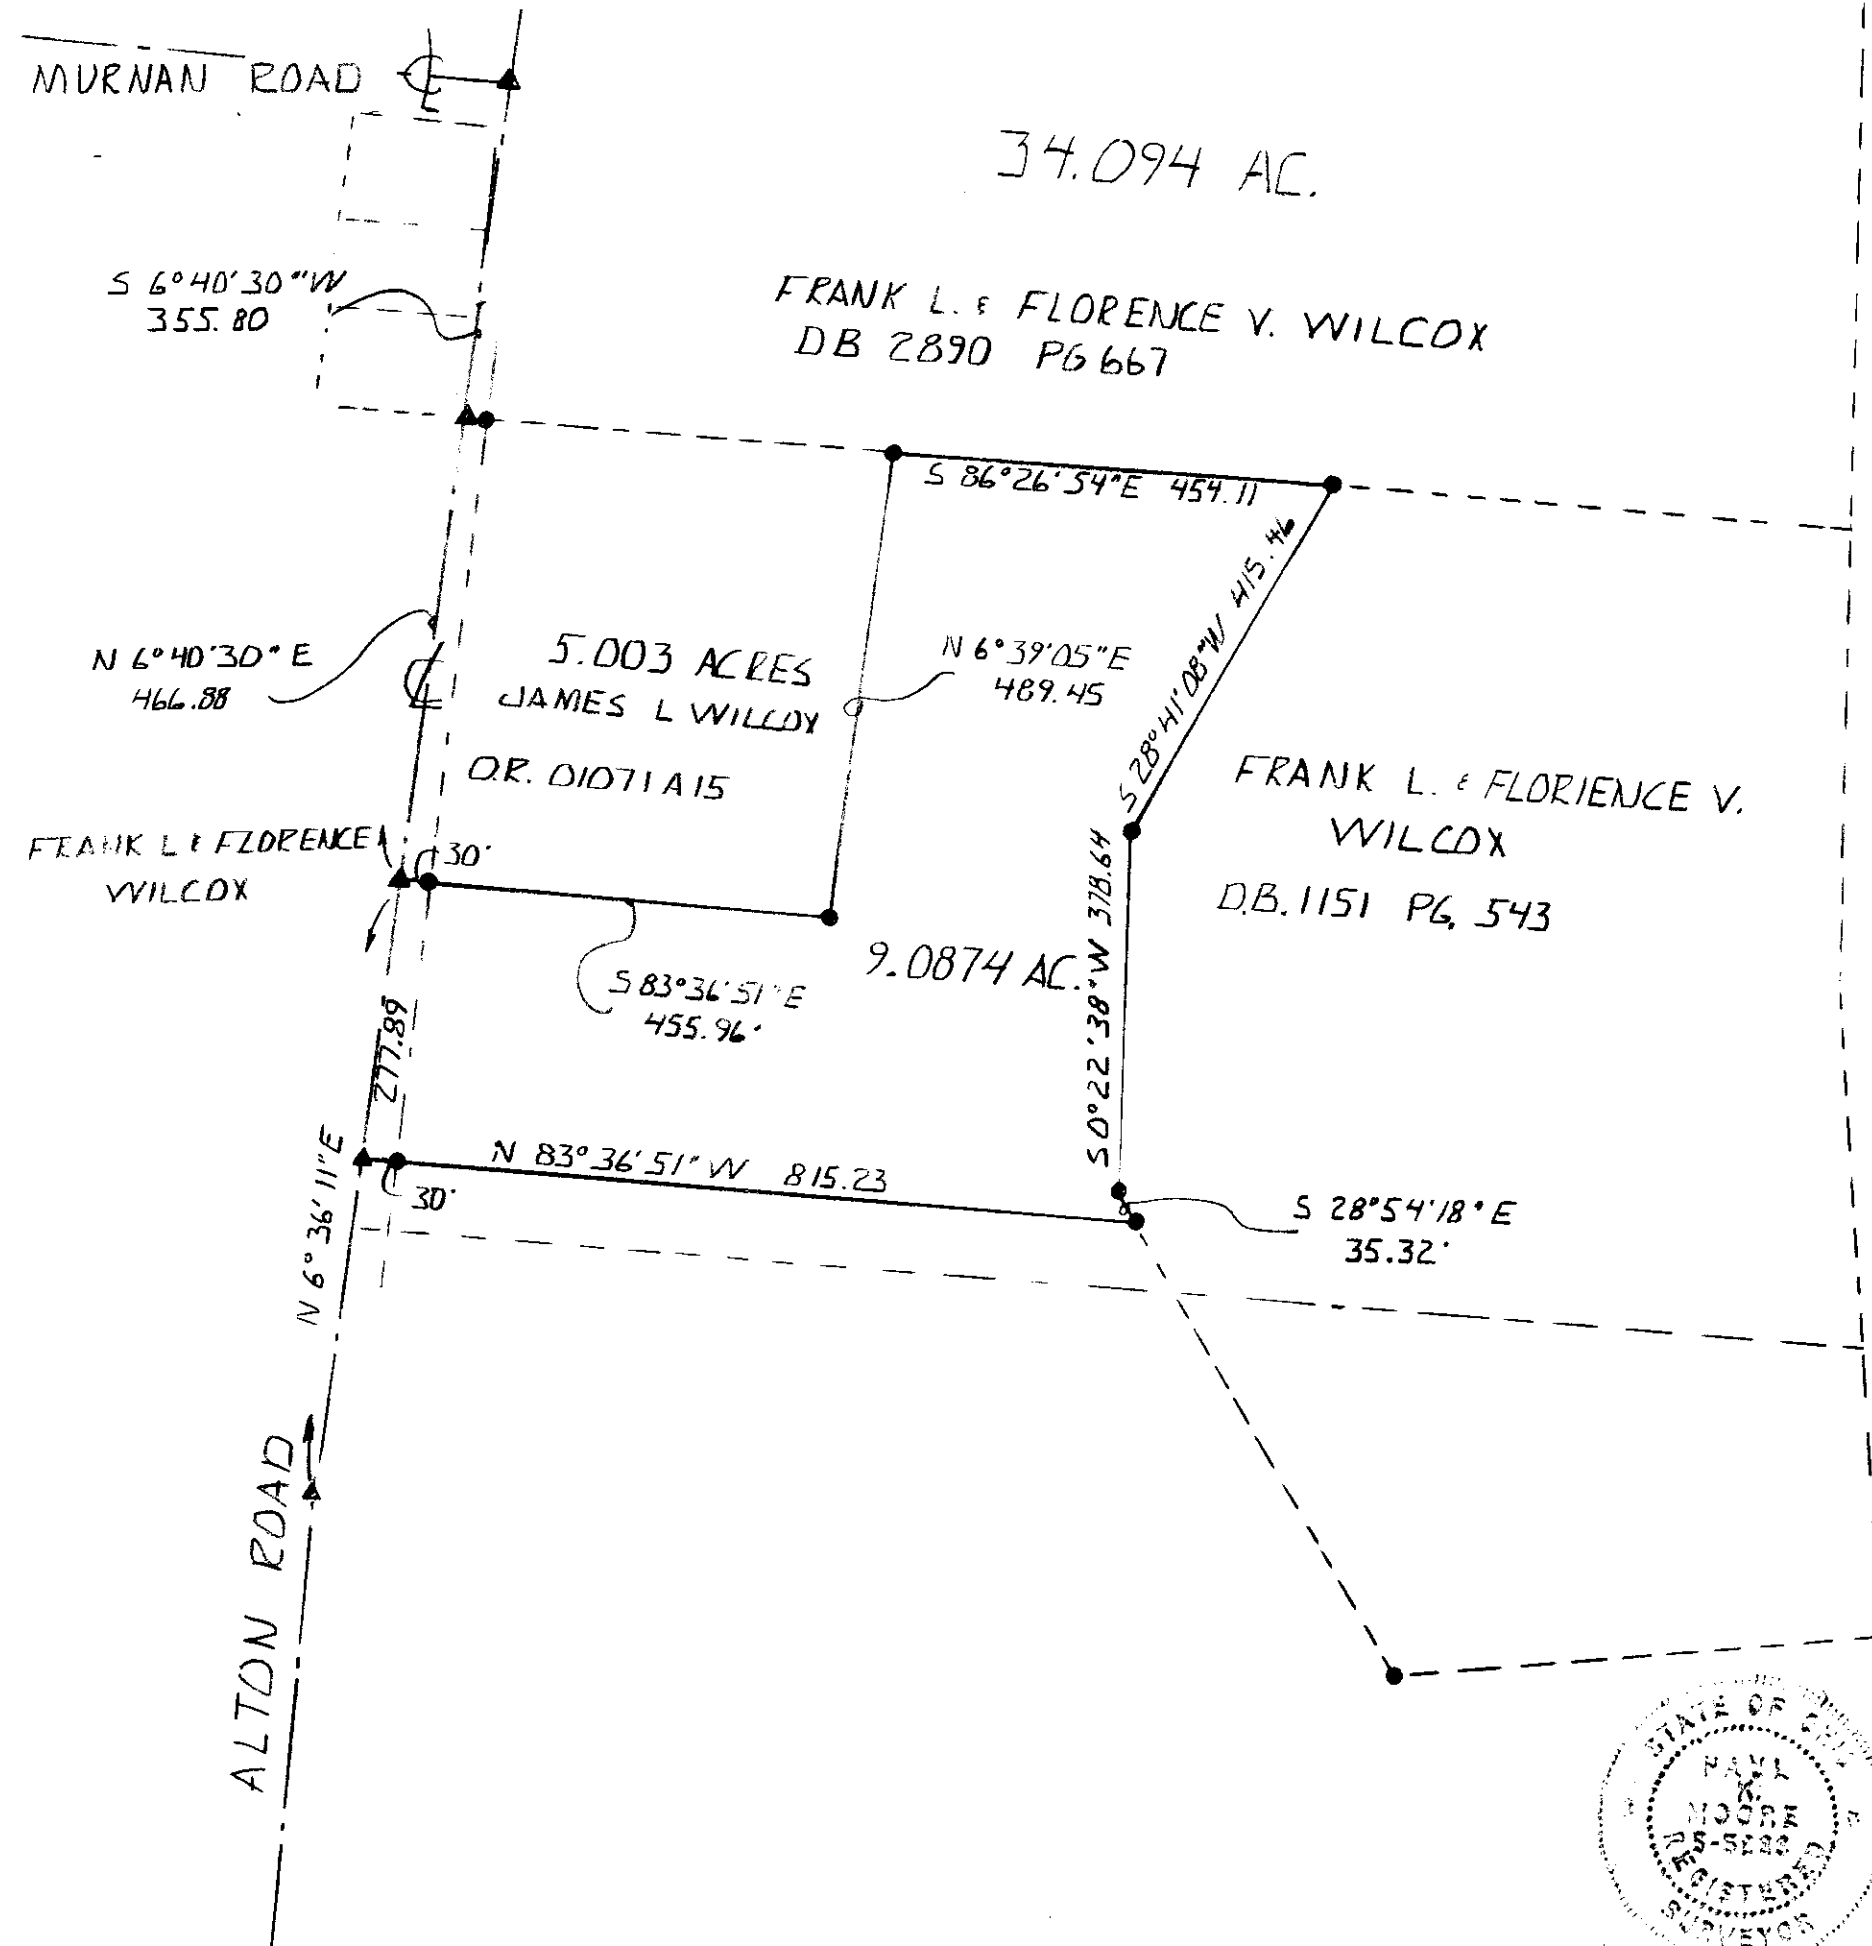

NORTH

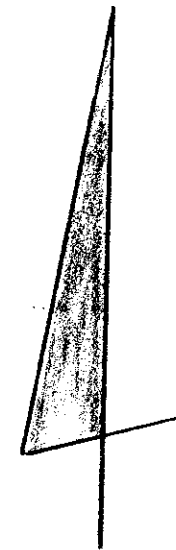

**NOT
REVIEWED**

DREYFUS INTERSTATE
DEVELOPMENT CO.

SCALE 1" = 200'

BEING PART OF A 29.61 ACRE TRACT CONVEYED TO FRANK L. AND FLORENCE V. WILCOX SHOWN OF RECORD IN DEED BOOK 1151, PAGE 543, RECORDER'S OFFICE, FRANKLIN COUNTY, OHIO, AND BEING A PART OF VIRGINIA MILITARY SURVEY 5234, PRAIRIE TOWNSHIP, FRANKLIN COUNTY, OHIO.

THIS DRAWING WAS PREPARED FROM AN ACTUAL FIELD SURVEY MADE BY PAUL K. MOORE & ASSOCIATES ON OCTOBER 25, 1985 AND REPRESENTS THE PREMISES AS SHOWN HEREON TO THE BEST OF OUR KNOWLEDGE.

SIGNED AT REYNOLDSBURG, OHIO THIS 28th DAY OF OCT 1985.

Paul K. Moore

PAUL K. MOORE, REGISTERED SURVEYOR NO. 5883



95024 (21)