
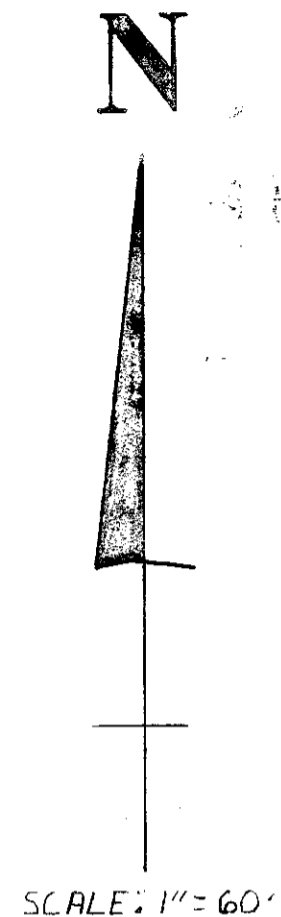


SURVEY OF 1.8763 ACRES
FOR
HUBERT KELLY

ELLEN L. TRIPP
75.345 AC.
D.B. 3119; PG 348

SITUATED IN JEFFERSON TOWNSHIP, FRANKLIN COUNTY, OHIO AND BEING A PART OF LOT NO. 14, TOWNSHIP 1, RANGE 16, UNITED STATES MILITARY LANDS, AND ALSO BEING A PART OF LOT'S NO. 10 & 11 OF A CERTAIN PARTITION BY THE COURT OF COMMON PLEAS OF FRANKLIN COUNTY, OHIO, THE PLAT OF WHICH IS OF RECORD IN COMPLETE RECORD 38, PAGE 81, AND BEING A 1.8763 ACRE TRACT OF LAND THE REMAINDER OF A 3.39 ACRE TRACT OF LAND CONVEYED TO HUBERT KELLY AND ANNIS SUE KELLY BY DEED OF RECORD IN DEED BOOK 3017, PAGE 537, FRANKLIN COUNTY RECORDERS OFFICE.

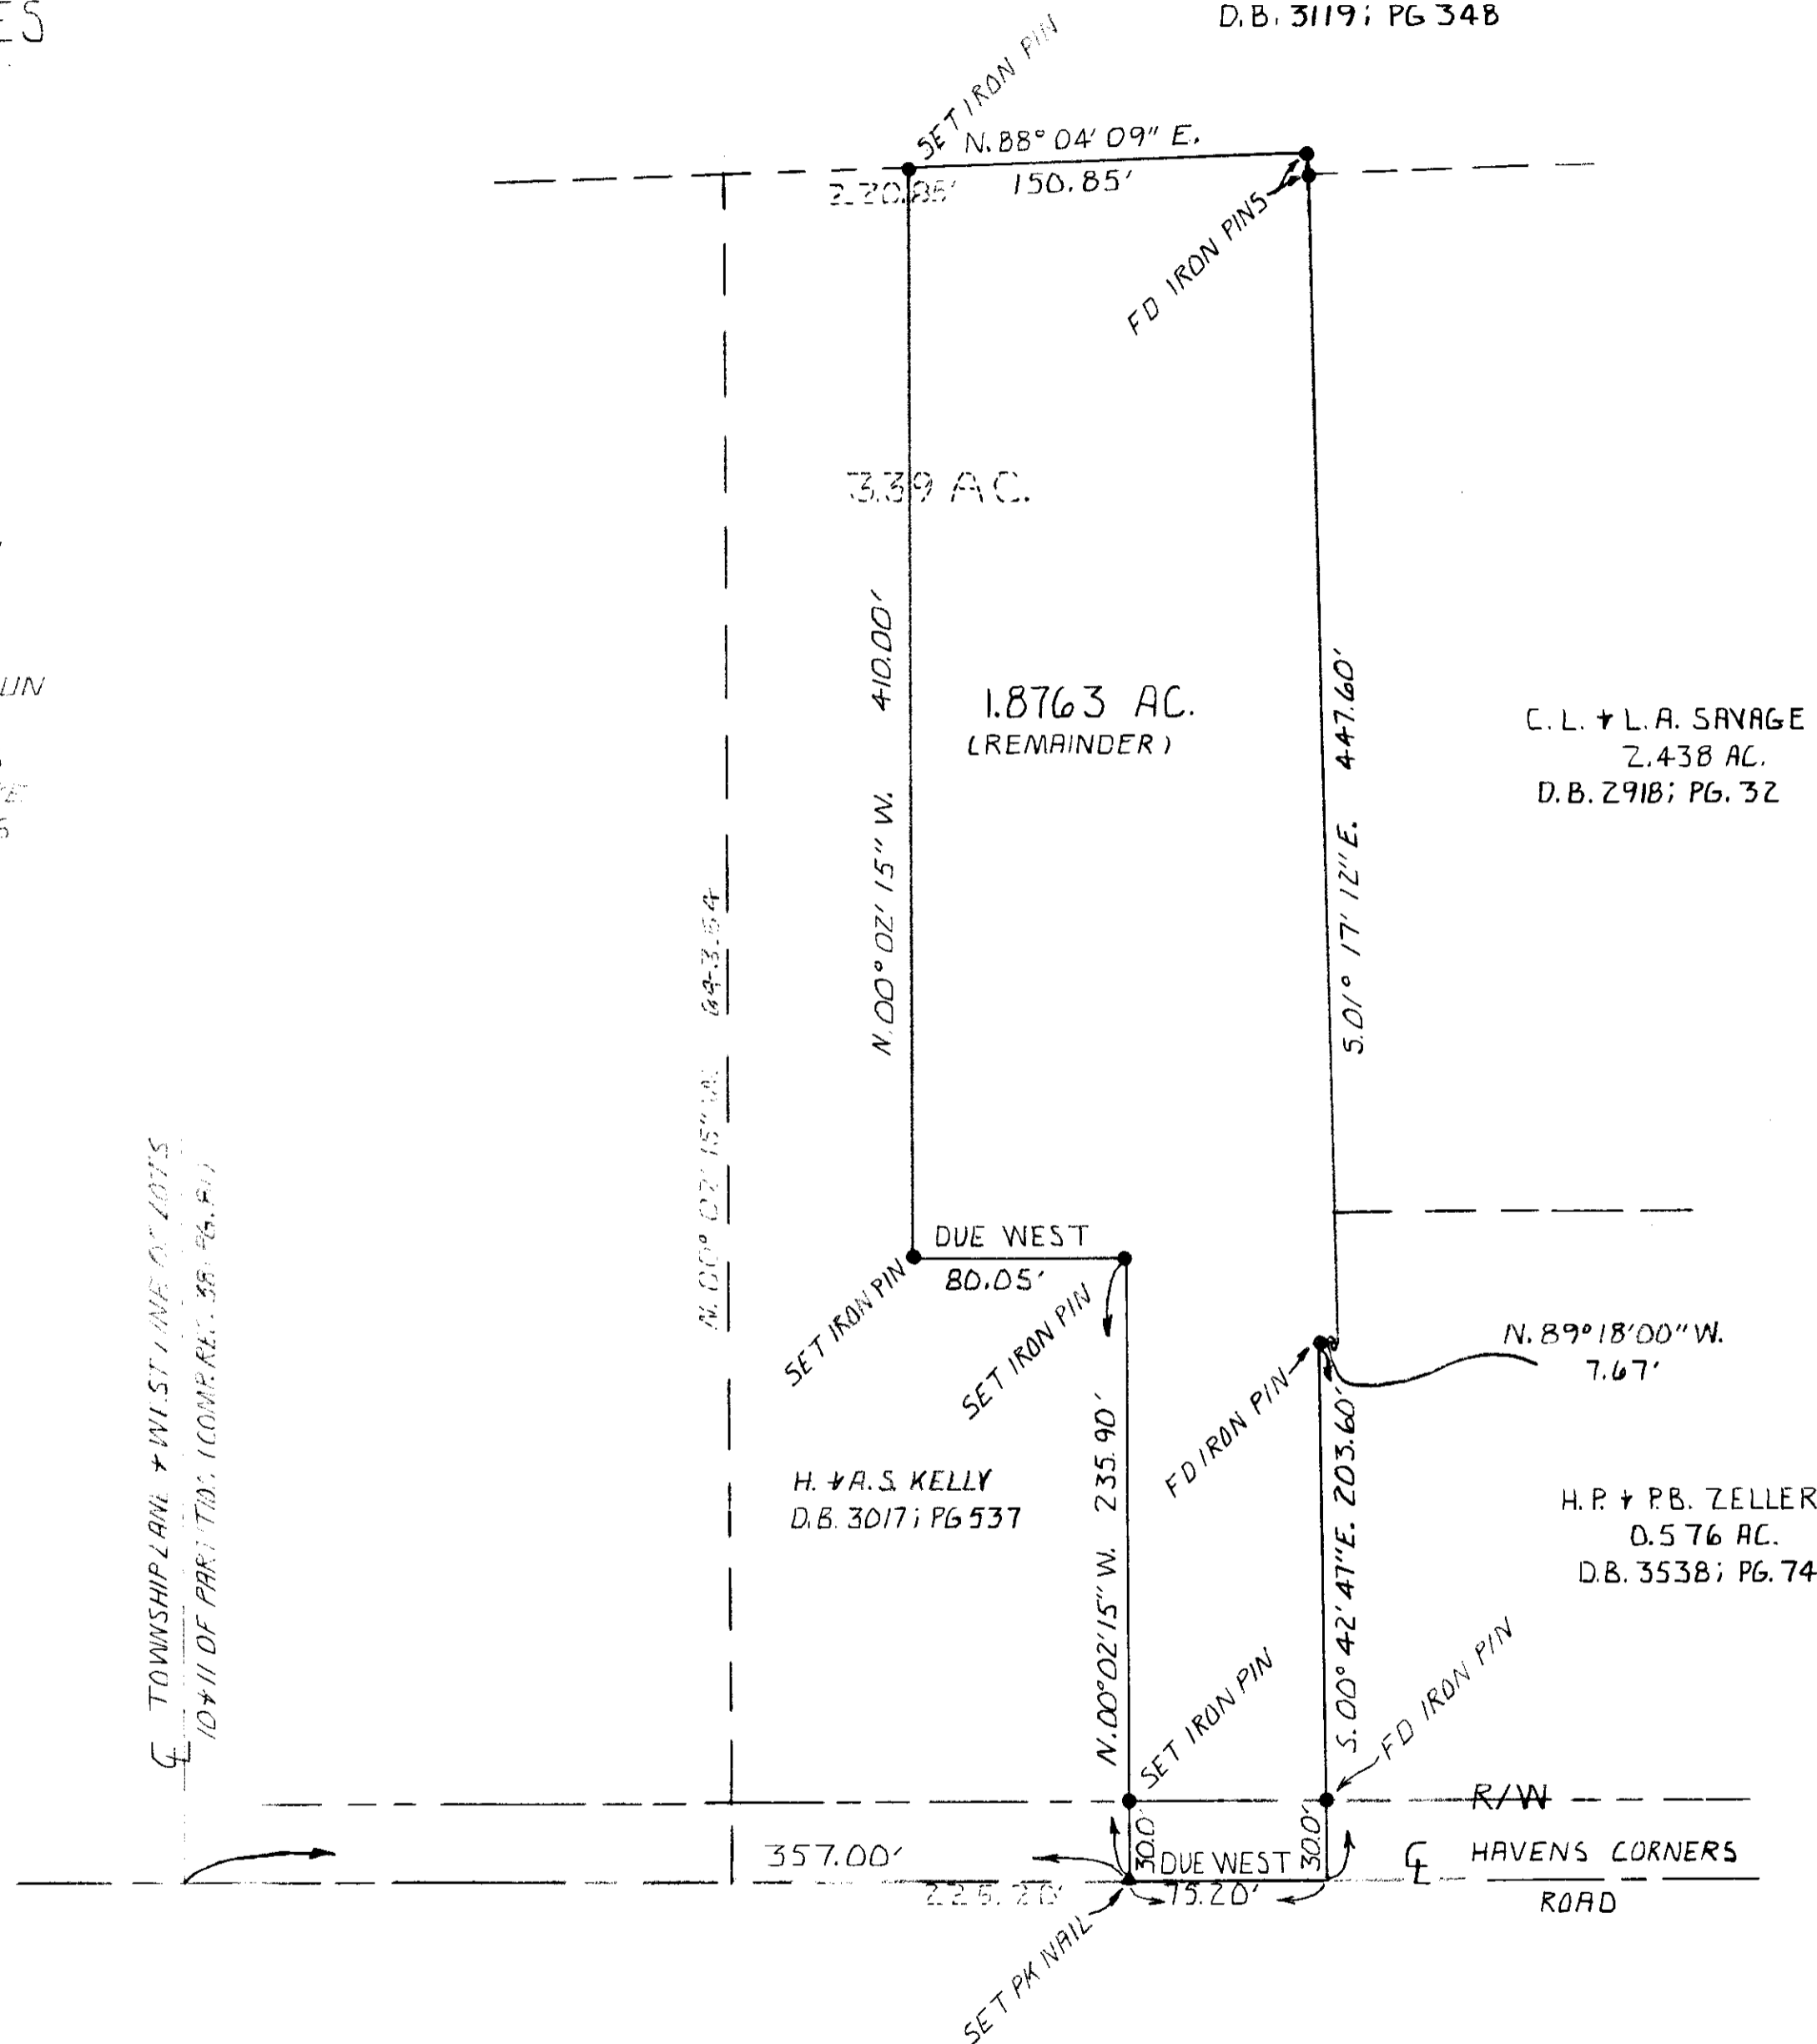

**NOT
REVIEWED**

THIS DRAWING WAS PREPARED FROM AN ACTUAL FIELD SURVEY MADE BY PAUL K. MOORE & ASSOCIATES ON JULY 31ST, 1987, AND REPRESENTS THE PREMISES AS SHOWN HEREON TO THE BEST OF OUR KNOWLEDGE.

SIGNED AT REYNOLDSBURG, OHIO THIS 3RD DAY OF AUGUST 1987.

Paul K. Moore
PAUL K. MOORE, REGISTERED SURVEYOR NO. 5683

PAUL K. MOORE & ASSOC.

6515 E. LIVINGSTON AVE., SUITE 11
BLACKLICK PLAZA
REYNOLDSBURG, OHIO 43068

SCALE 1" = 60'	REVISIONS	BY	DATE
DATE 8-3-87			
DR. J.W.	CKD.		
AP. VD.			
TITLE SURVEY OF 1.8763 ACRES FOR HUBERT KELLY	NO. 8707-45		