Myers Surveying Company, Inc.

2740 East Main Street, Columbus 43209 (Bexley), Ohio
614-235-8677 FAX:614-235-4559

A Boundary Survey prepared for and certified to:

Navarro & Sons Construction

Legal Description: Situated in The State of Ohio, County of Franklin, City of Columbus, Being Lots 53, 54 and 55, Clarfield Addition, Plat Book 18, Page 48, and Part of Vacated Alley by R.R. 18, Pg. 93 as conveyed to Navarro & Sons Contracting LLC and Guymuras LLC in I.N. 202306020053989

Applicant:

Posted Address: 1284 Moundview Avenue, Columbus, Ohio

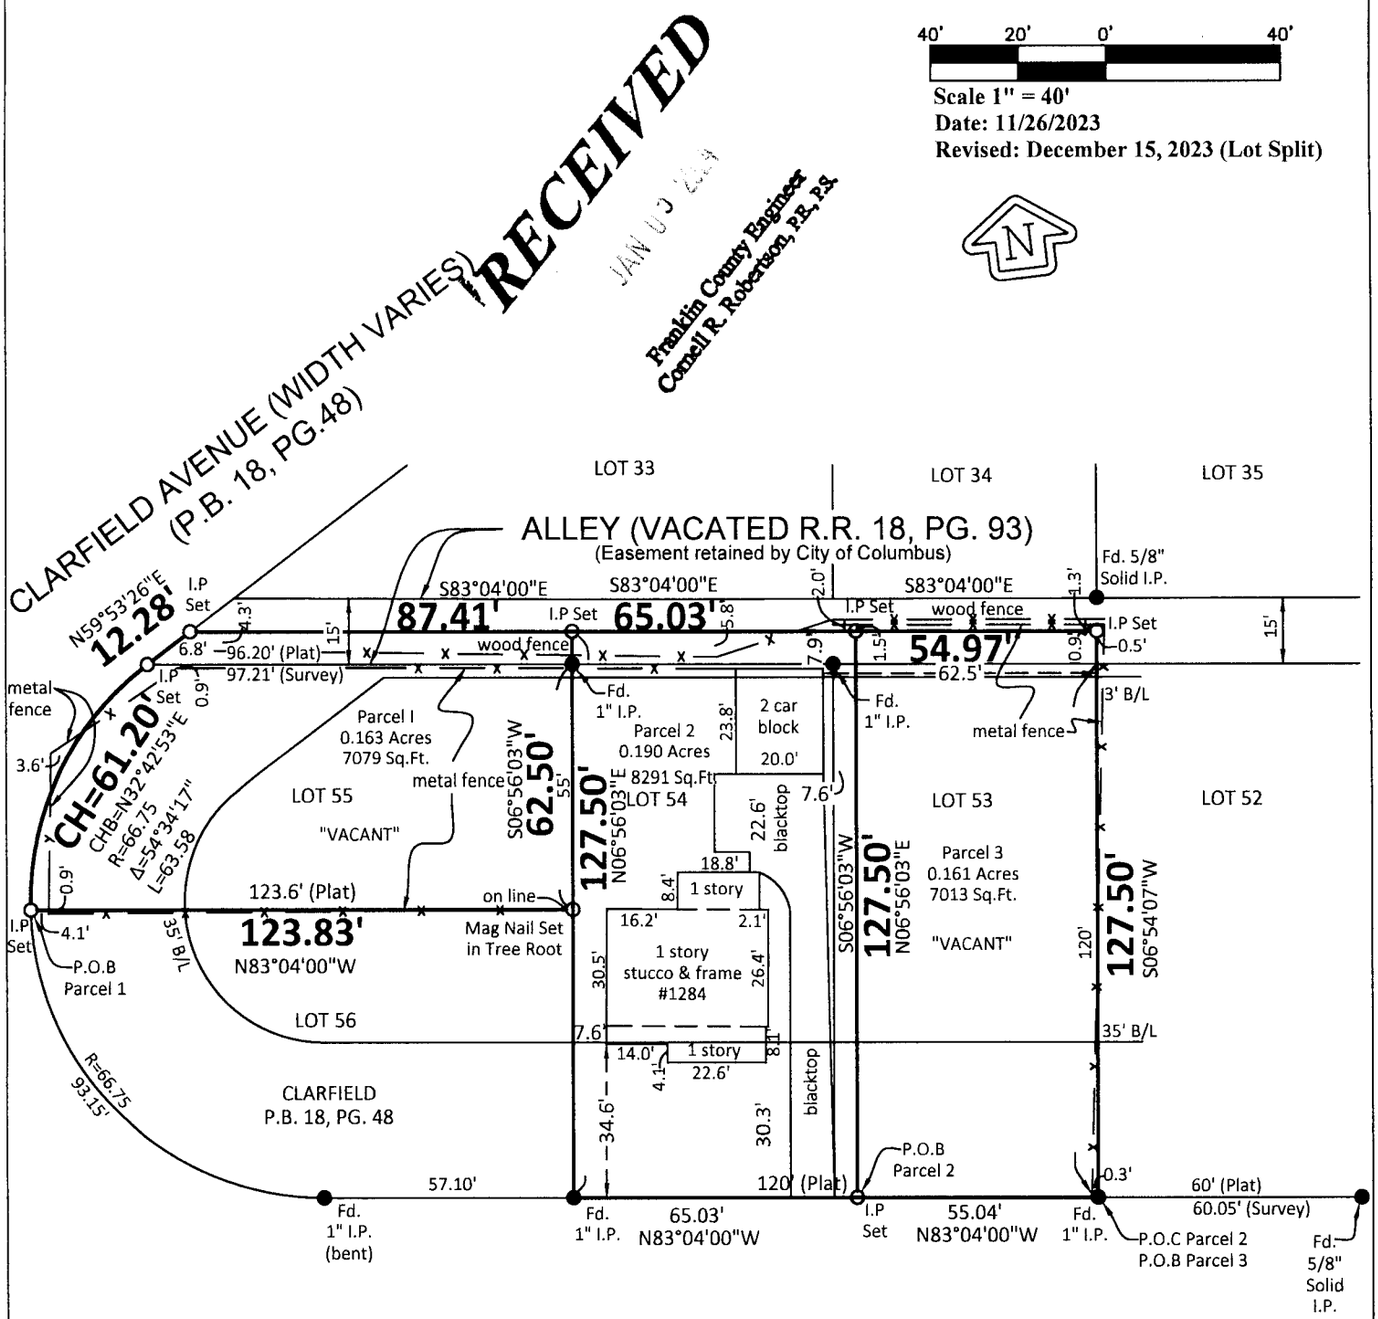

STATE OF OHIO
PAUL T. DINAN 7312
REGISTERED PROFESSIONAL SURVEYOR

Myers Surveying Co., Inc

By _____

12-15-2023

Professional Surveyor

We hereby certify that the foregoing Boundary Survey was prepared from actual field measurements in accordance with Chapter 4733-37 Ohio Administrative Code. Iron pipes set are 30"x1" O.D. with an orange plastic plug inscribed "MYERS P.S. 6579", unless otherwise noted. Basis of bearings is N83°04'00"W on the north Line of Moundview Avenue as recorded in Plat Book 18, Page 48. December 15, 2023.

Myers Order No.-3-09/14/2023	Rec.	Field	DWG.	Ltr.	Ck.