


1" = 20'

FRANKFORT ST. 20'

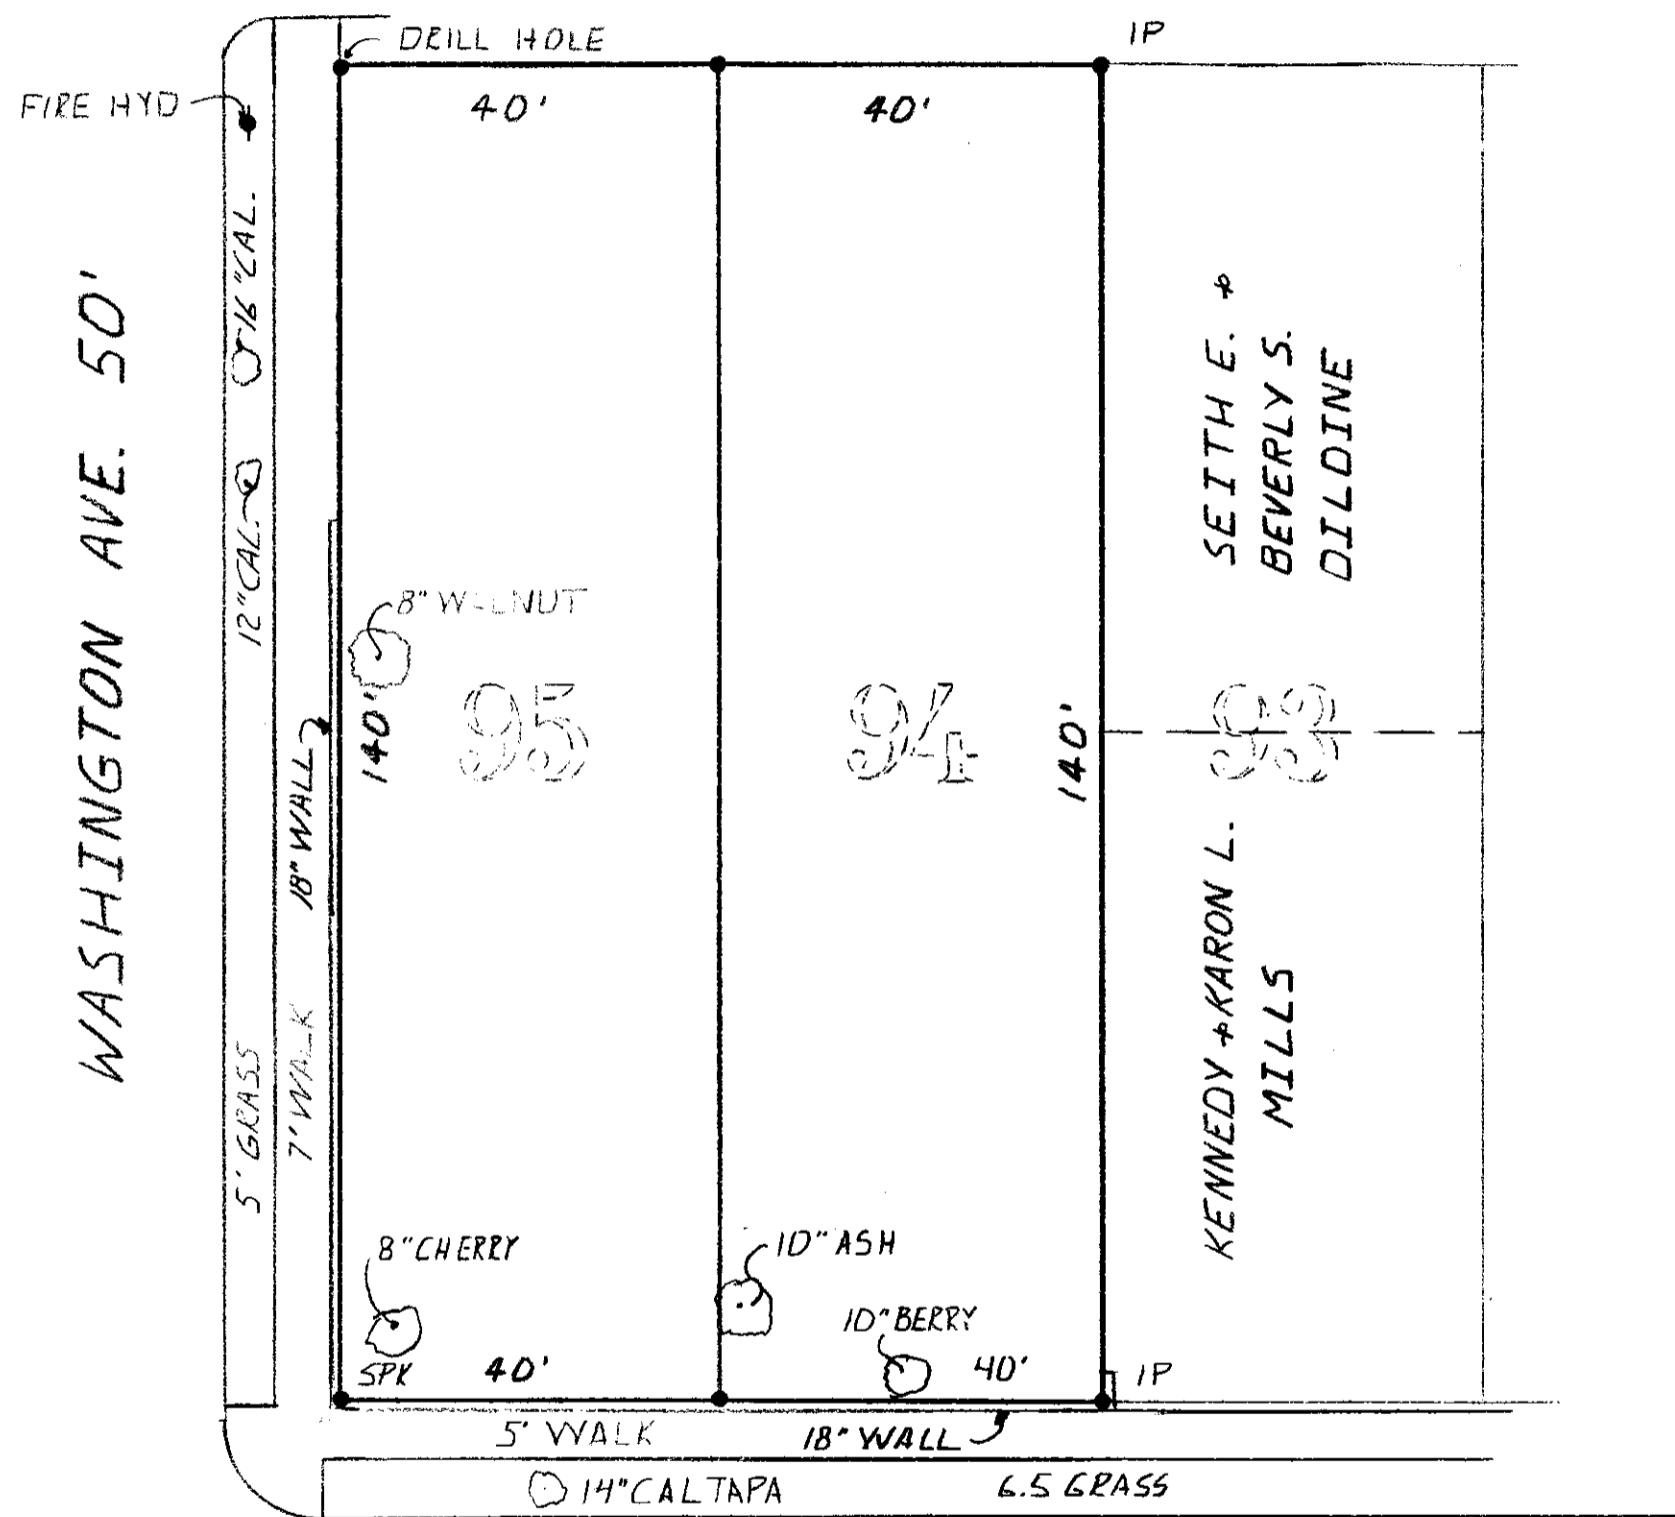

SURVEY

OF

100 EAST COLUMBUS STREET

LOTS 94 & 95 OF CHAPMAN'S ADDITION

PLAT BOOK 1 PAGE 168

NOT REVIEWED

THIS PLAT WAS PREPARED FROM AN ACTUAL FIELD SURVEY MADE BY PAUL K. MODRE ON OCT 11, 1984

Paul K. Modre

PAUL K. MODRE S 5883

10-24-84

DATE

COLUMBUS STREET 55'

TOLERANCES (EXCEPT AS NOTED)	REVISIONS			PAUL K. MODRE & ASSOC
	NO.	DATE	BY	
DECIMAL	1			1839 STOUDER DRIVE REYNOLDSBURG OHIO
±	2			
FRACTIONAL	3			DRAWN BY
±	4			SCALE 1"=20'
ANGULAR	5			DATE 10-24-84
±				DRAWING NO.
				8410-23