


THE THOMAS ENGINEERING & SURVEYING COMPANY  
 3203 West Broad Street, Columbus 4, Ohio  
 No. 1250-47

TO: THE CONNECTICUT GENERAL LIFE INSURANCE COMPANY  
 and  
 LAWYERS TITLE INSURANCE CORPORATION

Lot No. 40, Oakland Park Addn.,  
 City of Columbus, Franklin  
 County, Ohio.

August 19, 1947.  
 Scale 1" = 20'

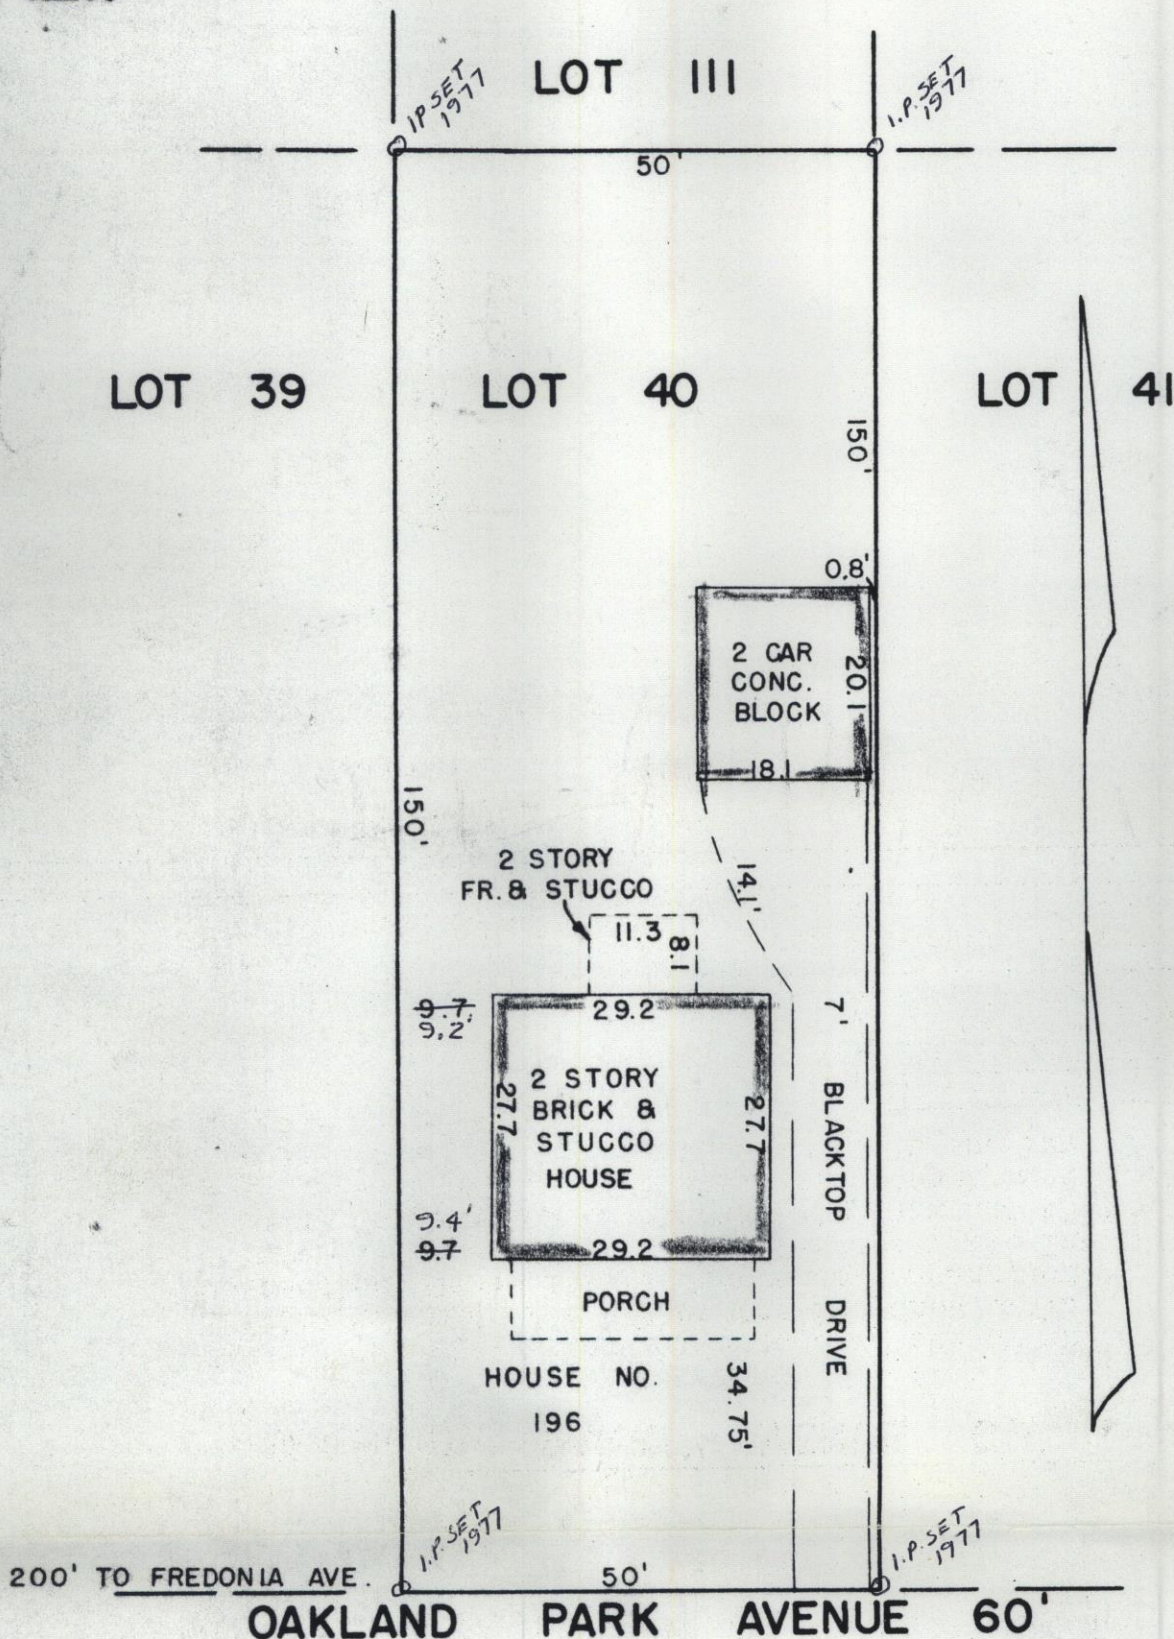

We hereby certify that the foregoing survey and drawing was made for and at the instance of The Connecticut General Life Insurance Company, of Hartford, Connecticut and the Lawyers Title Insurance Corporation, Richmond, Virginia and that there are no encroachments on the property and that the buildings are entirely within the lot lines, ~~except~~

THE THOMAS ENGINEERING & SURVEYING COMPANY,  
*Harley B. Watts*  
 Registered Engineer & Surveyor

RESURVEYED 12-14-77  
*Richard W. Conrad*  
 REGISTERED SURVEYOR S-5041

Applicant: Edavar S. & Esther S. Hall.