

BEING 93.566 ACRES OUT OF A 153.426 (by deed) ACRE TRACT CONVEYED TO JEANNOTTE FRANCIS BISHOP BY DEED BOOK 2500, PAGE 629 SITUATED IN VIRGINIA MILITARY SURVEY no. 882, TOWNSHIP OF BROWN, COUNTY OF FRANKLIN, STATE OF OHIO FOR

JEANNOTTE FRANCIS BISHOP



J.L. Wilcox & Co.  
D.B. 3653, pg. 140  
32.171 ac.

Hi-State Beverage Co.  
D.B. 2783, pg. 507  
199.274 ac.  
Parcel I


Hi-State Beverage Co.  
D.B. 2783, pg. 507  
Parcel III  
152.27 ac.

Robert H. Davis  
D.B. 2249, pg. 447  
6.262 ac.


James B. Sayre (et al 4)  
D.B. 2791, pg. 354  
45.75 ac.

Roy L. & Gladys  
Tackett  
D.B. 3726, pg. 259  
1.000 ac.

NOTES  
1. All dimensions are in feet and decimal parts thereof.

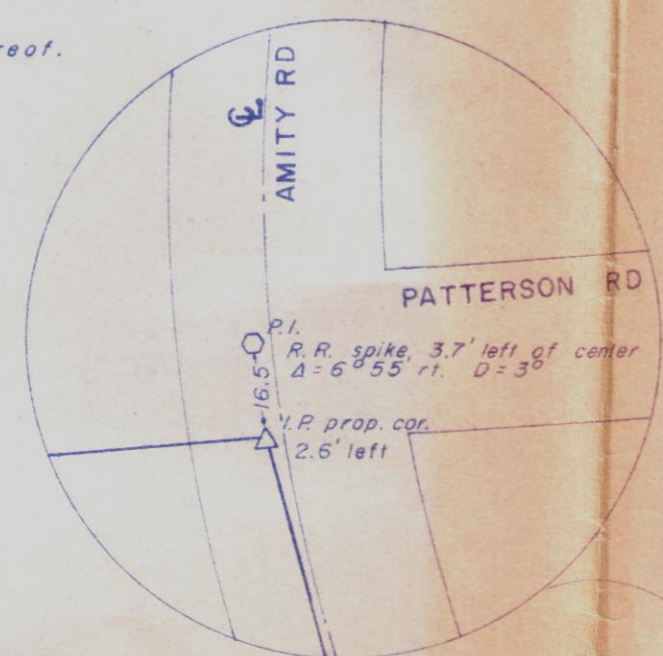

As per Franklin County Engineer's Office

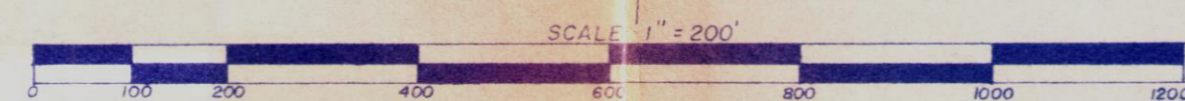

SURVEYED & PLATTED BY

MYERS SURVEYING COMPANY

2740 E MAIN ST.  
BEXLEY OHIO 43209  
614-23-2677

I hereby certify that foregoing plat is a true return of an actual survey of the premises made by me during December, 1985 and is correct to the best of my knowledge. Iron pins set are 30"x 1" o.d. with orange plastic caps inscribed "PS 6579". The basis of bearings for the foregoing plat is from the Franklin County Engineer's road plans for Amity Road, Sec. B, Road no. 12, sheets 7, 8, & 9 of 40.

*Albert O. Myers*  
Albert O. Myers, Ohio Professional Surveyor no. 3352