

RECEIVED

SEP 30 2024

FRANKLIN COUNTY ENGINEER
BRAD FOSTER, P.E., P.S.

PENNSYLVANIA LINES LLC
I.N. 200212180325195
K.N.A. NORFOLK SOUTHERN
RAILWAY COMPANY
I.N. 200710280188473

$\Delta=4'00''11''$
 $R=2917.93'$
 $CB=N30'58'03''W$
 $CD=203.83'$
 $L=203.87'$



CERTIFICATION

I hereby certify that the information shown hereon was derived from field measurements and meets the requirements of OAC 4733-37 as setforth therein.

BY *David L. Chiesa*
David L. Chiesa
Registered Surveyor No. 7740


Date 9/19/24

**STATE OF OHIO, COUNTY OF FRANKLIN, CITY OF COLUMBUS
HALF SECTION 27, TOWNSHIP 5, RANGE 22, REFUGEE LANDS**

BEARING REFERENCE

BEARINGS HEREIN ARE BASED ON THE OHIO STATE PLANE COORDINATE SYSTEM, SOUTH ZONE, AND NAD 1983 (2011) AND ESTABLISHES A BEARING OF NORTH 19'48'07" WEST FOR SHORT STREET NORTH OF LIBERTY STREET.

CITY OF COLUMBUS, OHIO
7.986 ACRES

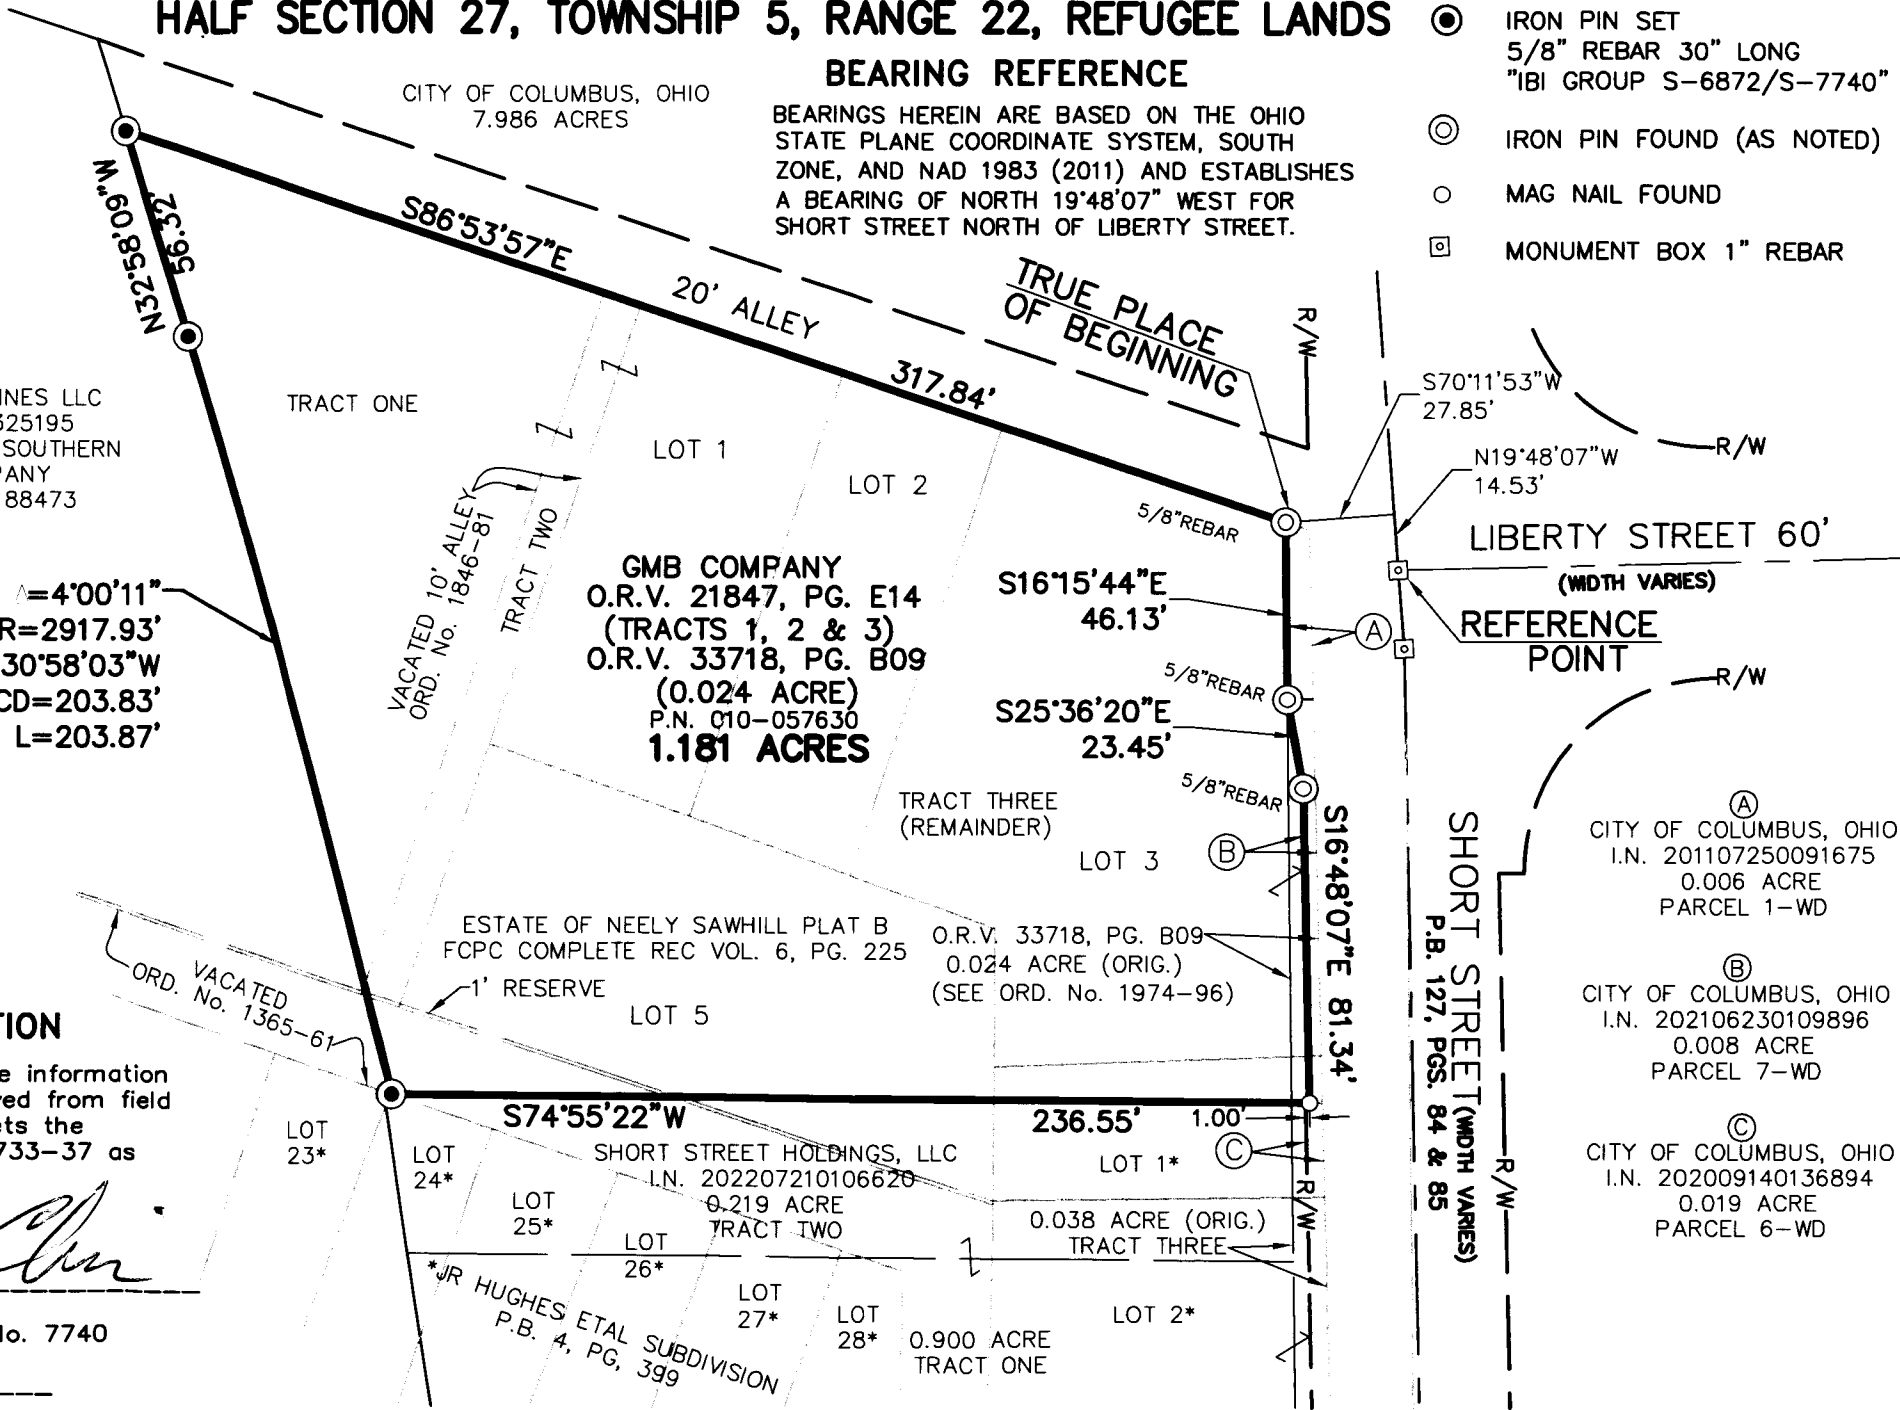

- LEGEND**
- ⊙ IRON PIN SET
5/8" REBAR 30" LONG
"IBI GROUP S-6872/S-7740"
 - ⊙ IRON PIN FOUND (AS NOTED)
 - MAG NAIL FOUND
 - ⊠ MONUMENT BOX 1" REBAR

ARCADIS
8101 North High Street, Suite 100
Columbus OH 43235 USA
tel 614 818 4900 fax 614 818 4901
arcadis.com

**GMB COMPANY
SURVEY EXHIBIT**
525 SHORT STREET
COLUMBUS, OHIO

- Ⓐ CITY OF COLUMBUS, OHIO
I.N. 201107250091675
0.006 ACRE
PARCEL 1-WD
- Ⓑ CITY OF COLUMBUS, OHIO
I.N. 202106230109896
0.008 ACRE
PARCEL 7-WD
- Ⓒ CITY OF COLUMBUS, OHIO
I.N. 202009140136894
0.019 ACRE
PARCEL 6-WD

