Myers Surveying Company, Inc.

2740 East Main Street, Columbus 43209 (Bexley), Ohio

614-235-8677 FAX:614-235-4559

A Boundary Survey prepared for and certified to:

Kamari Odai

Legal Description: Situated in The State of Ohio, County of Franklin, City of Columbus, Being Lot 10, Levi R. and High E. Smith Woodland Park Addition, Plat Book 7, Page 132, and a 0.069 Acres Tract (formerly 20' Alley- Ord. No. 0673-2006)

Applicant/Owner: Asbury North United Methodist Church

Posted Address: 1566 & 1568 Clifton Avenue, Columbus, Ohio - PID 010-003762

FEMA Flood Zone Designation: Zone "X" as per F.I.R.M. 390170 0327 K

Exhibit B

20' 10' 0' 20'

Scale 1" = 20'

Date: 08/08/2023

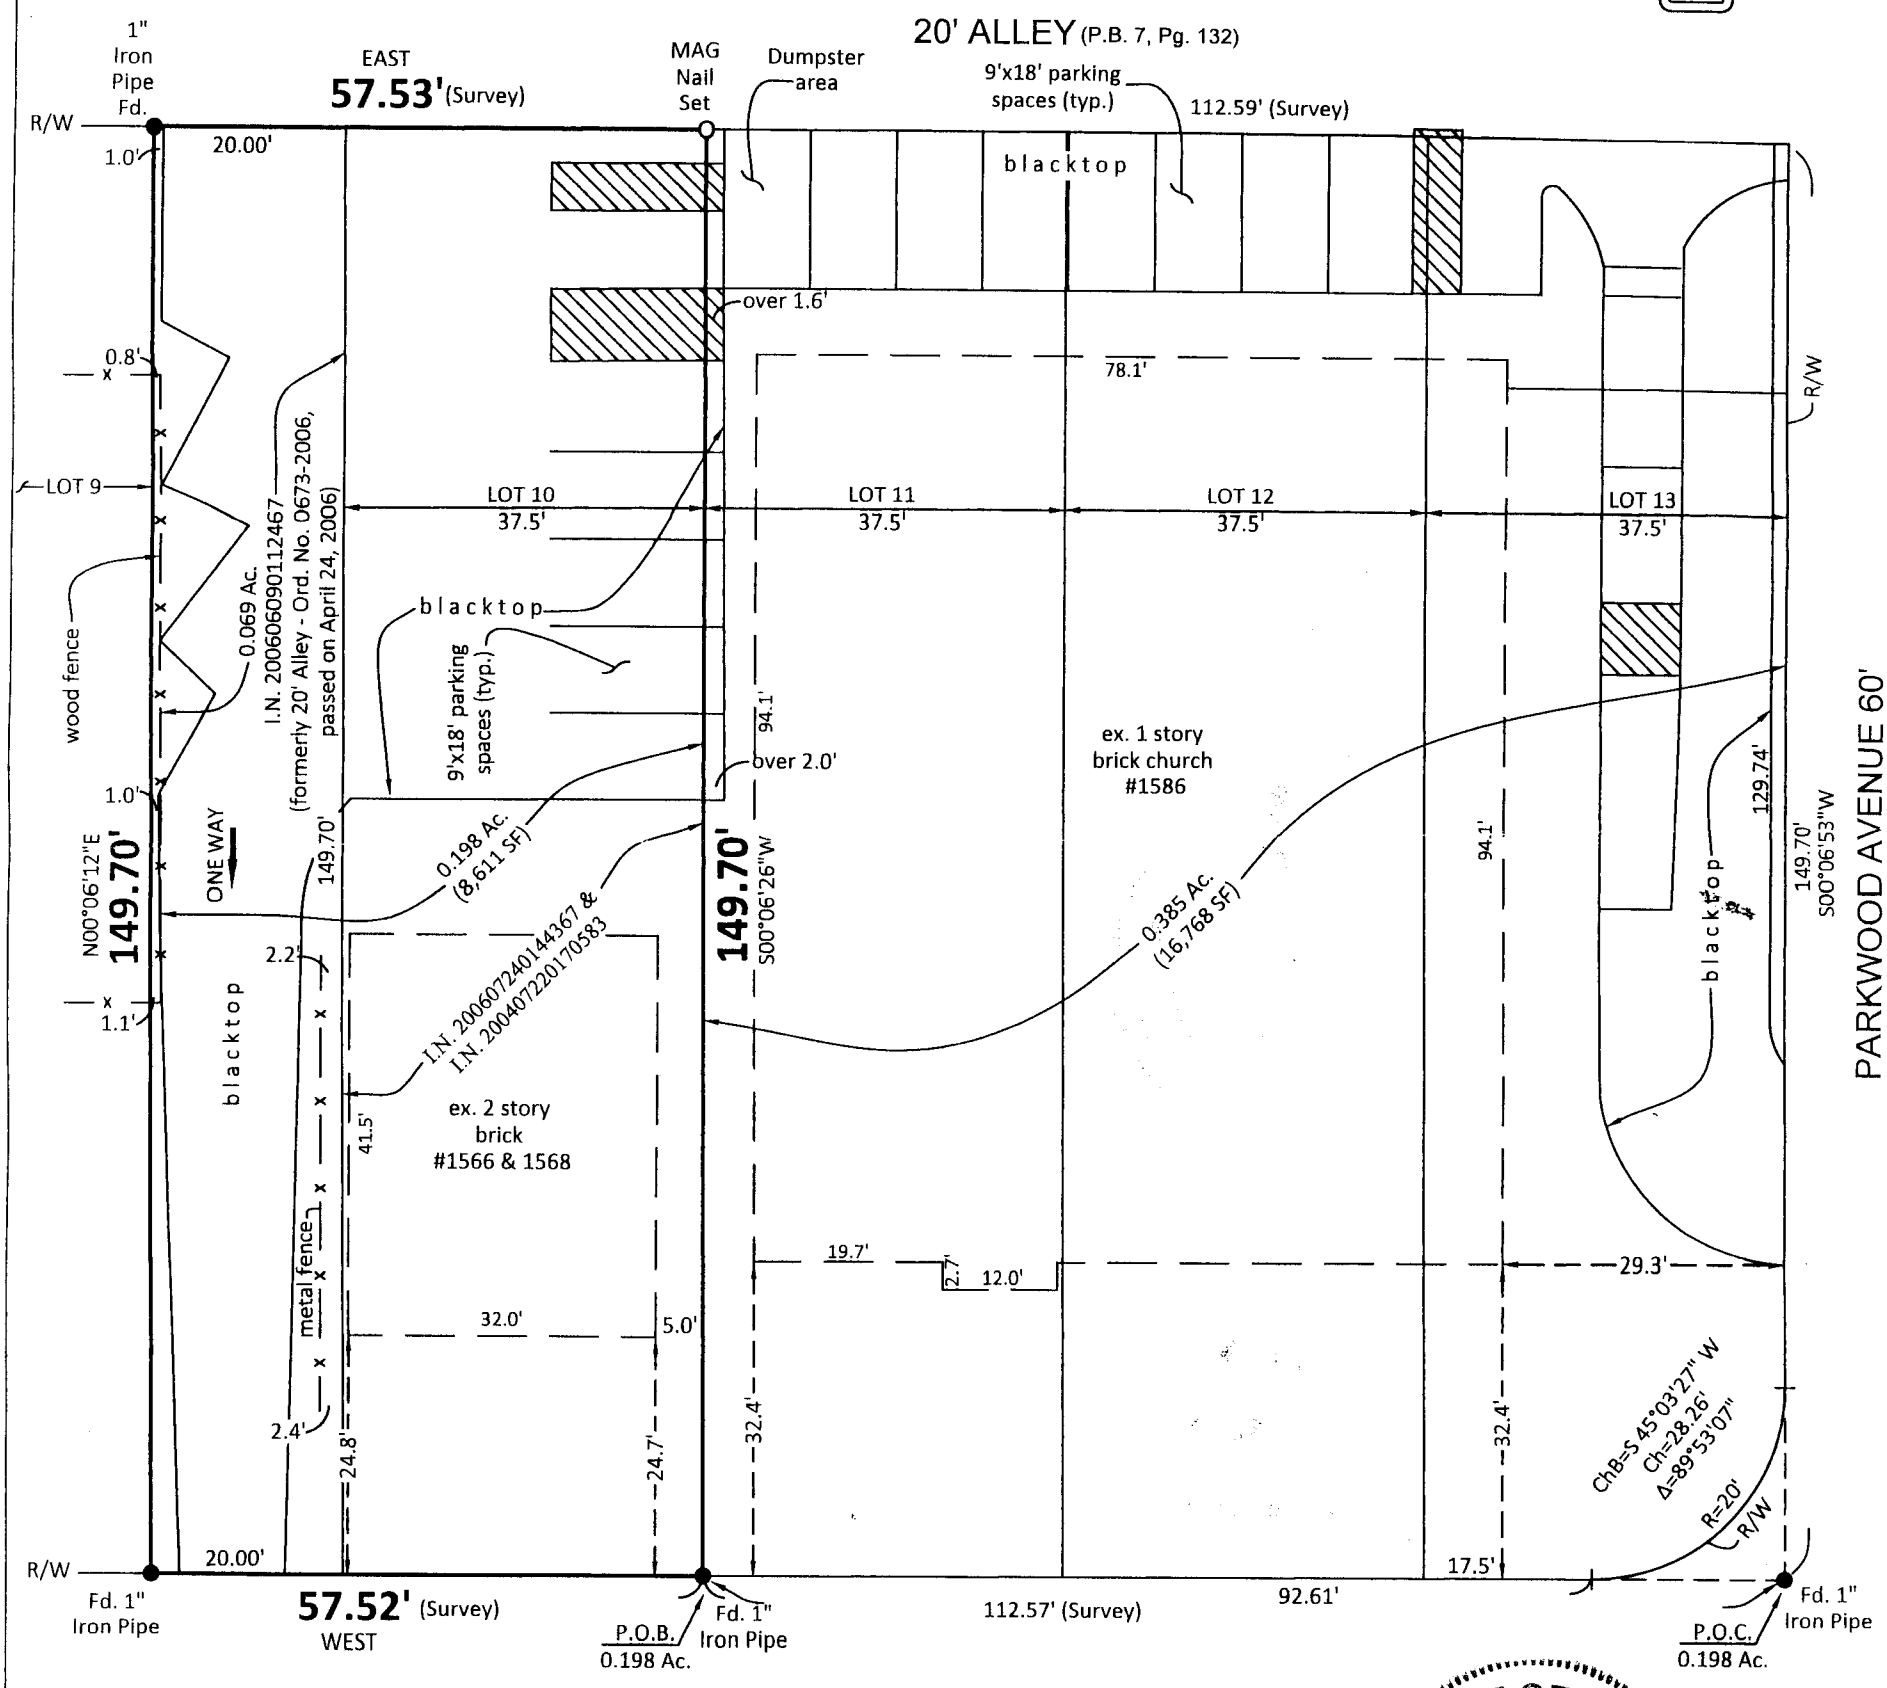

CLIFTON AVENUE 50'

(P.B. 7, Pg. 132)

RECEIVED

JUN 10 2025

FRANKLIN COUNTY ENGINEER
ADAM W. FOWLER, P.E., P.S.

STATE OF OHIO
JOSEPH P. MYERS
7361
REGISTERED
PROFESSIONAL SURVEYOR

Myers Surveying Co., Inc

By _____

6-6-2023

Professional Surveyor

We hereby certify that the foregoing Boundary Survey was prepared from actual field measurements in accordance with Chapter 4733-37 Ohio Administrative Code. Iron pipes set are 30"x1" O.D. with an orange plastic plug inscribed "MYERS P.S. 6579", unless otherwise noted. Basis of bearings is the north line of Clifton Avenue, held as WEST per I.N 200606090112467.

Myers Order No.-5-02/14/2023	Rec.	Field	DWG.	Ltr.	Ck.