

M.H. #1 18" Storm T.C. = 763.02  
 INV. = 754.82 IN  
 INV. = 756.72 OUT  
 INV. = 758.72 IN 8' from C.B.


M.H. #3 Water Meter Pit  
 T.C. = 762.07

M.H. #2 8" San. T.C. = 759.32  
 INV. = 752.05 IN  
 INV. = 750.27 OUT

M.H. #4 8" San. T.C. = 765.39  
 INV. = 754.34 IN  
 INV. = 754.82 OUT

Y.D. #4 (See Site Utilities Sheet SU-1)  
 T.C. = 762.53  
 INV. = 759.67 IN  
 INV. = 758.58

1 STORY BRICK MEDICAL BUILDING  
 (Heinzerling Memorial Foundation)  
 FF West Ent. Elev. = 767.04'

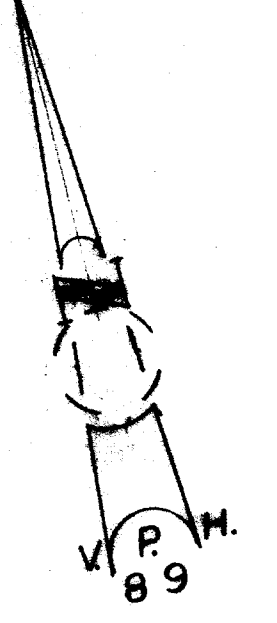

Plot showing a topographic survey of the north part of a 21661 Ac. tract @ 1800 Heinzerling Memorial Drive, Columbus, Ohio.

For: Calabretta Partners Architects

Scale: 1"=30'

January 11, 1989

*Harry L. Greene*  
 Harry L. Greene, Reg. Surveyor No. 4058