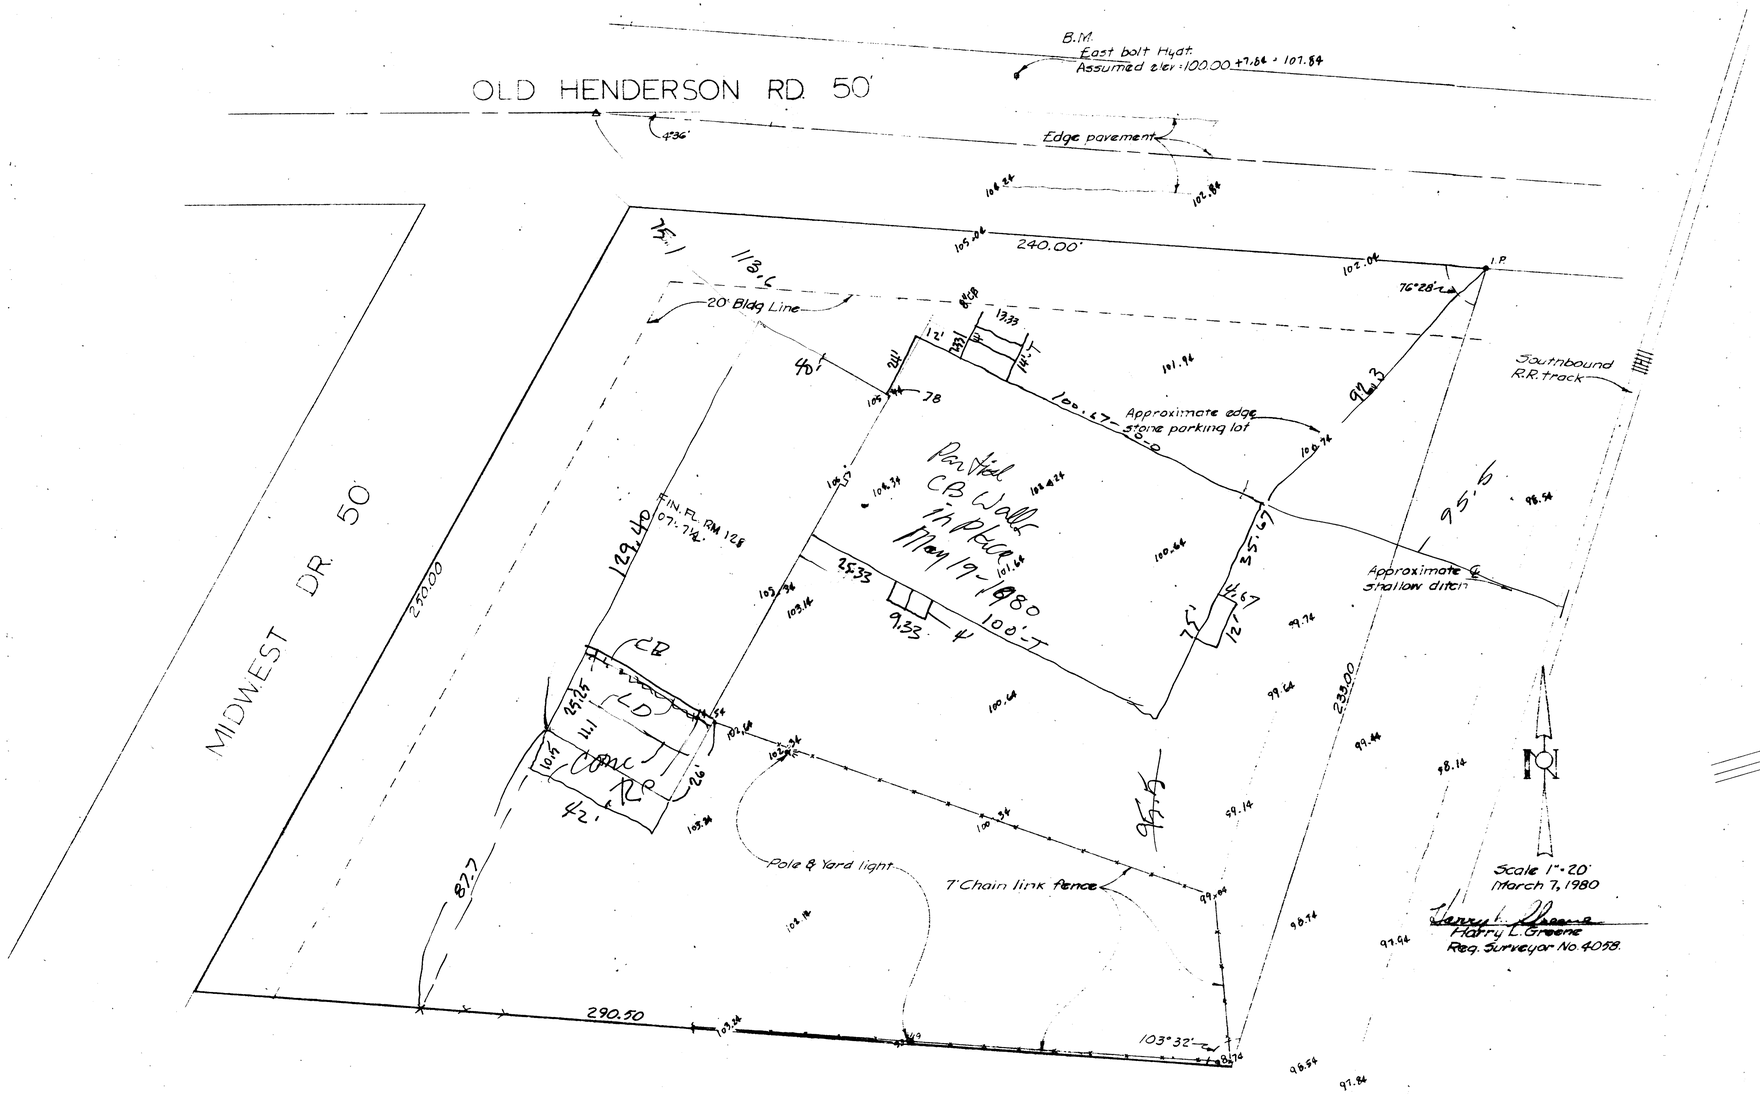
OLD HENDERSON RD. 50'
B.M.
East bolt Hydt.
Assumed elev.: 100.00 + 7.84 = 107.84
Edge pavement
240.00'
I.P.
76°28'
20' Bldg Line
Southbound R.R. track
Approximate edge stone parking lot
Approximate ℄ shallow ditch
Partial C.B. Walk in place May 19-1980
FIN. FL. RM 128
07.7½
MIDWEST DR. 50'
290.00
290.50
103°32'
Pole & Yard light
7' Chain link fence
Scale 1" = 20'
March 7, 1980
Harry L. Greene
Reg. Surveyor No. 4058.