
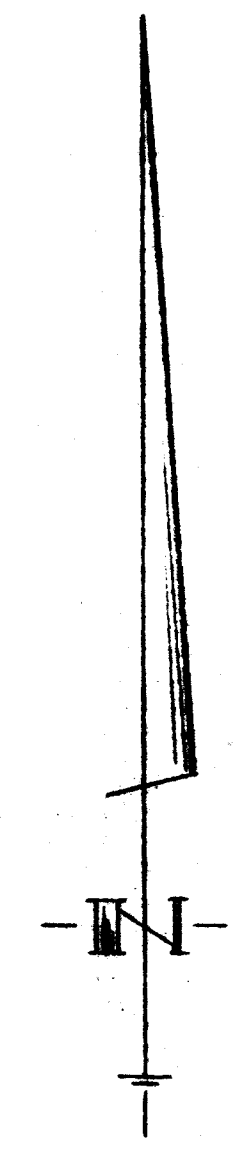


LOT 4  
DAVIS-HENDERSON ROAD SUBDIVISION  
P.B. 29, Pgs. 69

HENDERSON ROAD

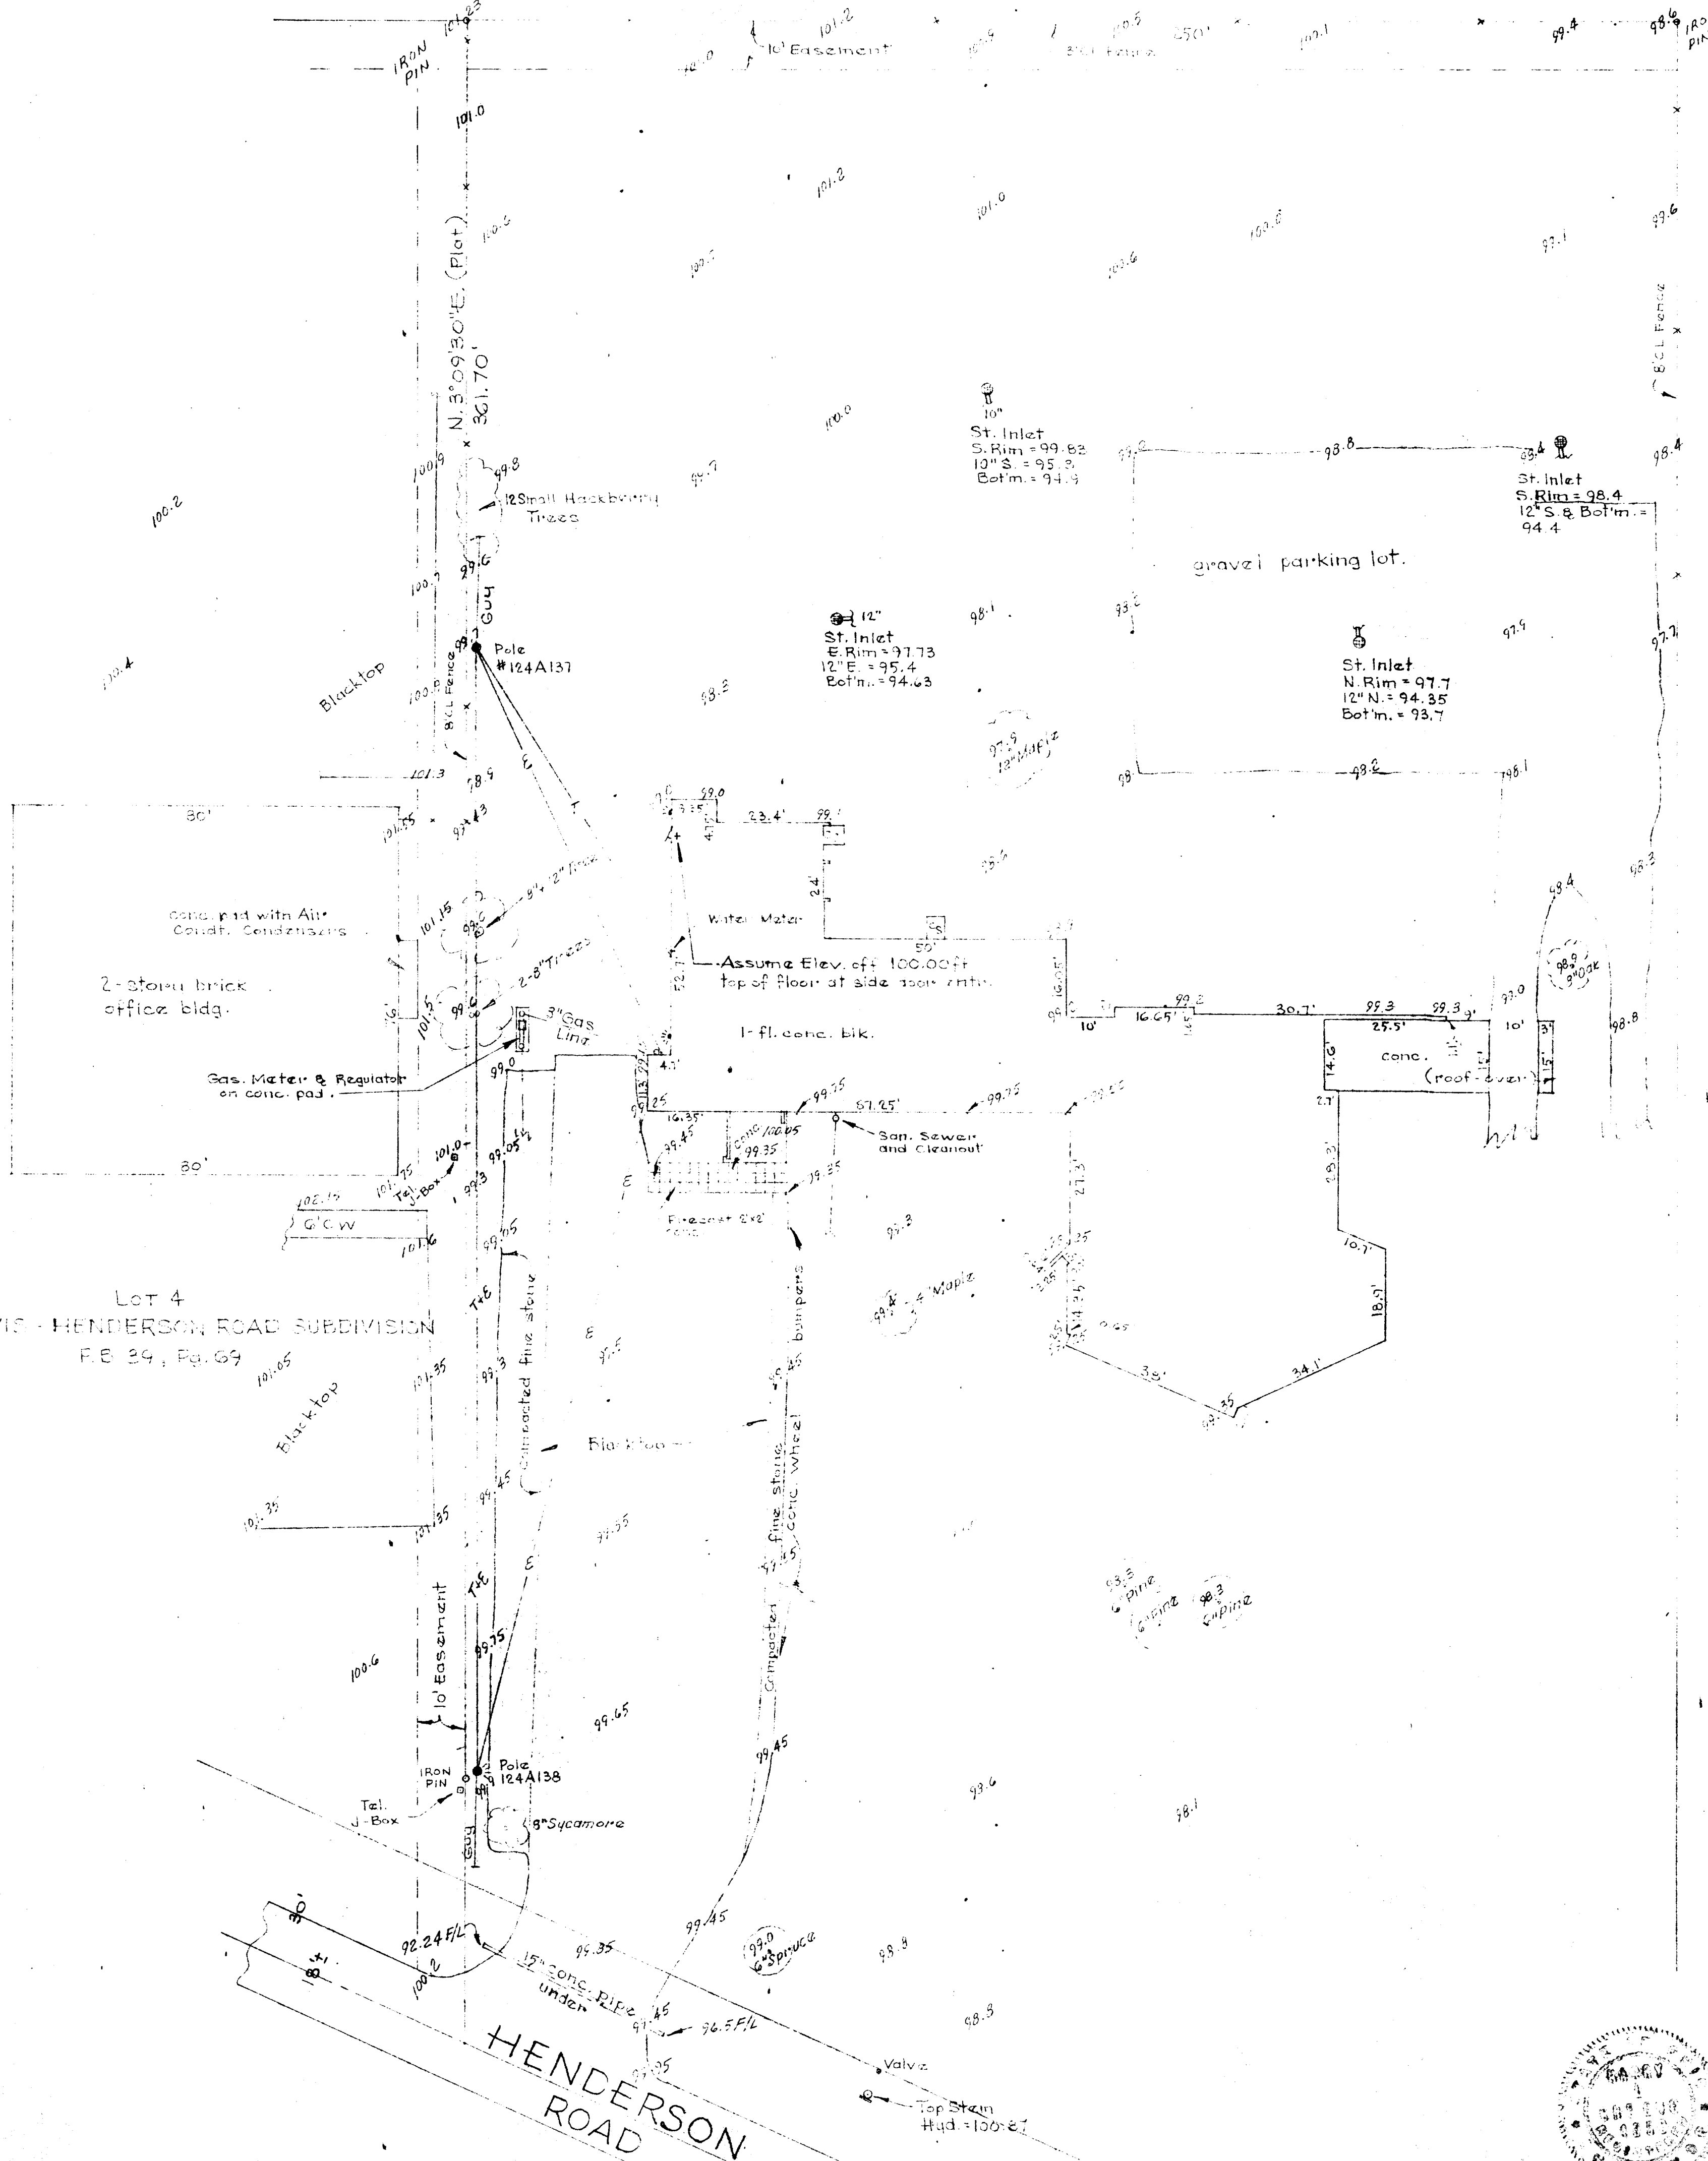

Survey showing property of the North Congregational Church  
Columbus, Ohio, situated in the City of Columbus, Franklin County, Ohio  
Deed Book 2014, Pgs. 116, 121 & 123. (Church Bldg., Lot)

Nov. 6, 1978

Scale 1" = 20'



Harry L. Greene  
Harry L. Greene, Reg. Surveyor - 4058