


B.M. - P.K. Spika, south side
Buckeye Tree, Assumed Elev.
of 100.00 ft.

A-A' not determined.

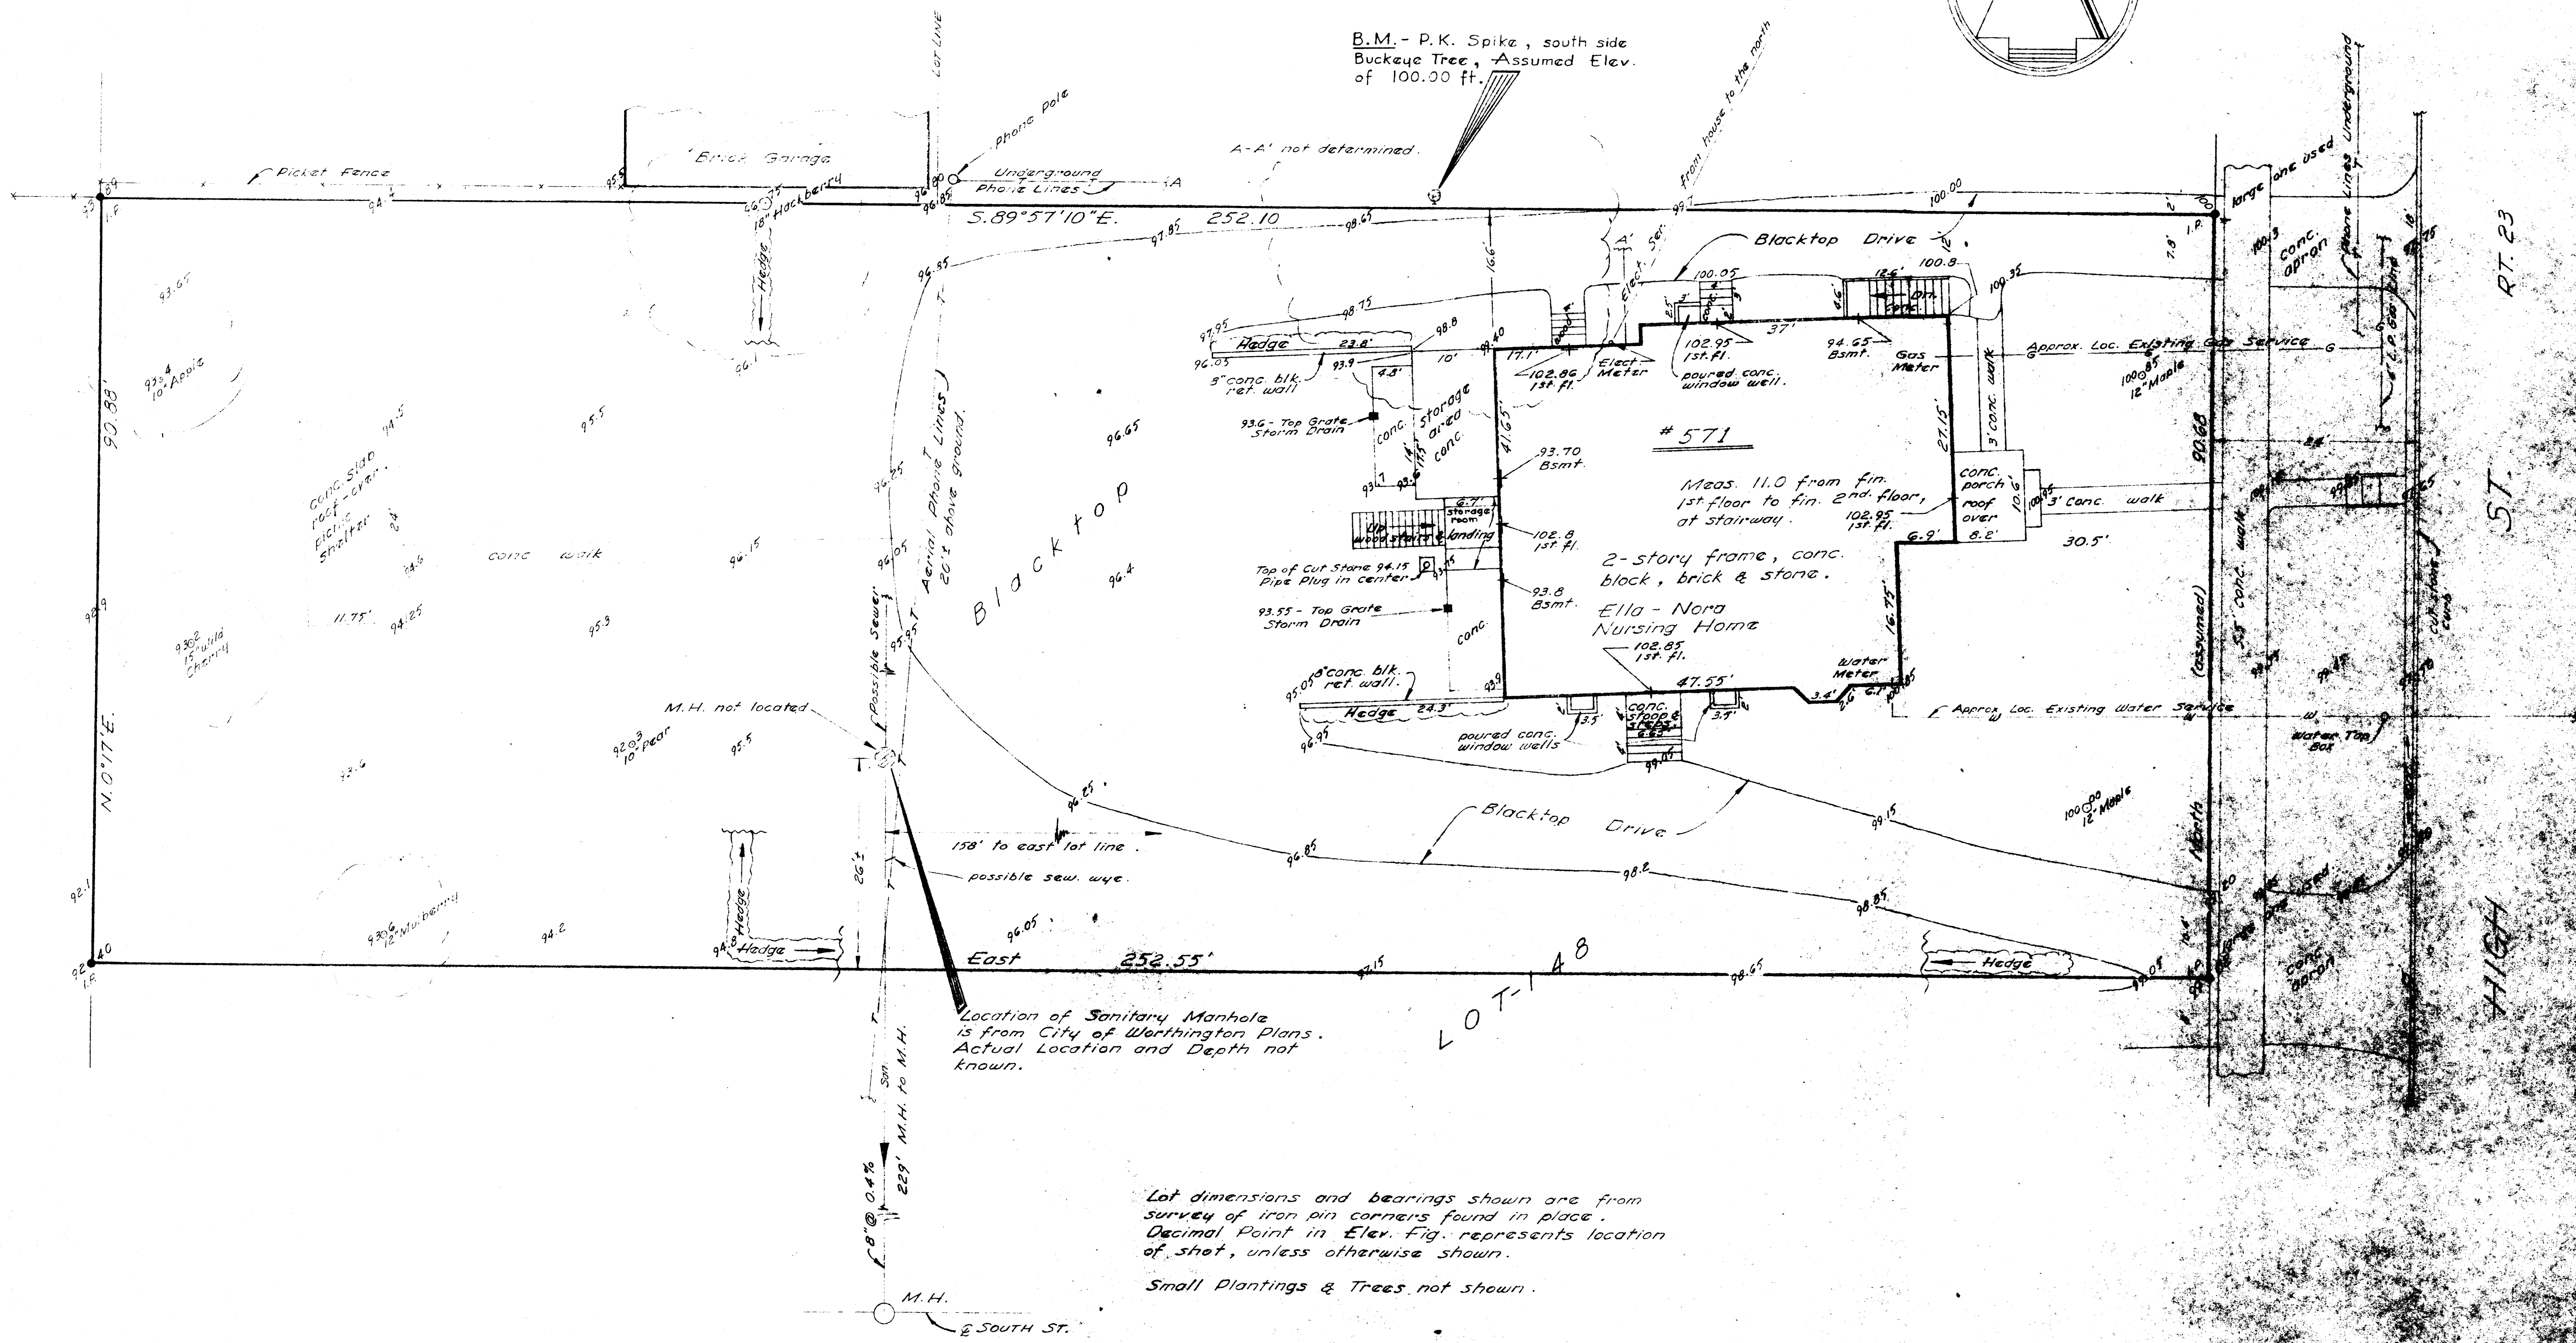


NOTE

Location of Sanitary Manhole
is from City of Worthington Plans.
Actual Location and Depth not
known.

Lot dimensions and bearings shown are from
survey of iron pin corners found in place.
Decimal Point in Elev. Fig. represents location
of shot, unless otherwise shown.

Small Plantings & Trees not shown.

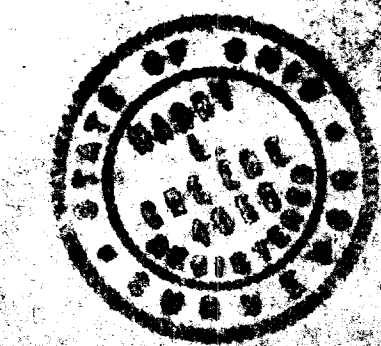

Harder & Kinchelo -
January 26 - 1967
Harry L. Kinchelo
Surveyor