


Apt. Bldg.

N0° 24' W 236.00

Iron Pin

Iron Pin

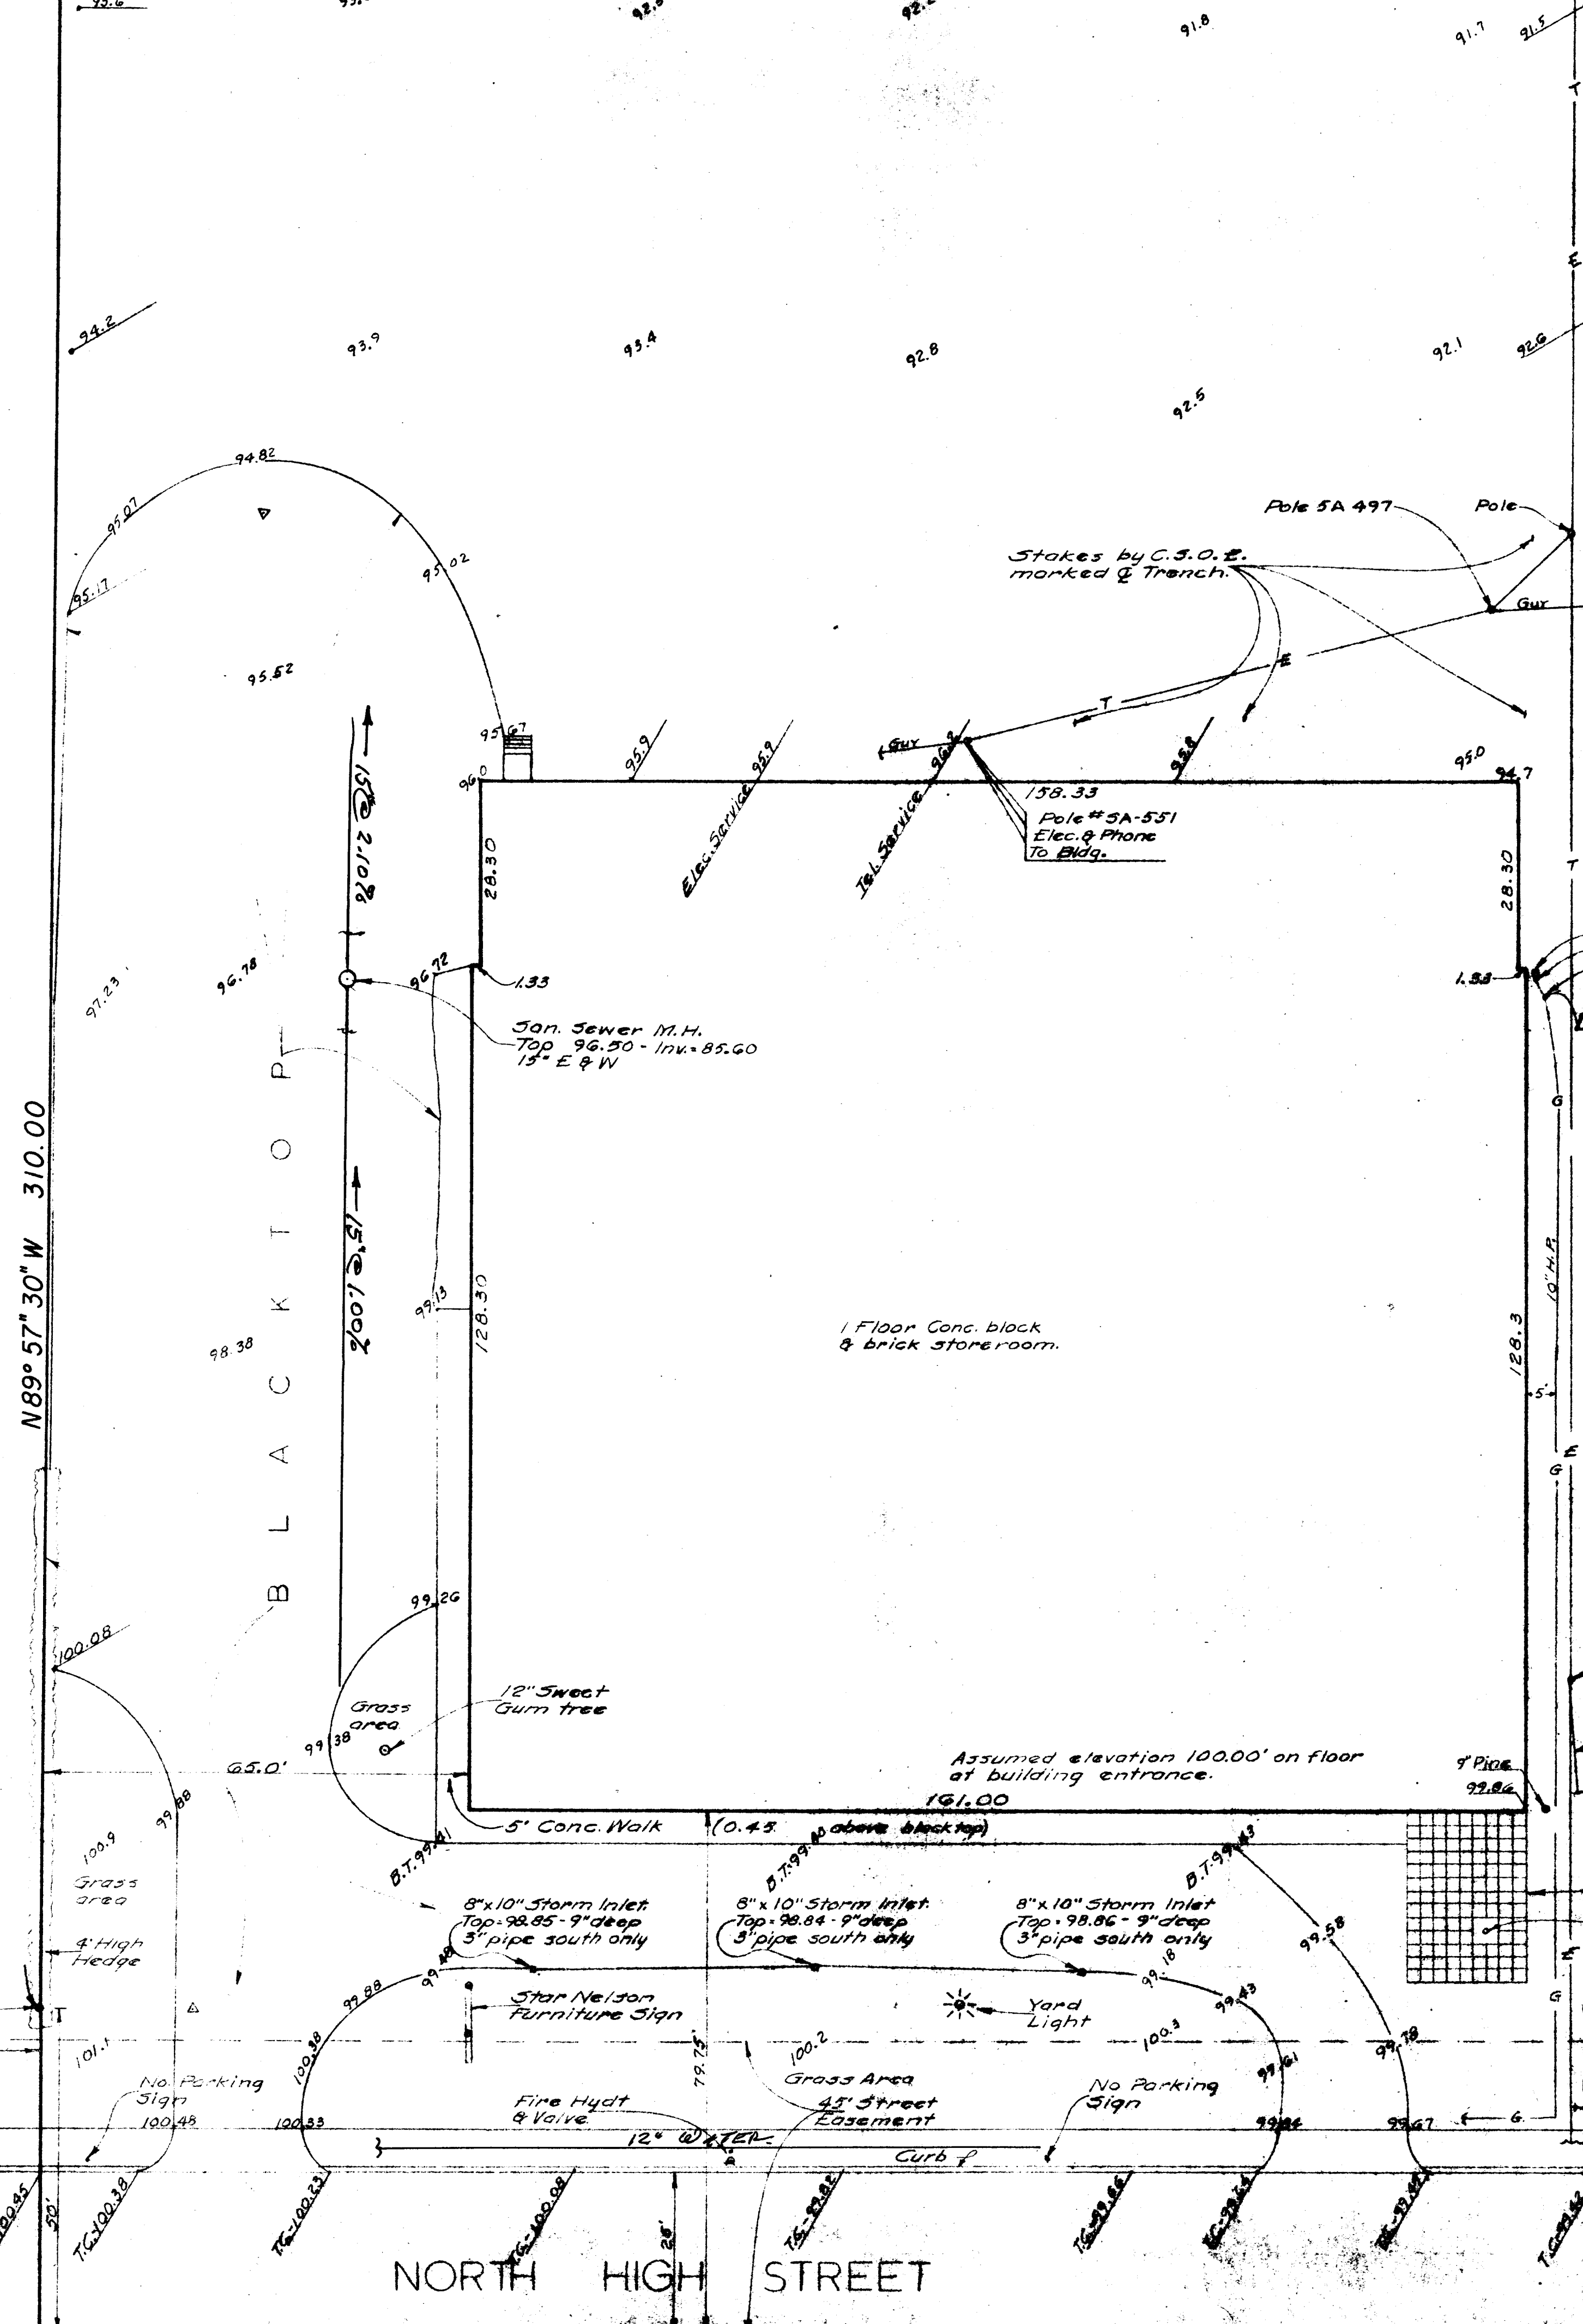

PLAT SHOWING SURVEY & TOPS OF 1.950 ACRES, LOCATED AT 5455 NORTH HIGH STREET, CITY OF COLUMBUS, OHIO.

for
Goal Systems International

Scale 1/4" = 1'

Aug. 10, 1981

James L. Greene
Harry L. Greene, Reg. Surveyor No. 4058