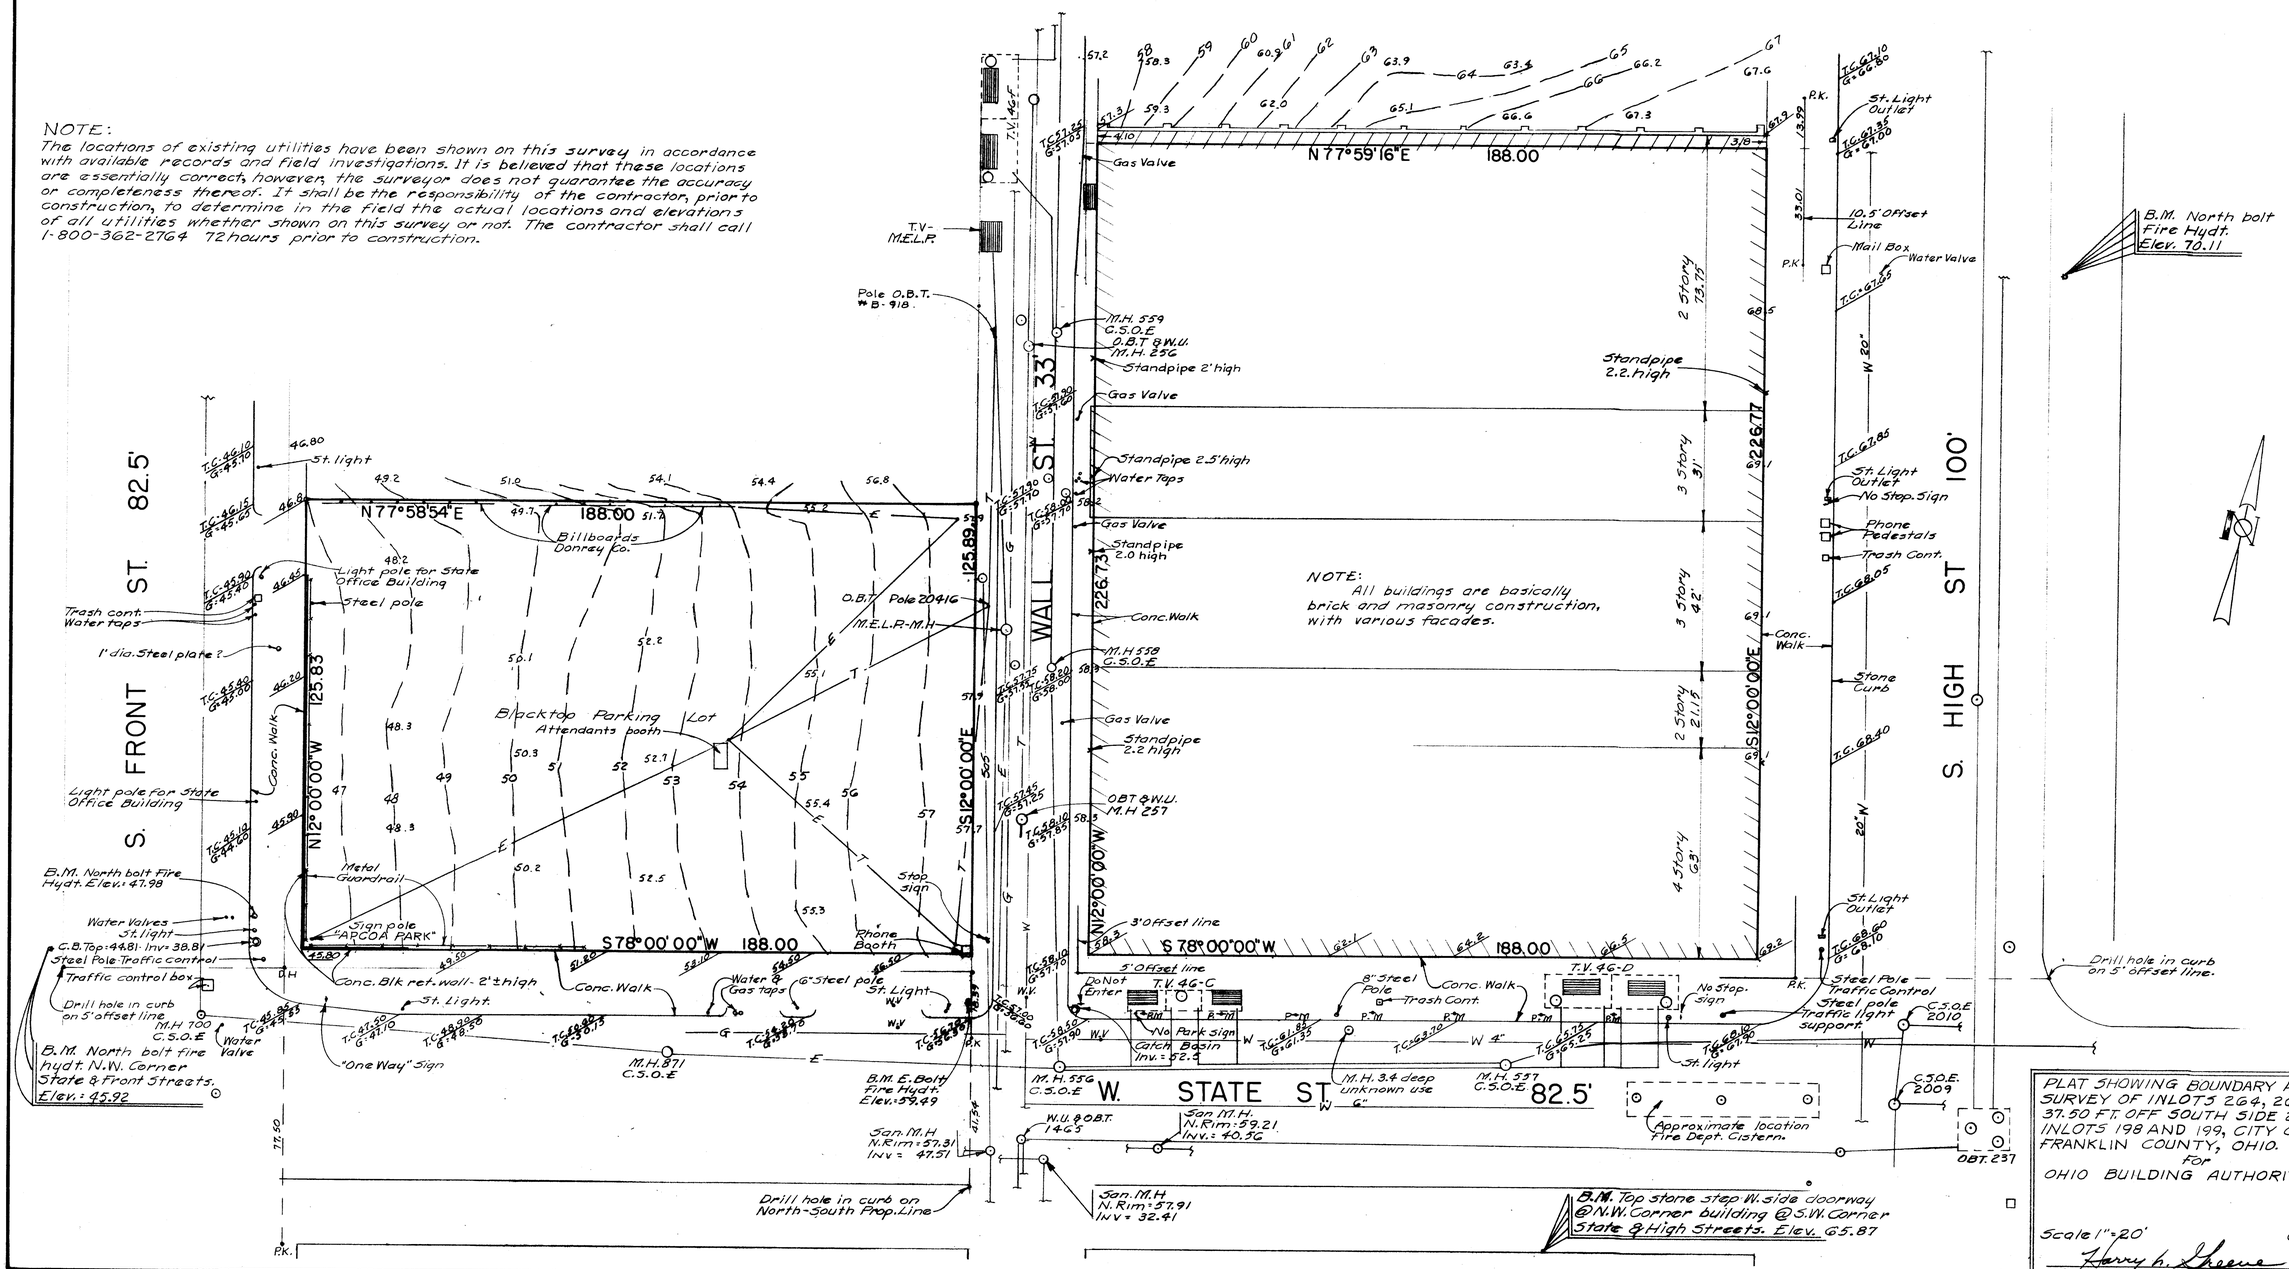NOTE:
The locations of existing utilities have been shown on this survey in accordance with available records and field investigations. It is believed that these locations are essentially correct, however, the surveyor does not guarantee the accuracy or completeness thereof. It shall be the responsibility of the contractor, prior to construction, to determine in the field the actual locations and elevations of all utilities whether shown on this survey or not. The contractor shall call 1-800-362-2764 72 hours prior to construction.