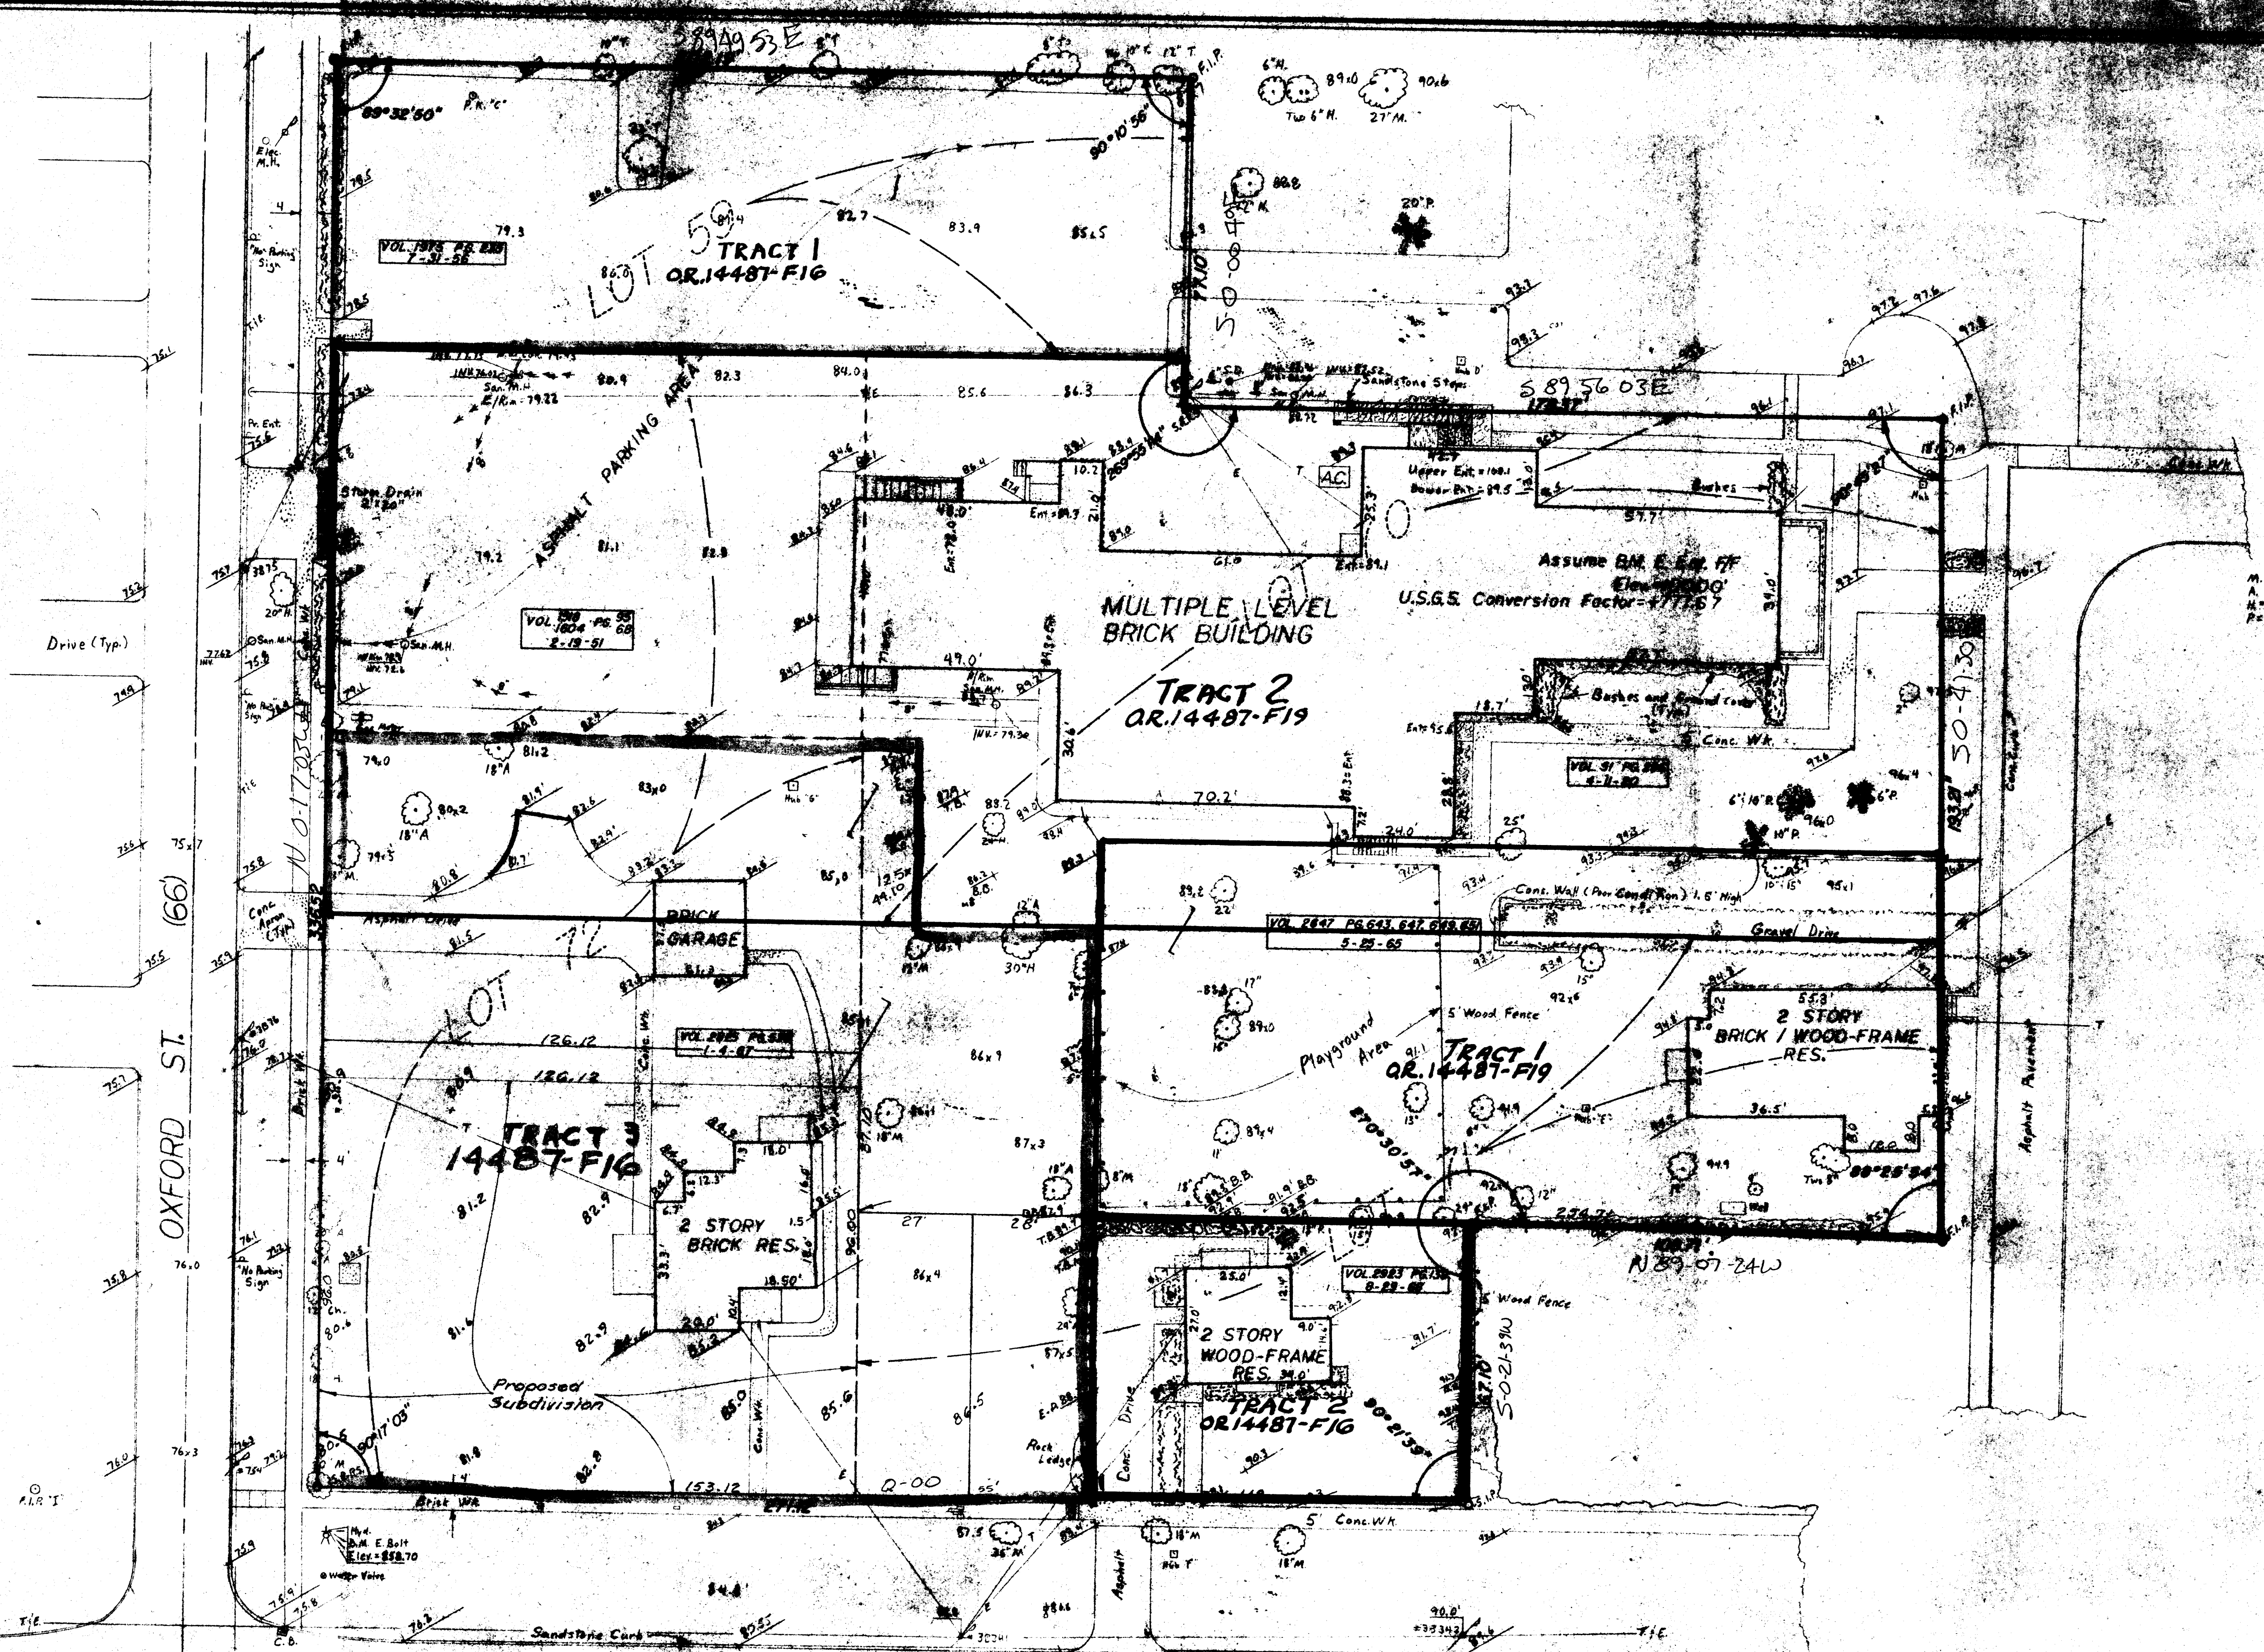


(ASSUME)

Boundary establish from existing lot corners.
F.I.R. = Found iron pin
S.I.P. = Set iron pin
S.R.R.S. = Set railroad spike

For Conversion to U.S.S. Datum
Add 77.267

NOTE:
All church parcels
to be combined.

Plat showing As-Built, Topo, and Boundary Survey of Lot
71, and parts of Lots 70, and 59, as shown in Plat Book
1 Page 230, City of Worthington, Franklin County, Ohio.

For Worthington Presbyterian Church and Society

Scale: 1" = 20'
December 7, 1928
Revised July 24, 1929

Harvey L. Greene, Reg. Surveyor No. 9055