


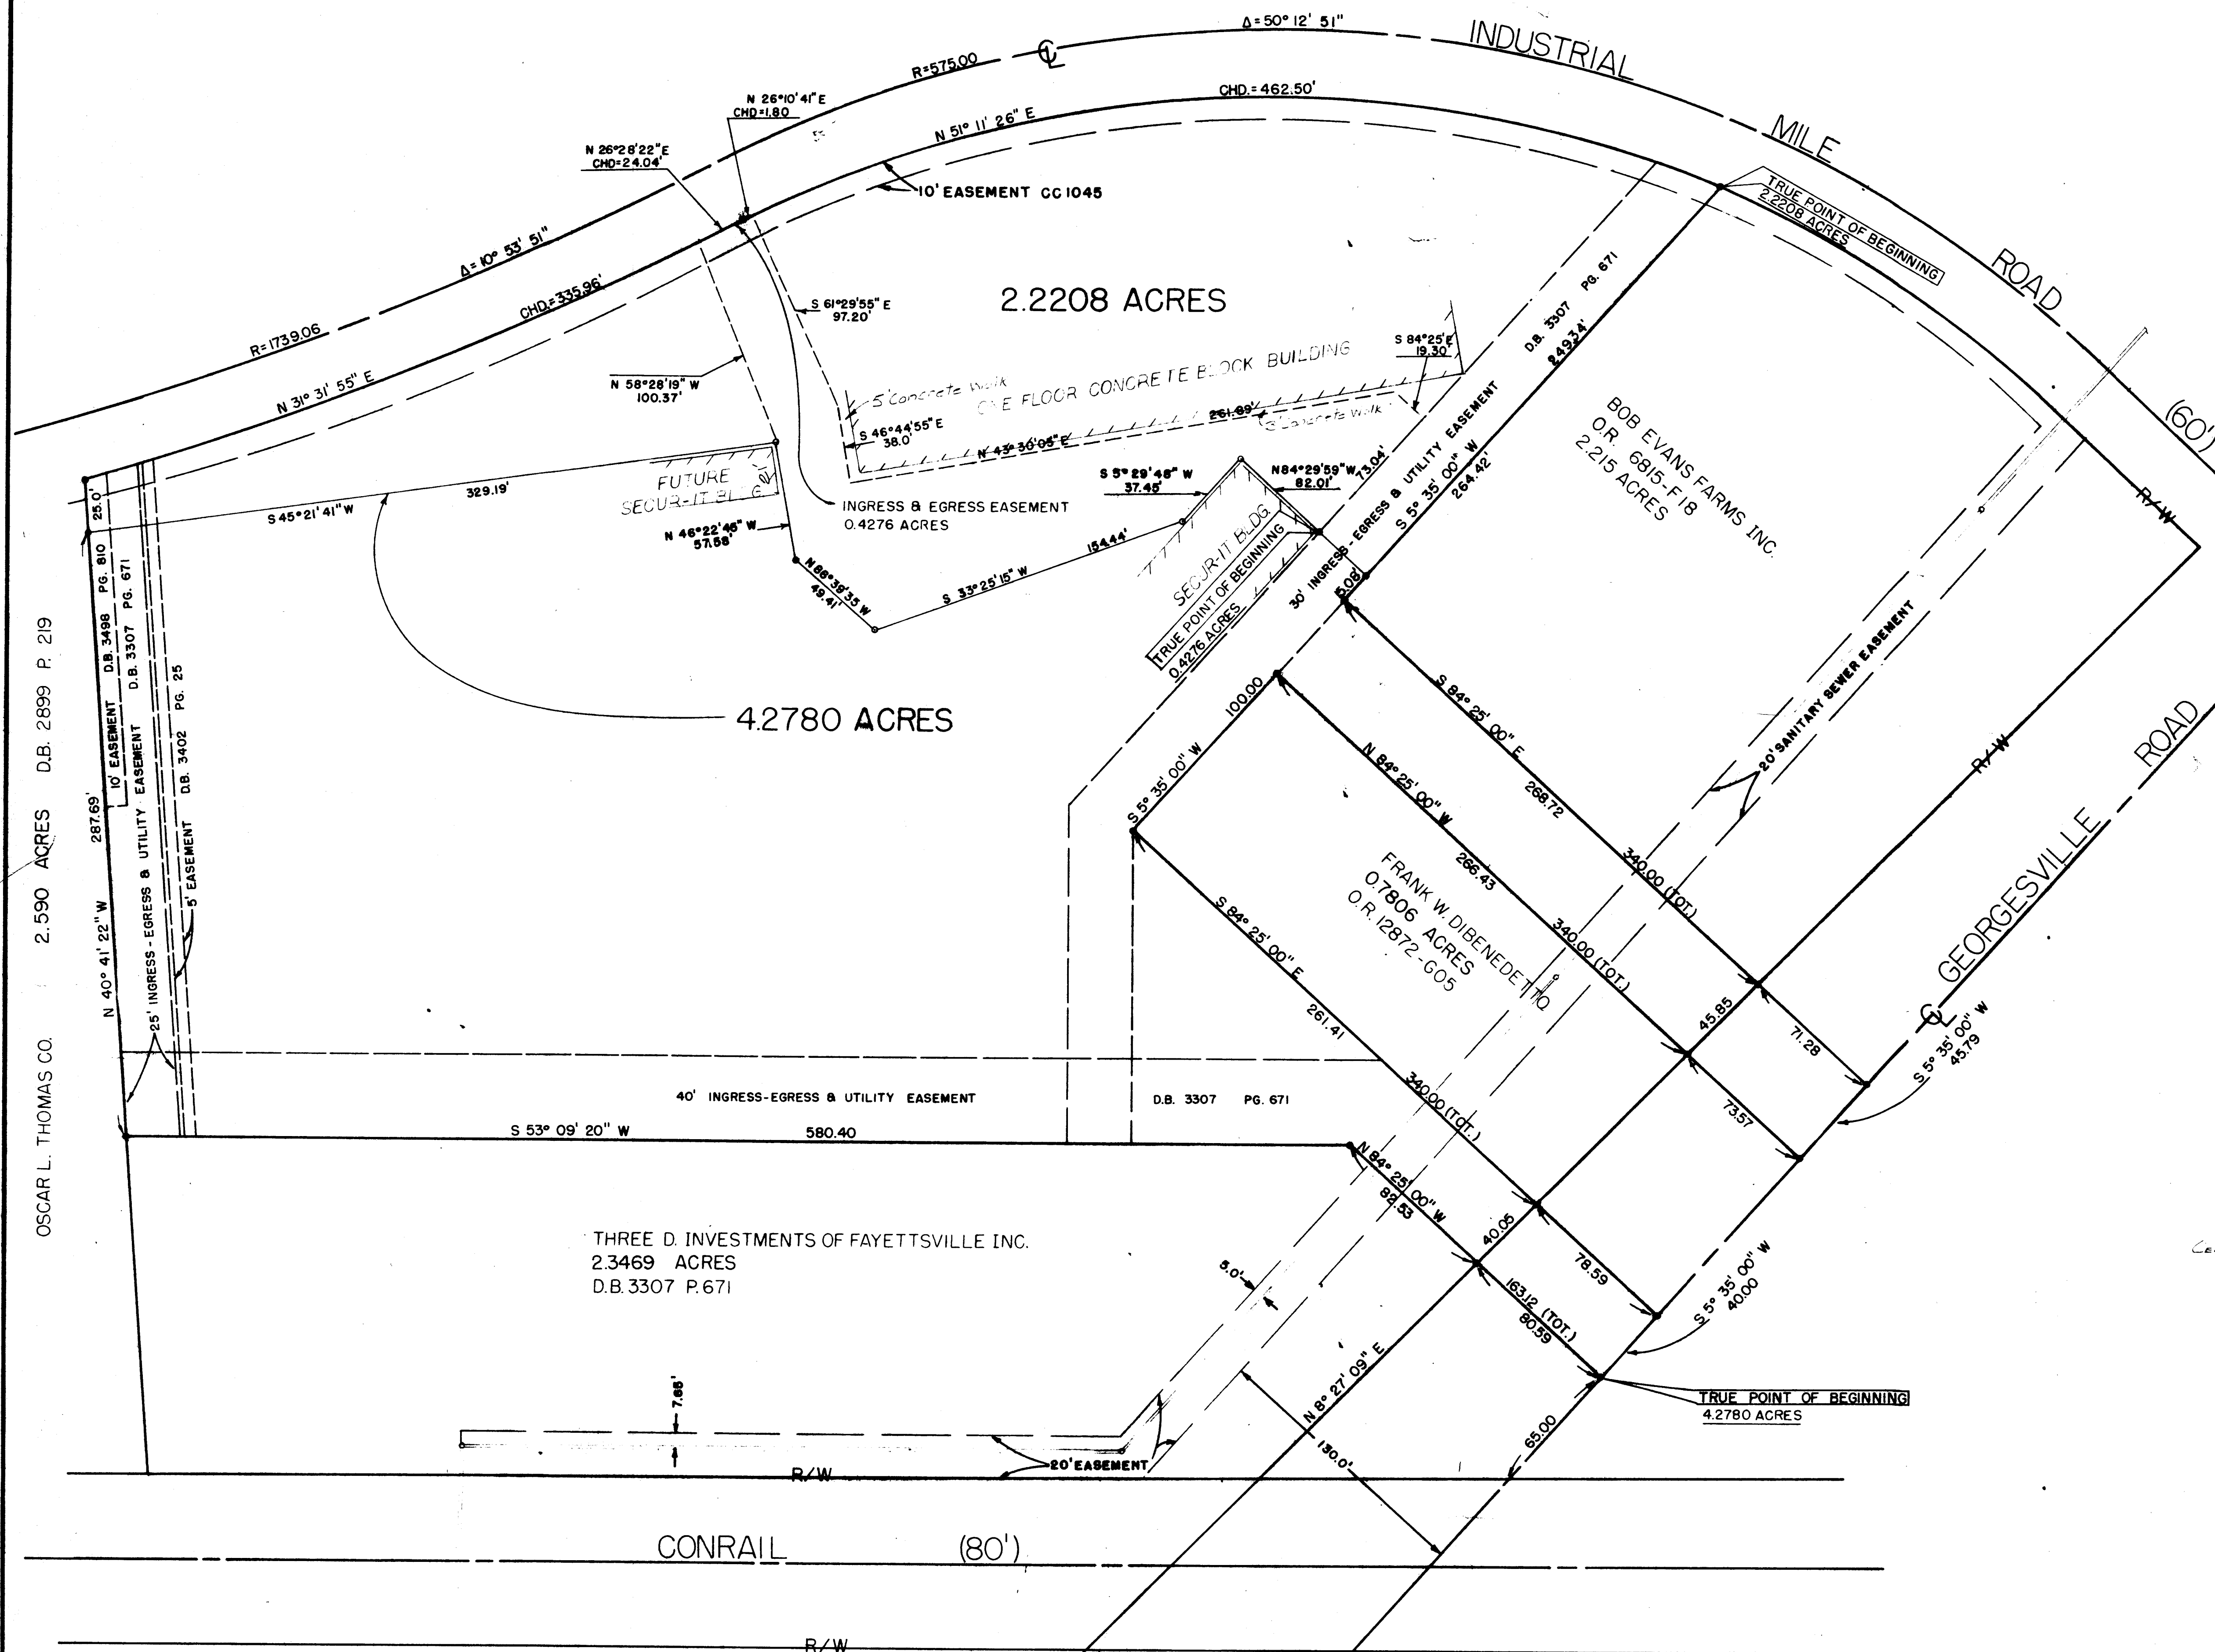

CERTIFIABLE TO: GEORGETOWN STORAGE ASSOCIATES,
STATE SAVINGS BANK, AND THE OHIO BAR TITLE INSURANCE CO.
Re: G.4987 HEREIN SITUATED IN FRANKLIN COUNTY, OHIO.

I hereby certify the above plat has been prepared from actual survey of the premises. ALL DIMENSIONS SHOWN IN FEET AND DECIMAL FEET THREE OF DIMENSIONS SHOWN ALONG CURVES ARE GROUND MEASUREMENTS.

**PLAT SHOWING SURVEY OF A 6.4987 ACRE TRACT CONVEYED TO
GEORGESVILLE STORAGE ASSOCIATES BY DEED OF RECORD IN OFFICIAL
RECORDS 9616-C02, RECORDER'S OFFICE, FRANKLIN COUNTY OHIO.**

SCALE: 1" = 40'
APRIL 29, 1987
Revised April 25, 1988
REVISED TO SHOW 2.2208 AC. & 4.2780 AC.
AUGUST 28, 1989

HARRY L. GREENE
HARRY L. GREENE, REGISTERED SURVEYOR - NO. 4098