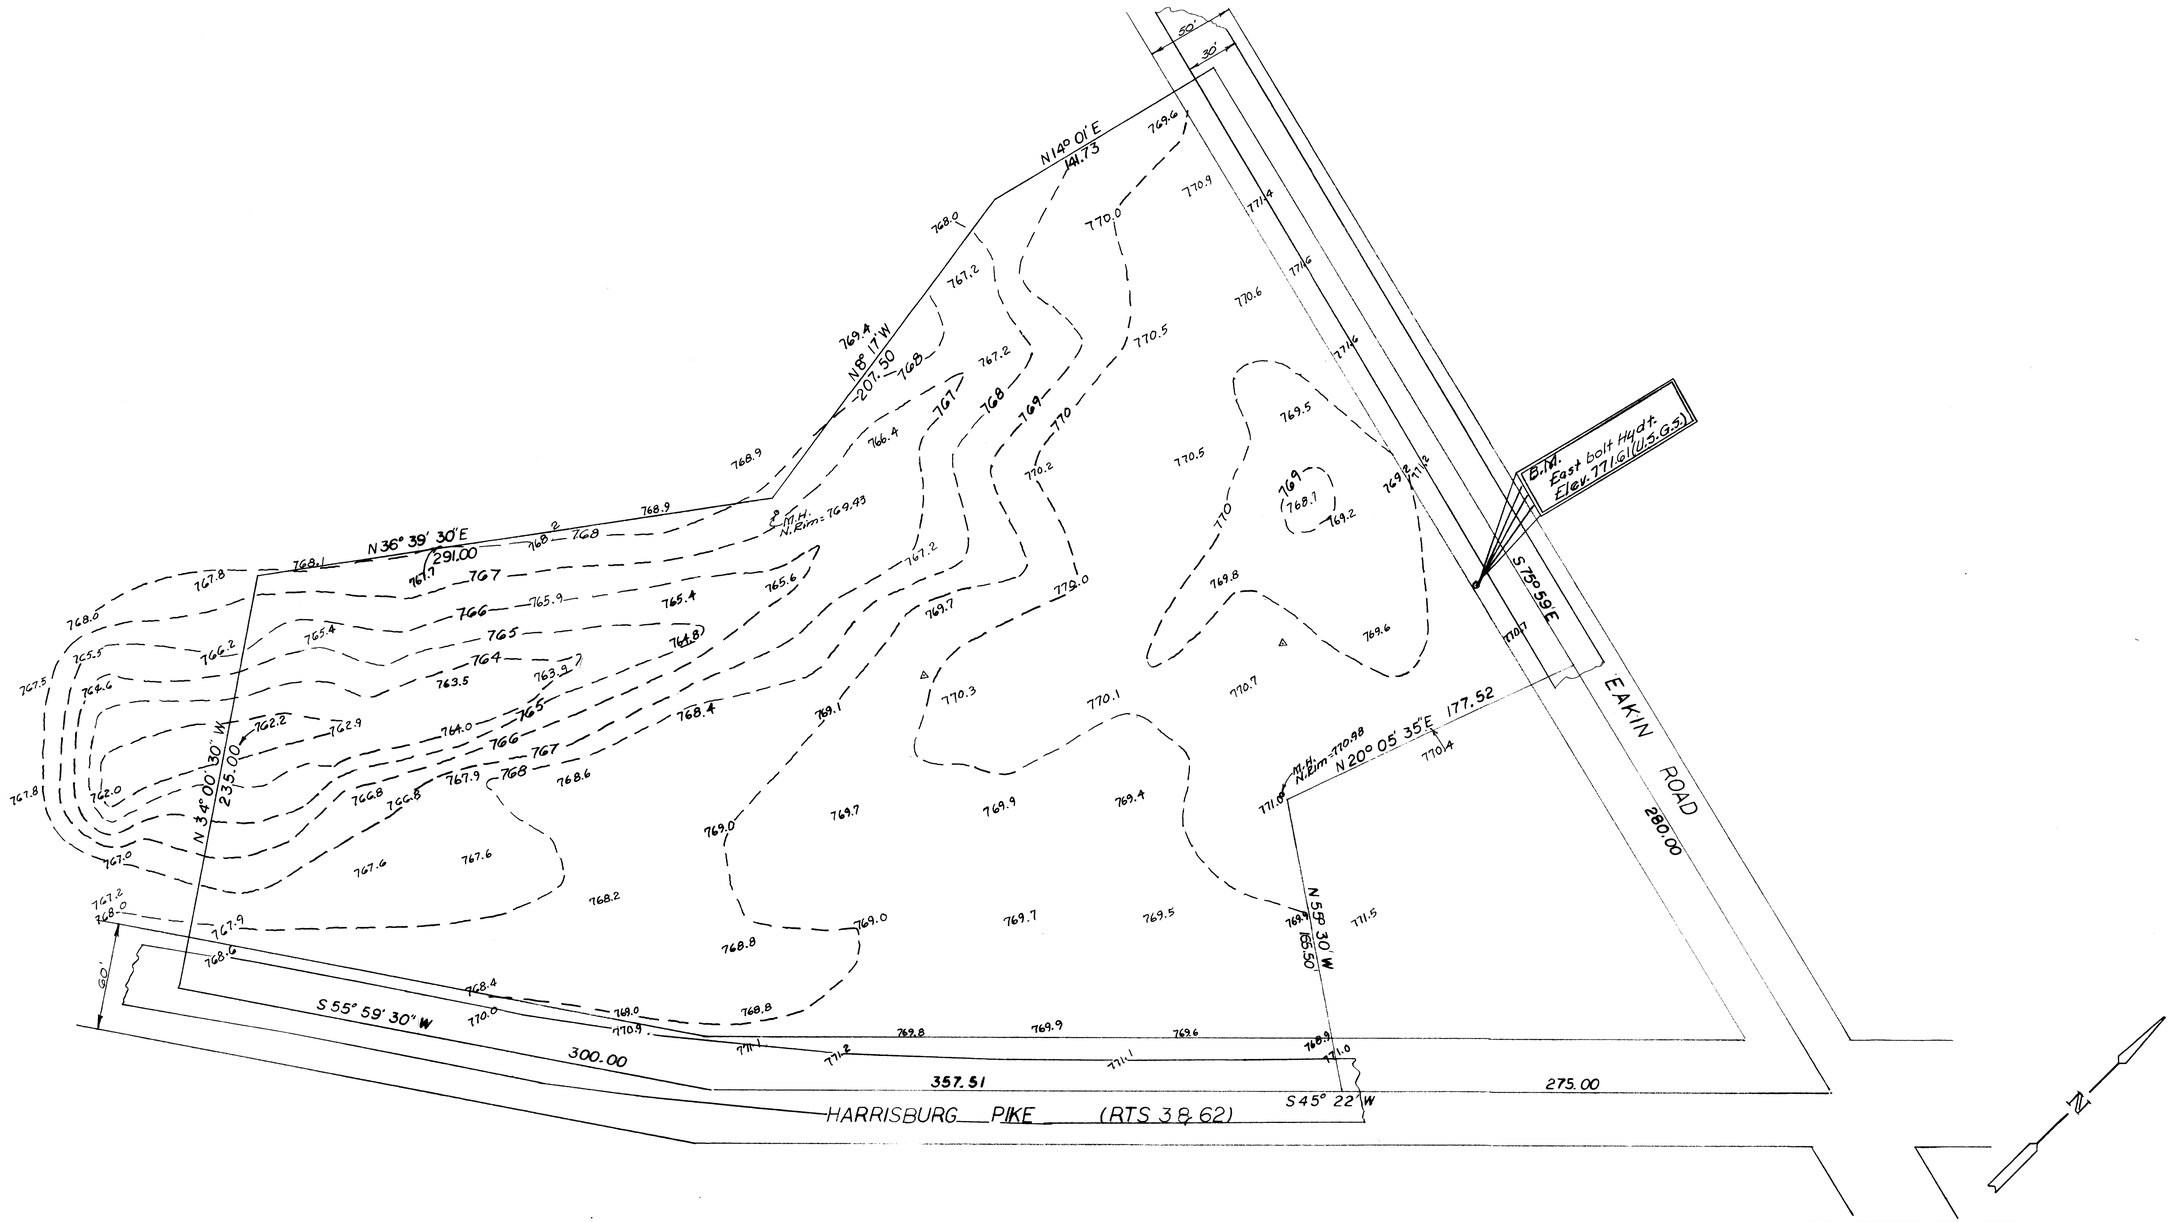

TOPOGRAPHIC SURVEY
HARRISBURG PIKE AND EAKIN ROAD
FOR
SKIP YASSENOFF
JANUARY 22, 1986 SCALE 1"=40'

Harry L. Greene
HARRY L. GREENE REG. SURVEYOR No. 4058

57-A