HARRY L. GREENE, SURVEYOR
2160 TREMONT CENTER, COLUMBUS, OHIO 43221

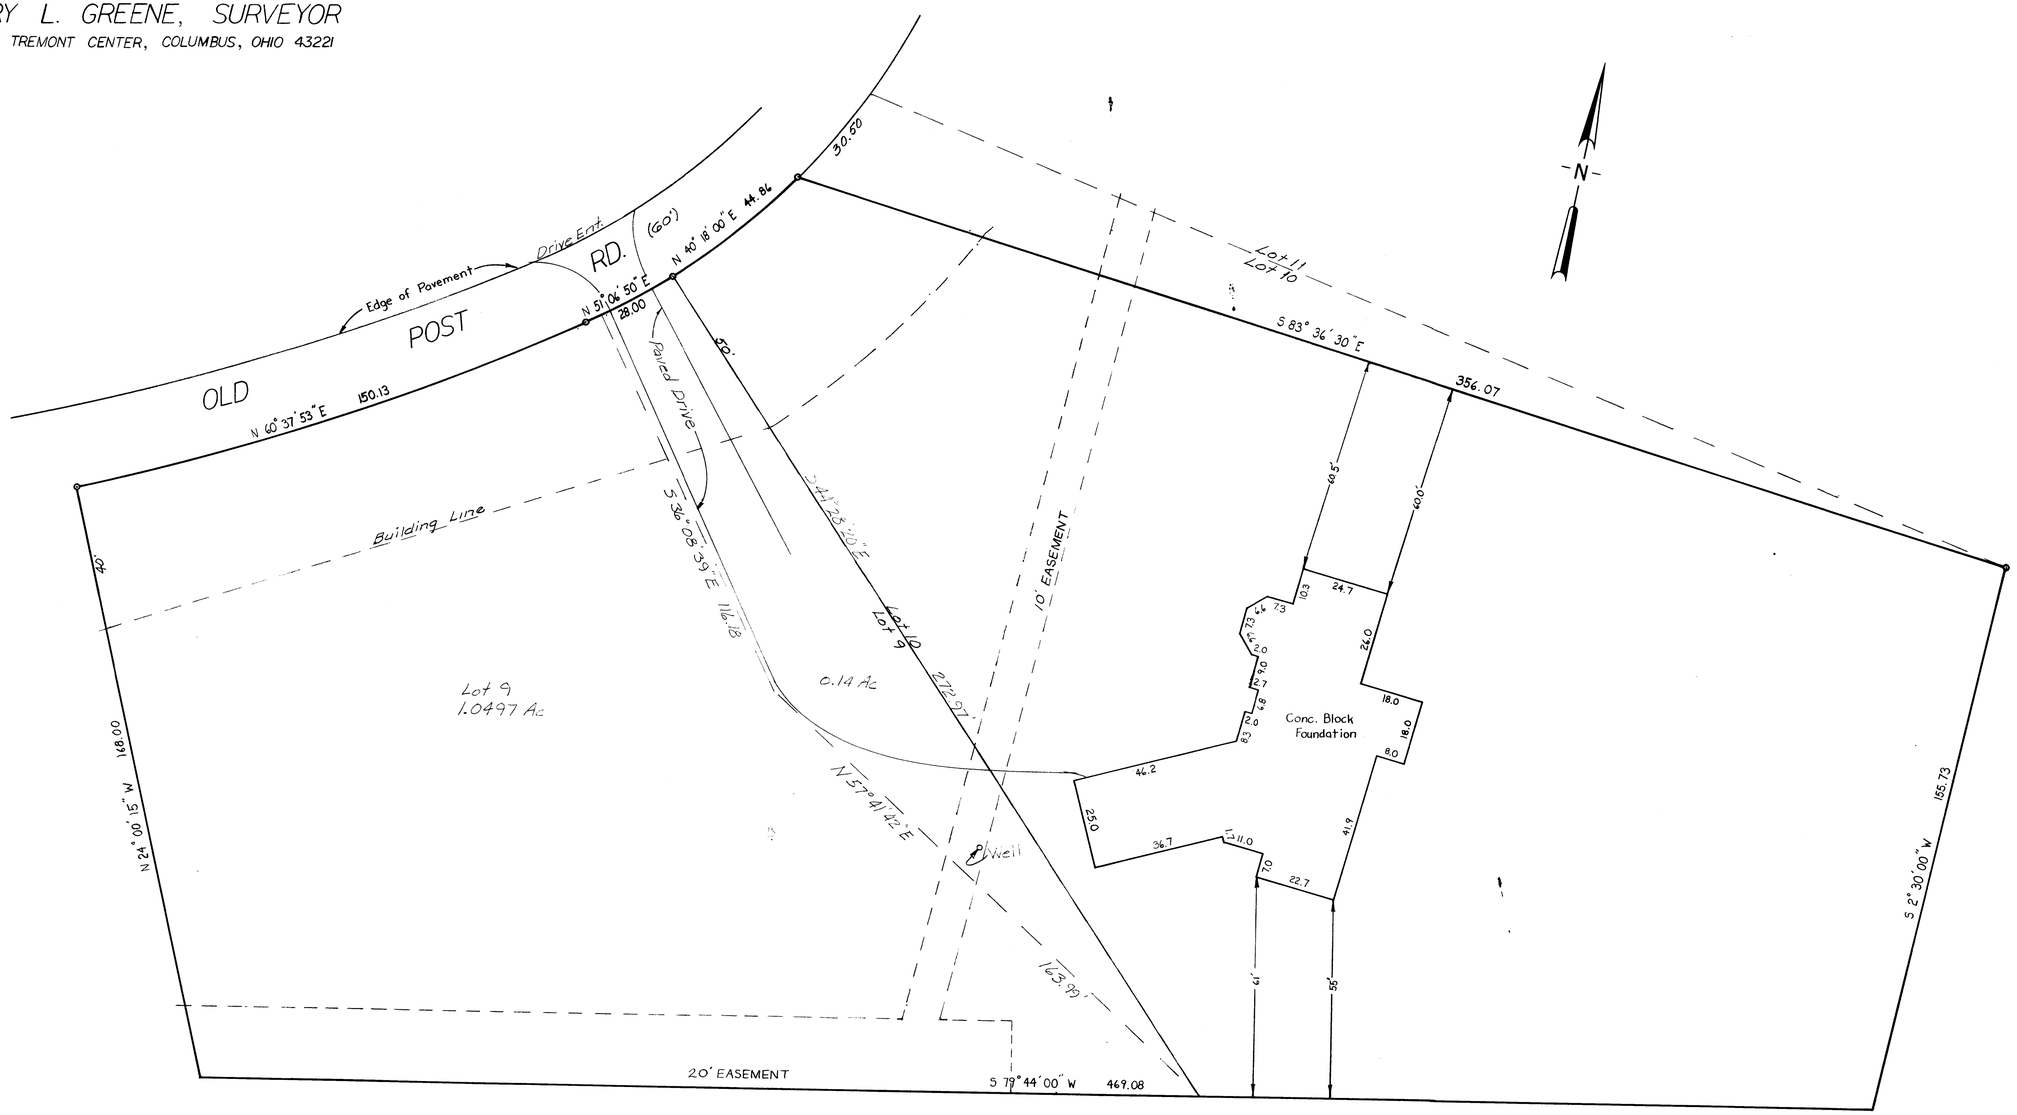

Lot 9 and Part Lot 10, CHANTICLEER
P.B. 28, Page 58, Recorder's Office, Franklin County, Ohio.

To: Huntington Mortgage Company.

I hereby certify the above plat has been prepared from actual survey of the premises for use in mortgage loan and title purposes only. No sideline of principle building is less than dimension shown. Property corners not located unless shown thus -O-.

Scale 1"=20' August 11, 1986

Harry L. Greene

Harry L. Greene, Registered Surveyor, No. 4058

91 M