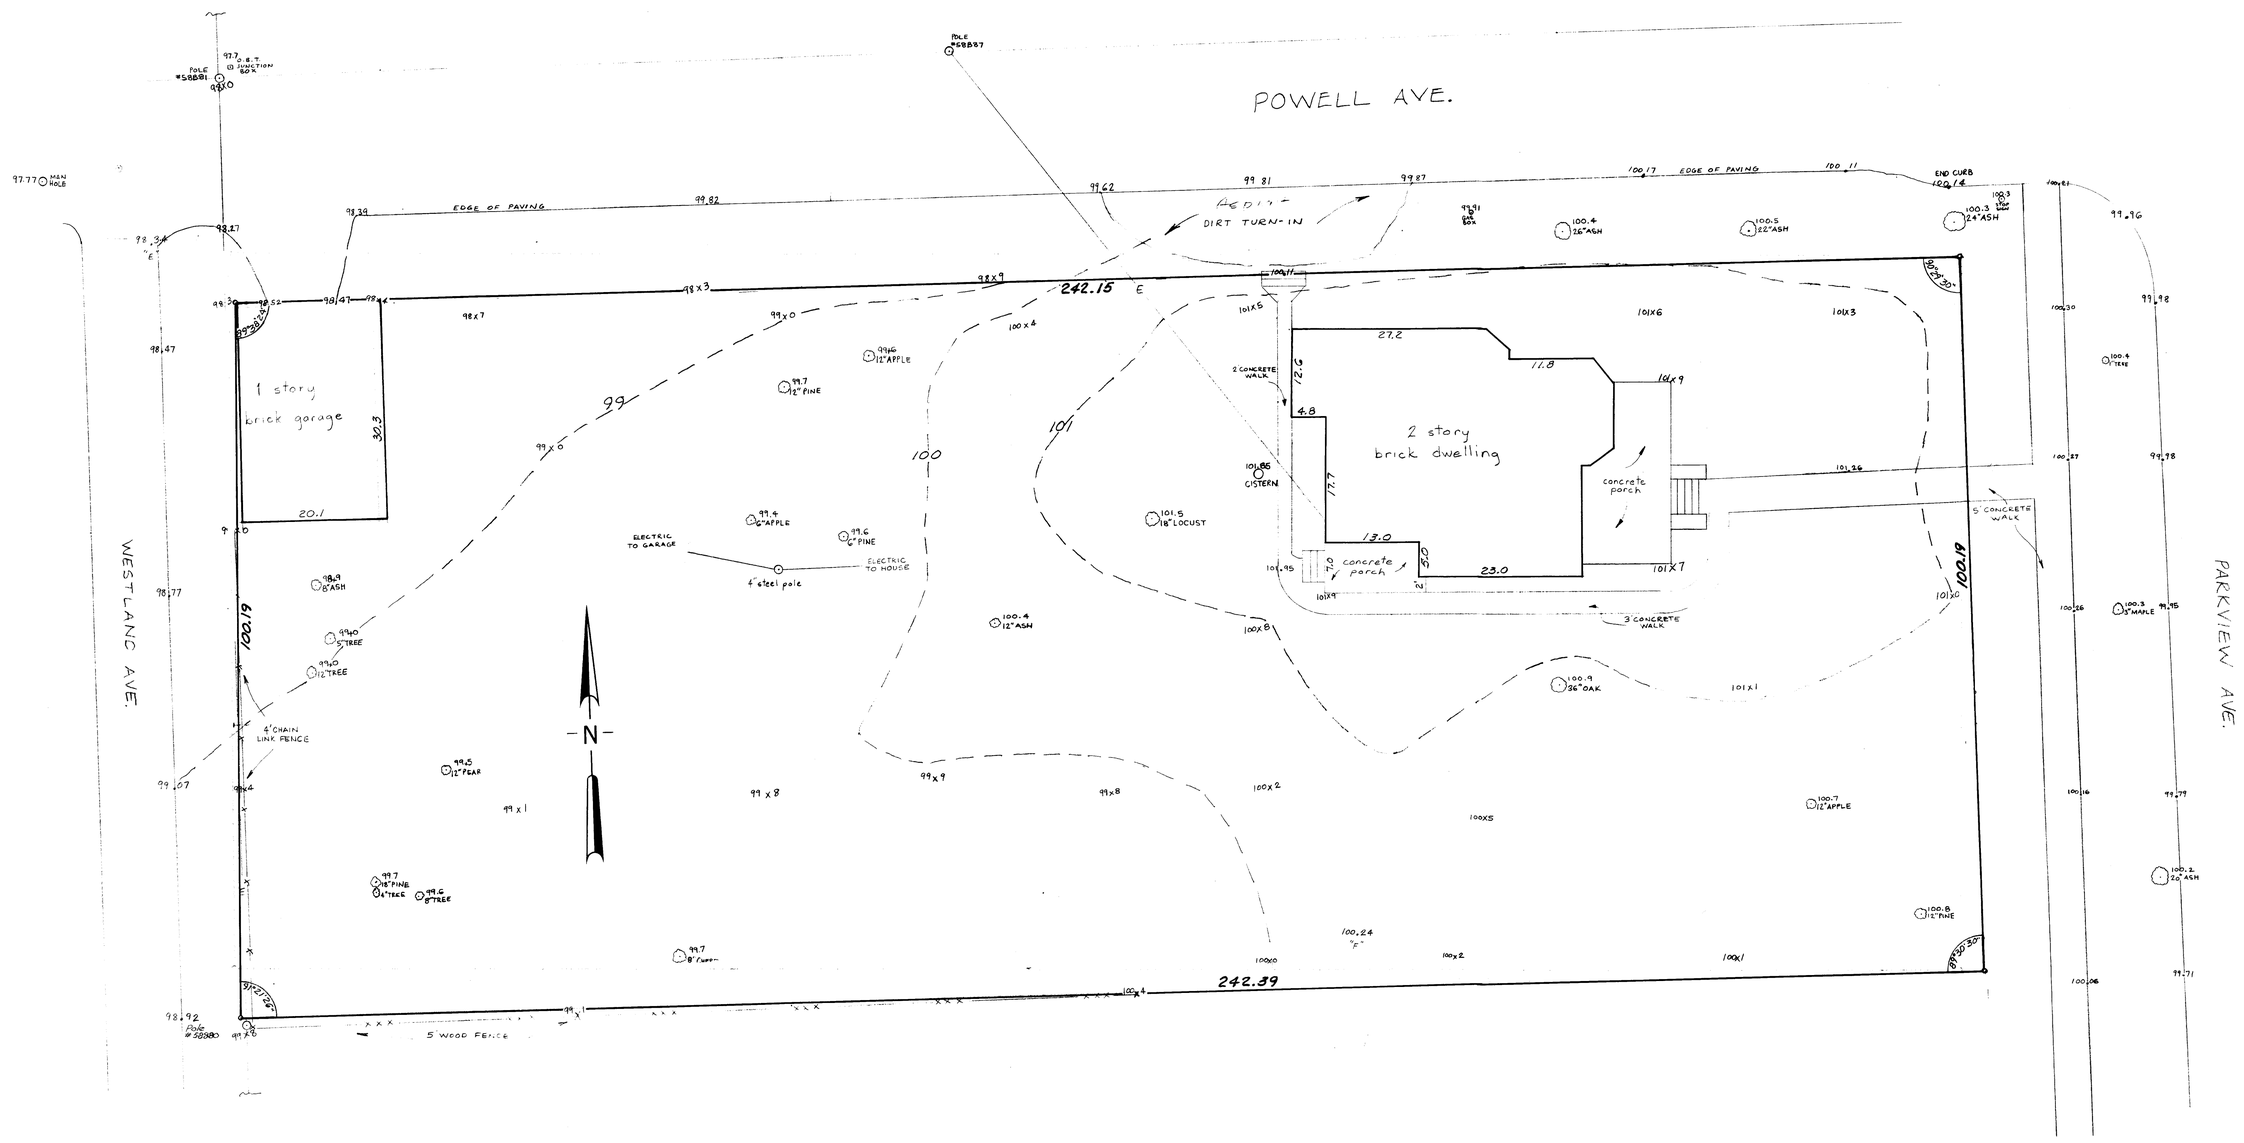

PLAT SHOWING SURVEY OF LOT 1, BLOCK 25,
BULLIT PARK, P.B. 5, p. 382
CITY OF BEXLEY, FRANKLIN CO., OHIO

APRIL 8, 1986 SCALE 1" = 10'

Harry L. Greene
HARRY L. GREENE REG SURVEYOR 4058

STATE OF OHIO
HARRY L GREENE 4058
REGISTERED SURVEYOR

92A1