


CHILLICOTHE

STREET (40')

B.M. Spike S. Side  
Folio Elev. 100.48

586°56'E 422.78

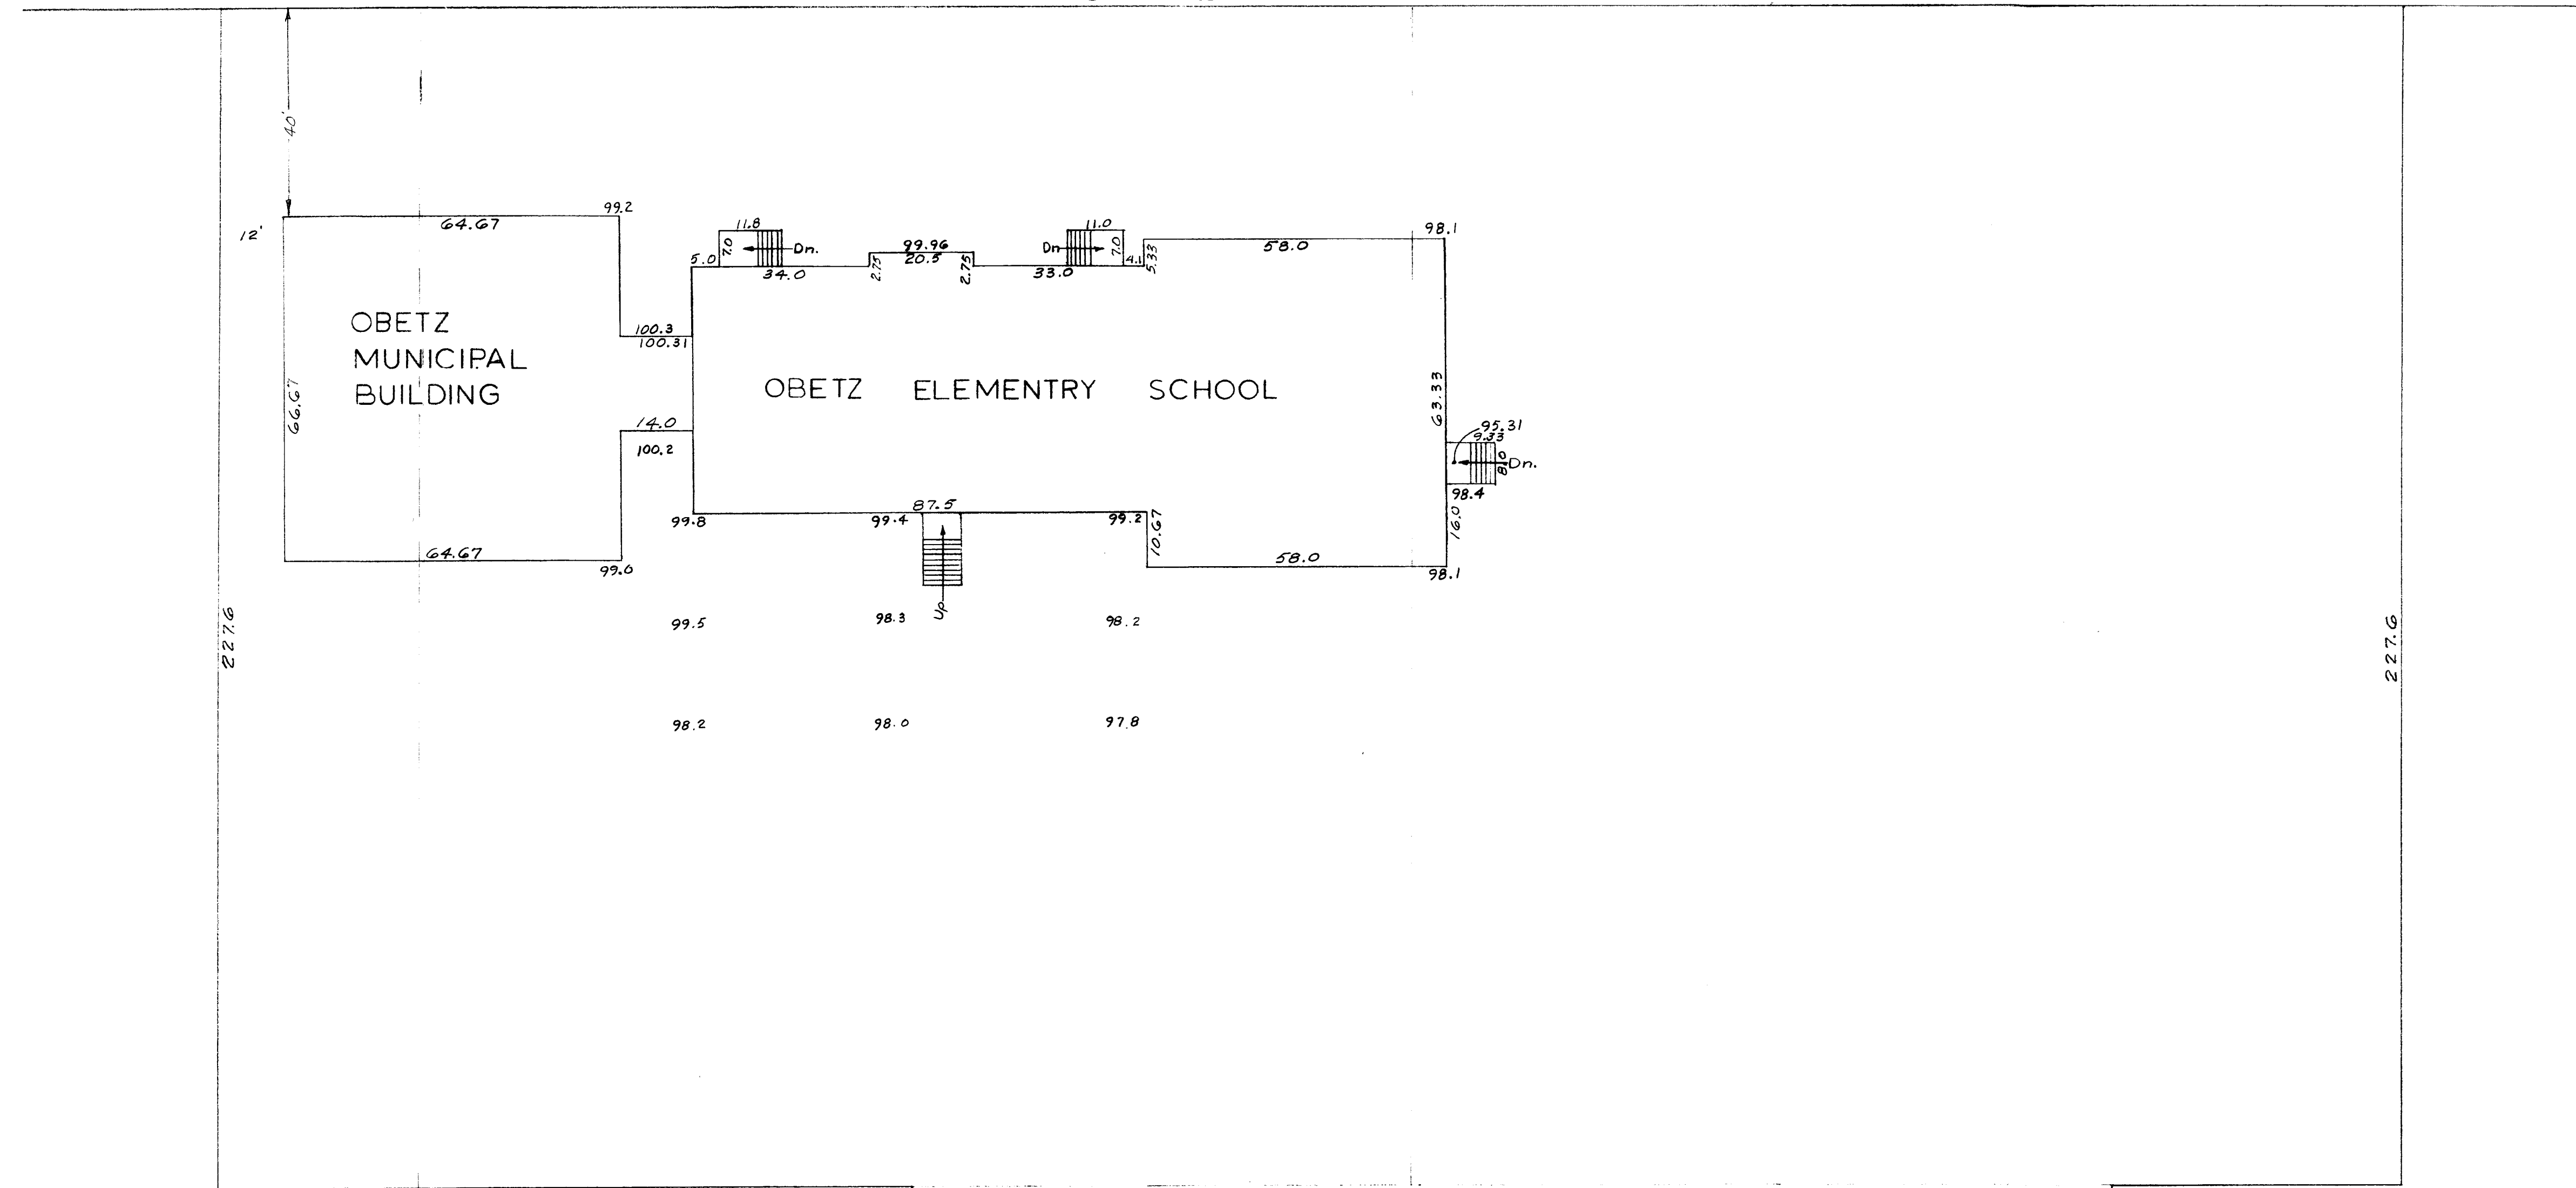

12'  
66.67  
227.6

OBETZ  
MUNICIPAL  
BUILDING


OBETZ ELEMENTRY SCHOOL

227.6

100'

100'

OBETZ AVE. (50')

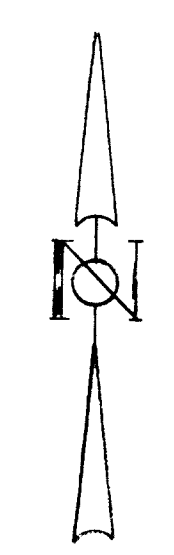

PLAT SHOWING BUILDING LOCATION AND  
ELEVATION FOR VILLAGE OF OBETZ,  
FRANKLIN COUNTY, OHIO.

Scale 1"=20'  
*Harry L. Greene* Aug. 9, 1978  
Harry L. Greene, Reg. Surveyor No. 4058