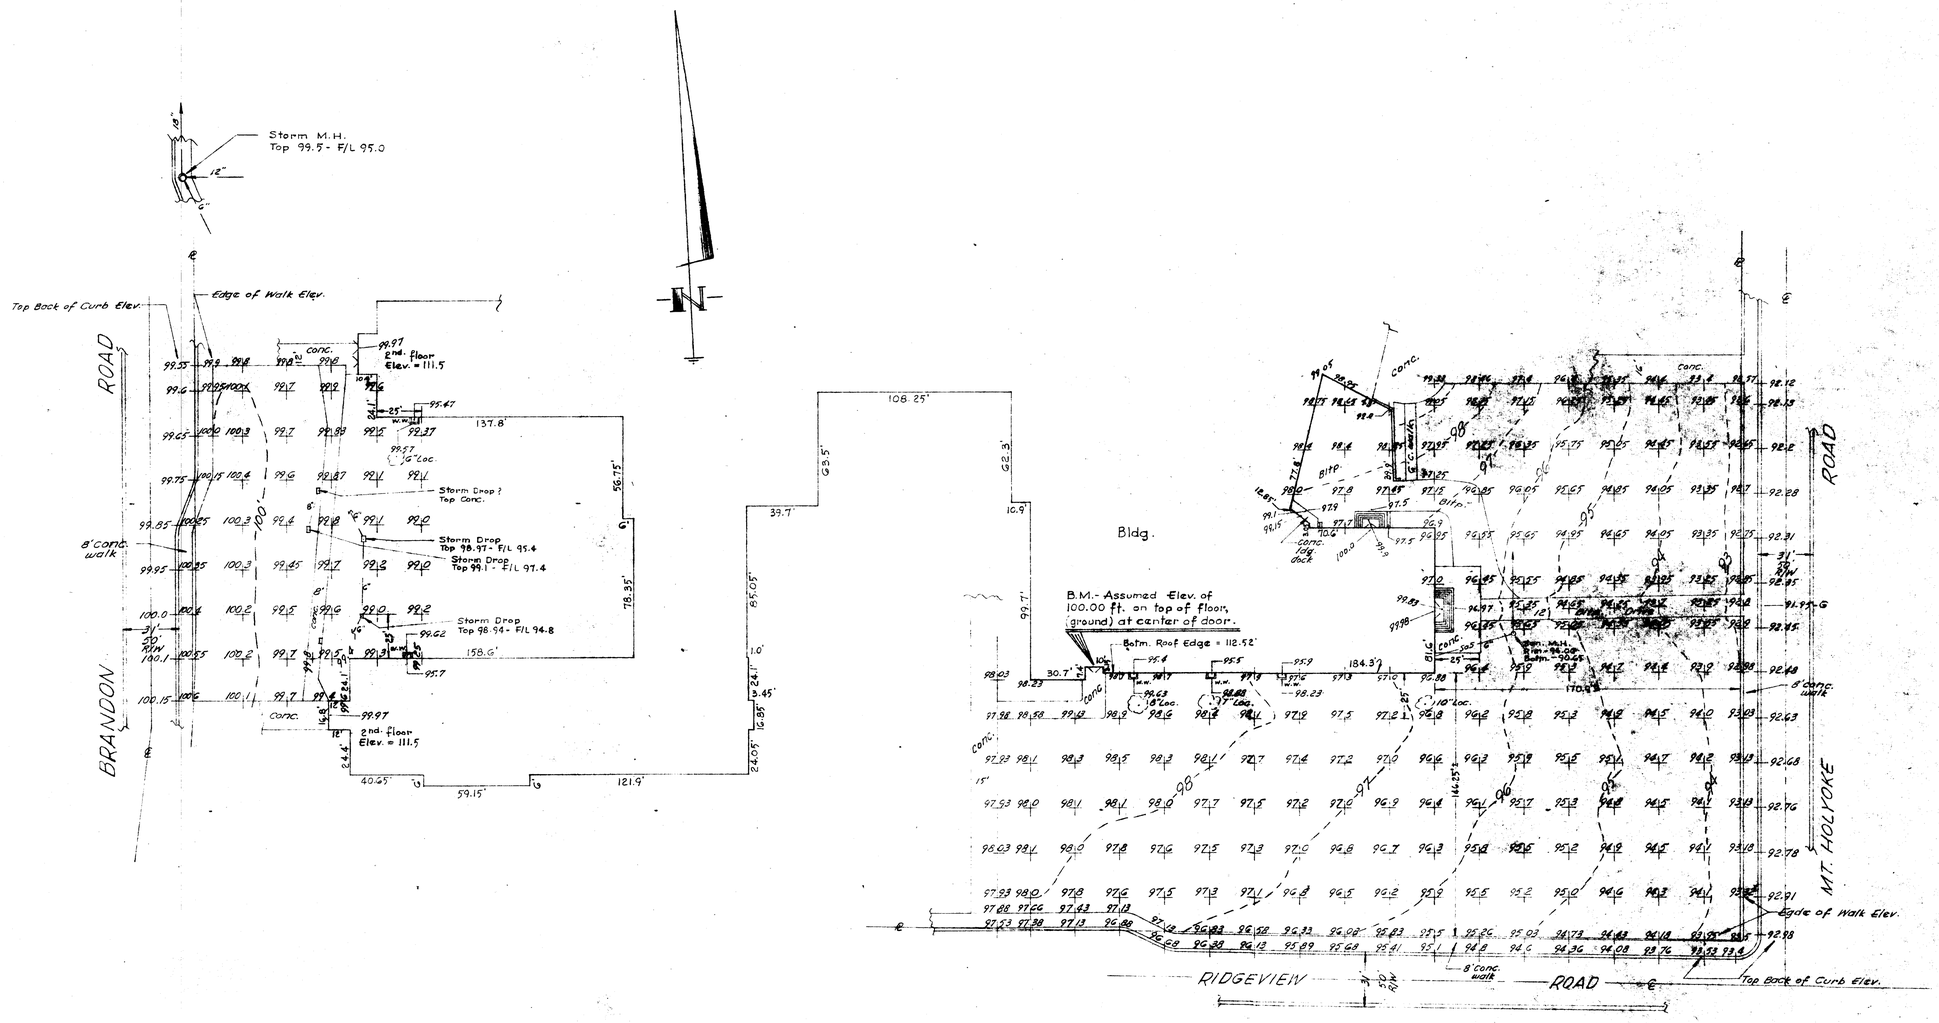

Partial Topo of the Upper Arlington High School Property,

for

the Board of Education Upper Arlington City School District, Upper Arlington, Ohio.

Scale 1" = 40'

Oct. 31 - 1969.

Harry L. Greene

Harry L. Greene - Reg. Surveyor

95A