


Sketch showing Encroachment  
on Lot 183, Plat 5 Northwest  
Boulevard in Grandview Hgts.

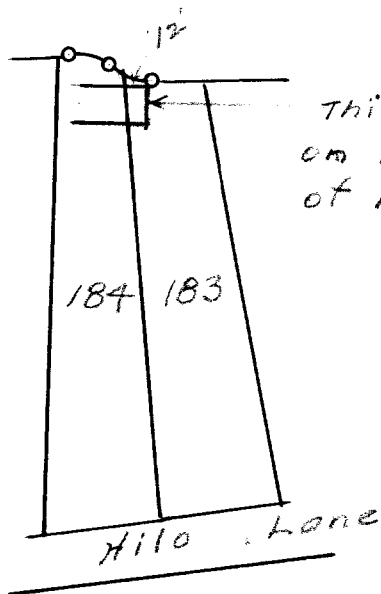

This Garage encroaches  
on Lot 183 a distance  
of 12 feet.

I hereby certify that I have surveyed  
Lot No 183 - Plat 5 - Northwest Boulevard, and that  
the Encroachment of the Garage is as shown  
above.

EB Dayre Civil Engineer

Scale 1" = 100'  
Date 1-10-46

