


CITY OF UPPER ARLINGTON BOARD OF EDUCATION TRACT

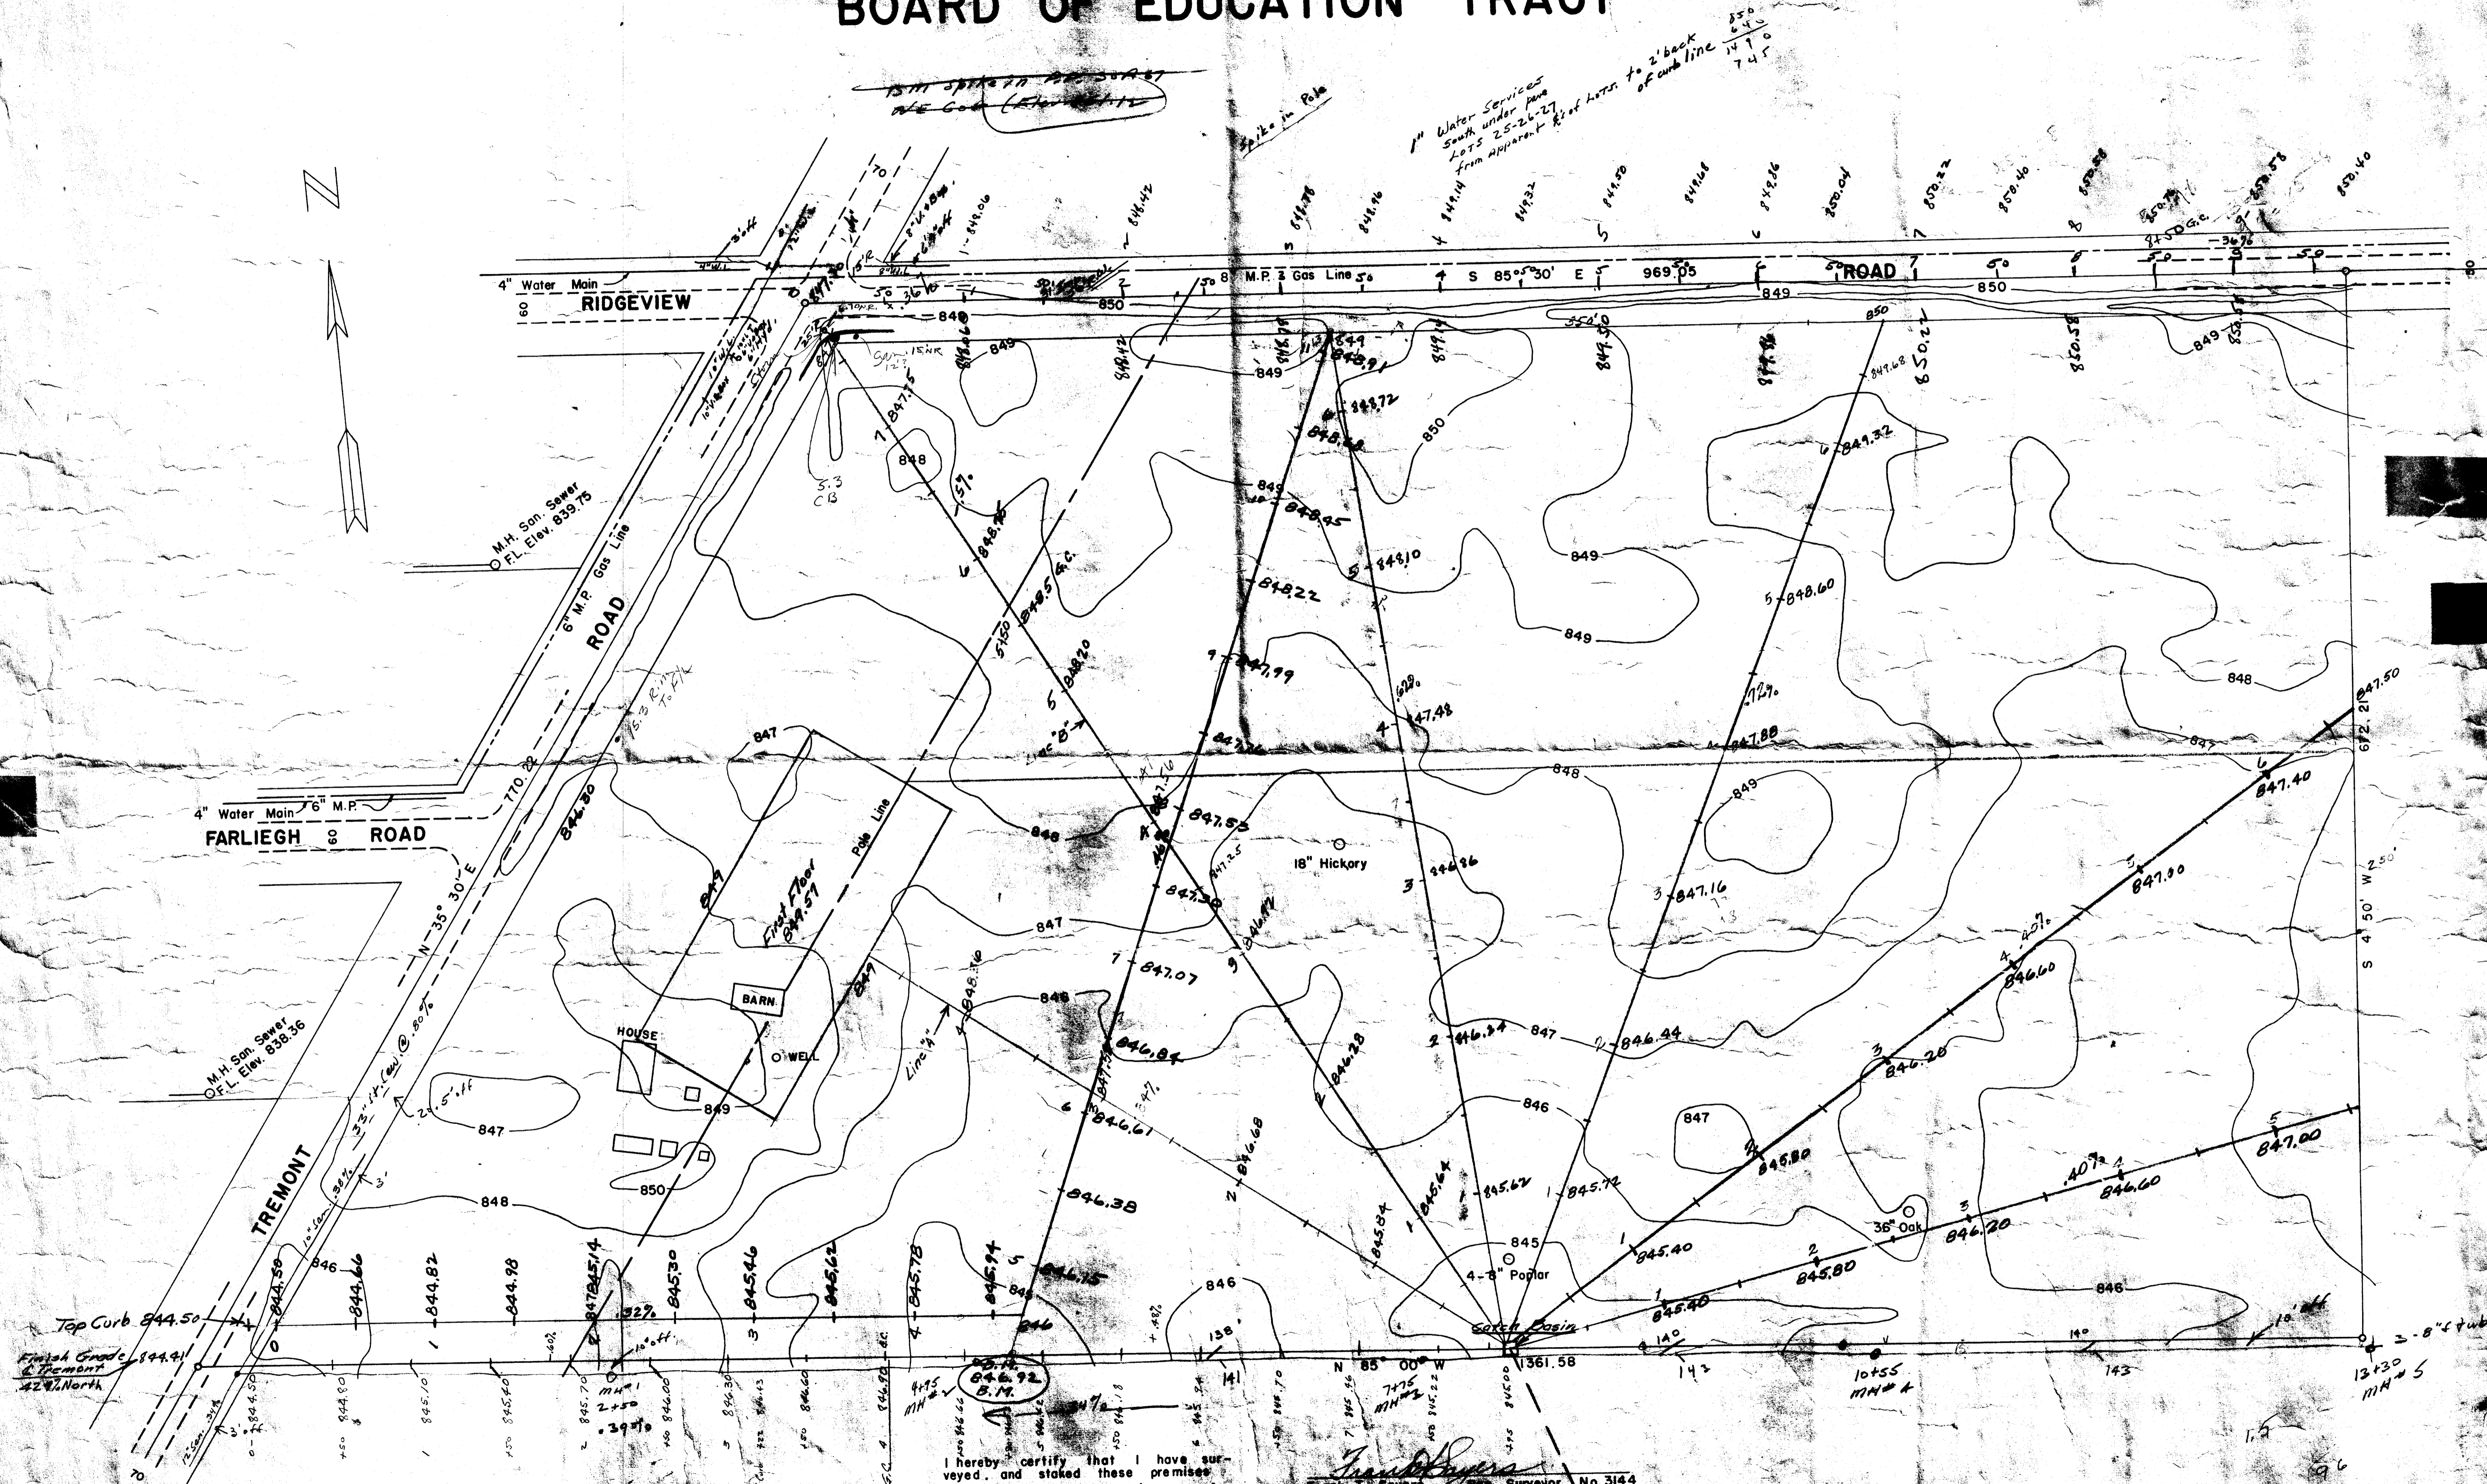

I hereby certify that I have surveyed, and staked these premises, and that said survey is correct.

Frank T. Sayers
 Frank T. Sayers Reg. Surveyor No. 3144

1st Water Services
 South under pines
 Lots 25-26-27
 from apparent R. of lot 1 to
 2' back
 of curb line
 250
 147
 745

15th spike in pole
 N.E. Cor. (Elev. 847.12)

1055
 1343
 1145 S