

100.36
F.L. E. End 24" Storm Sew.

CHARING


ROAD

99.9
W. Edge Pavement

100.10
W. Edge Pavement 20' Wide

Assumed Elev. 100'
West Rim M.H. - 8" San. Sewer
F.L. 92.55

24" ST. SEW.

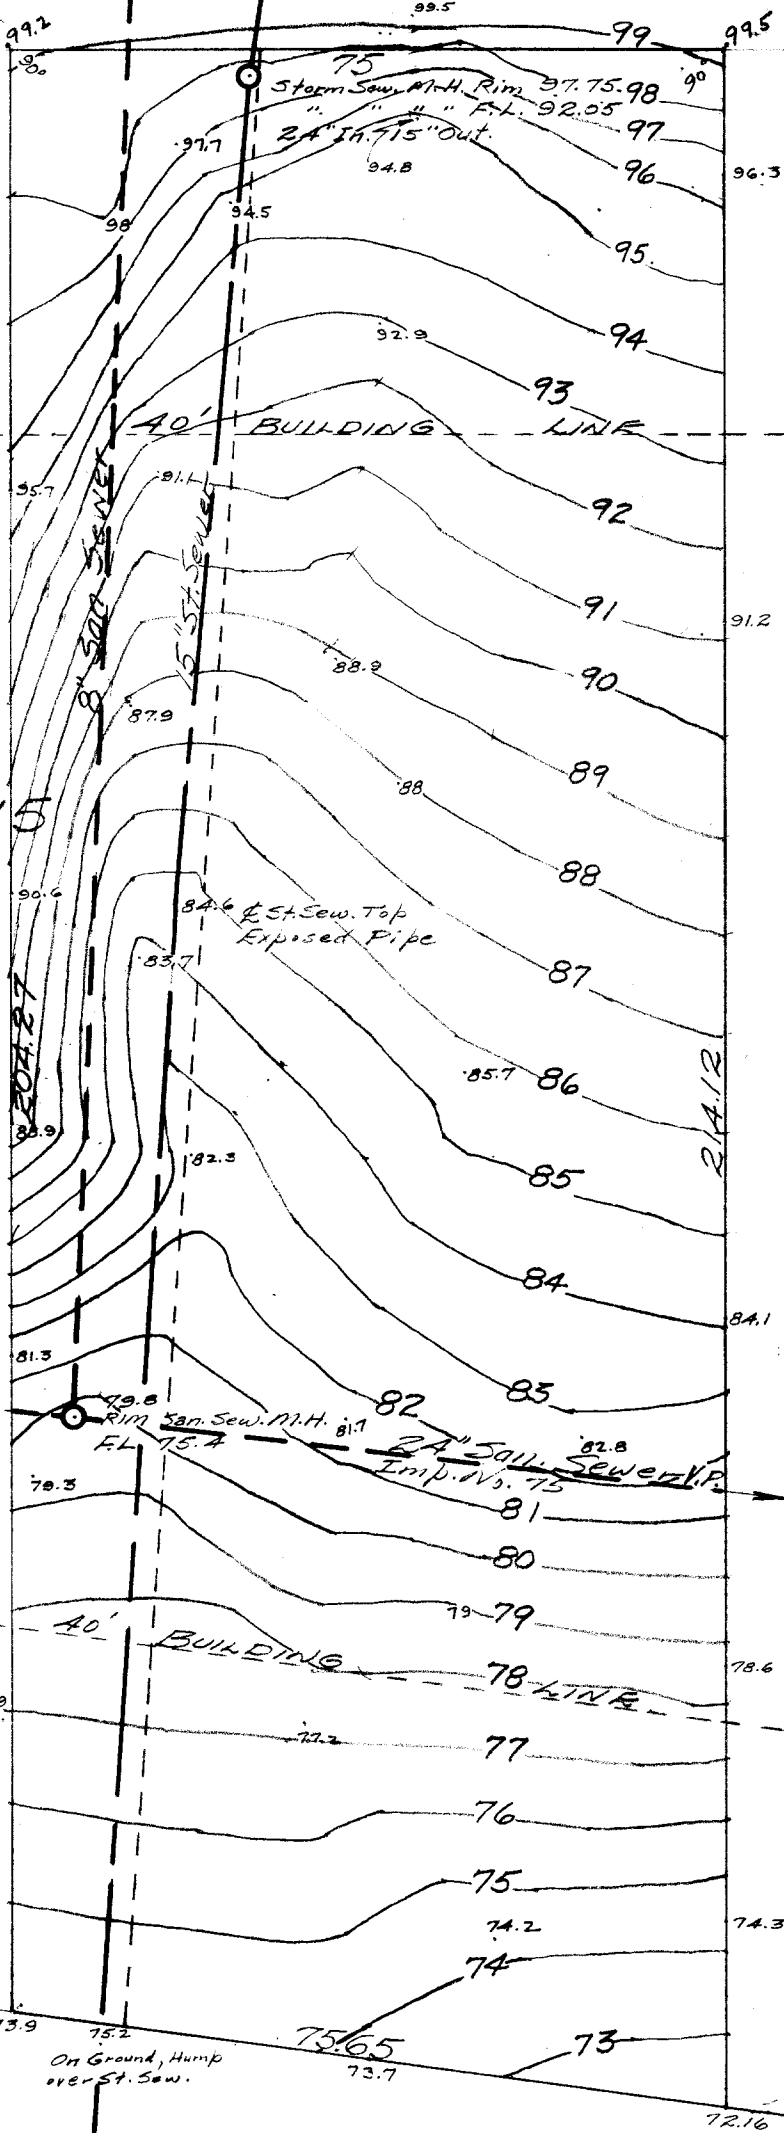

Top of floor Elev. of
Existing Apt. 97.55
Setback 45'

COR. APT.
Floor Elev. New Apt.
95.70
Setback 43'

82.6 E. St. Sew. Top
Exposed Pipe
83.71
82.8
24" San. Sewer Pipe
Imp. No. 75

Southeasterly one half (1/2)
Lot No. 15, Block No. 268,
Canterbury Place Addition
Extension No. 7, City of
Upper Arlington, Ohio.
Scale 1" = 20'

On Ground, Hump
over St. Sew.

66.8
Ditch

67.0
Ditch

76.3
Ditch

77.4
PAVEMENT

RIVERSIDE

E. Side Riverside Dr.
Pavement

DRIVE