


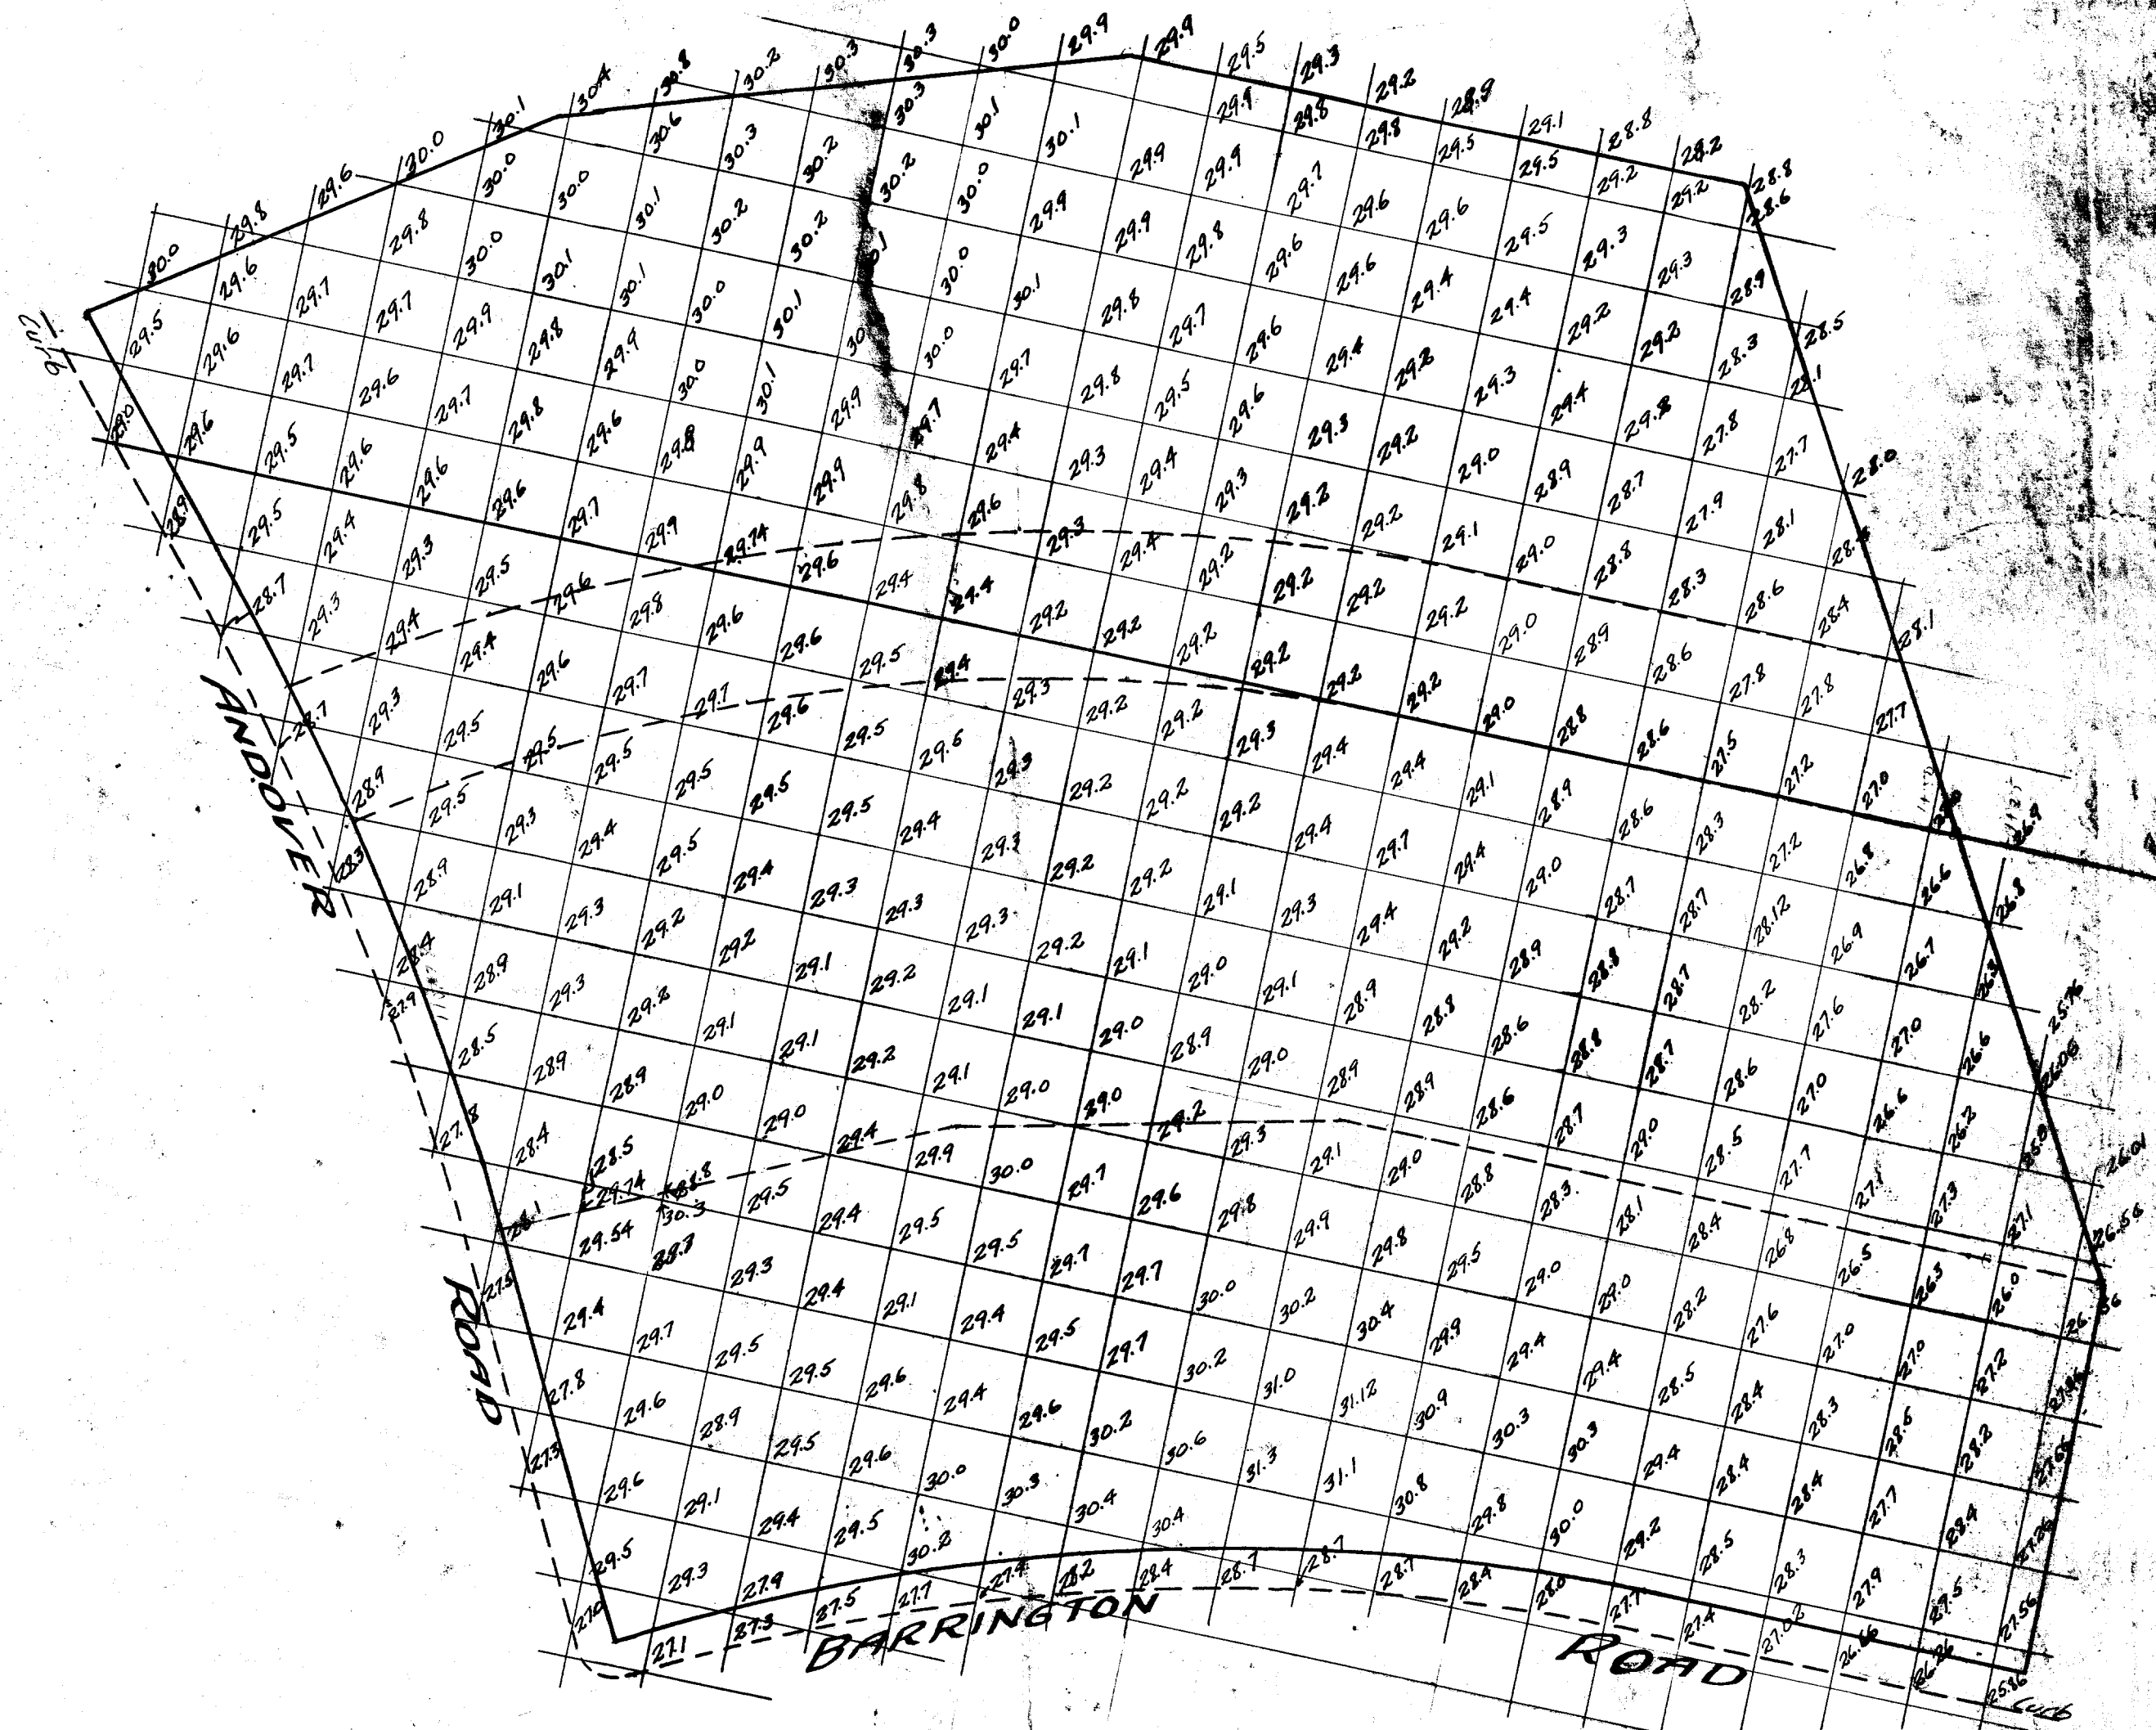

Sketch showing elevations in
Blks. 148 & 149 - Upper Arlington
Ohio
Date 8-9-38 Scale 50' = 1"

For Upper Arlington Datum
add 800 Ft.

BM C.B. N.E. Co. and Barrington 823.56
First floor Blk. 100 - 830.5
930.81 S. of N. post