


FOUNDATION LOCATION AND UTILITIES
 SURVEY OF LOTS NOS. 26, 27, 28, RESERVE "A" AND 16' VACATED ALLEY BETWEEN.
 FRANK C. MARTINS SUBDIVISION, CITY OF COLUMBUS, FRANKLIN COUNTY, OHIO.

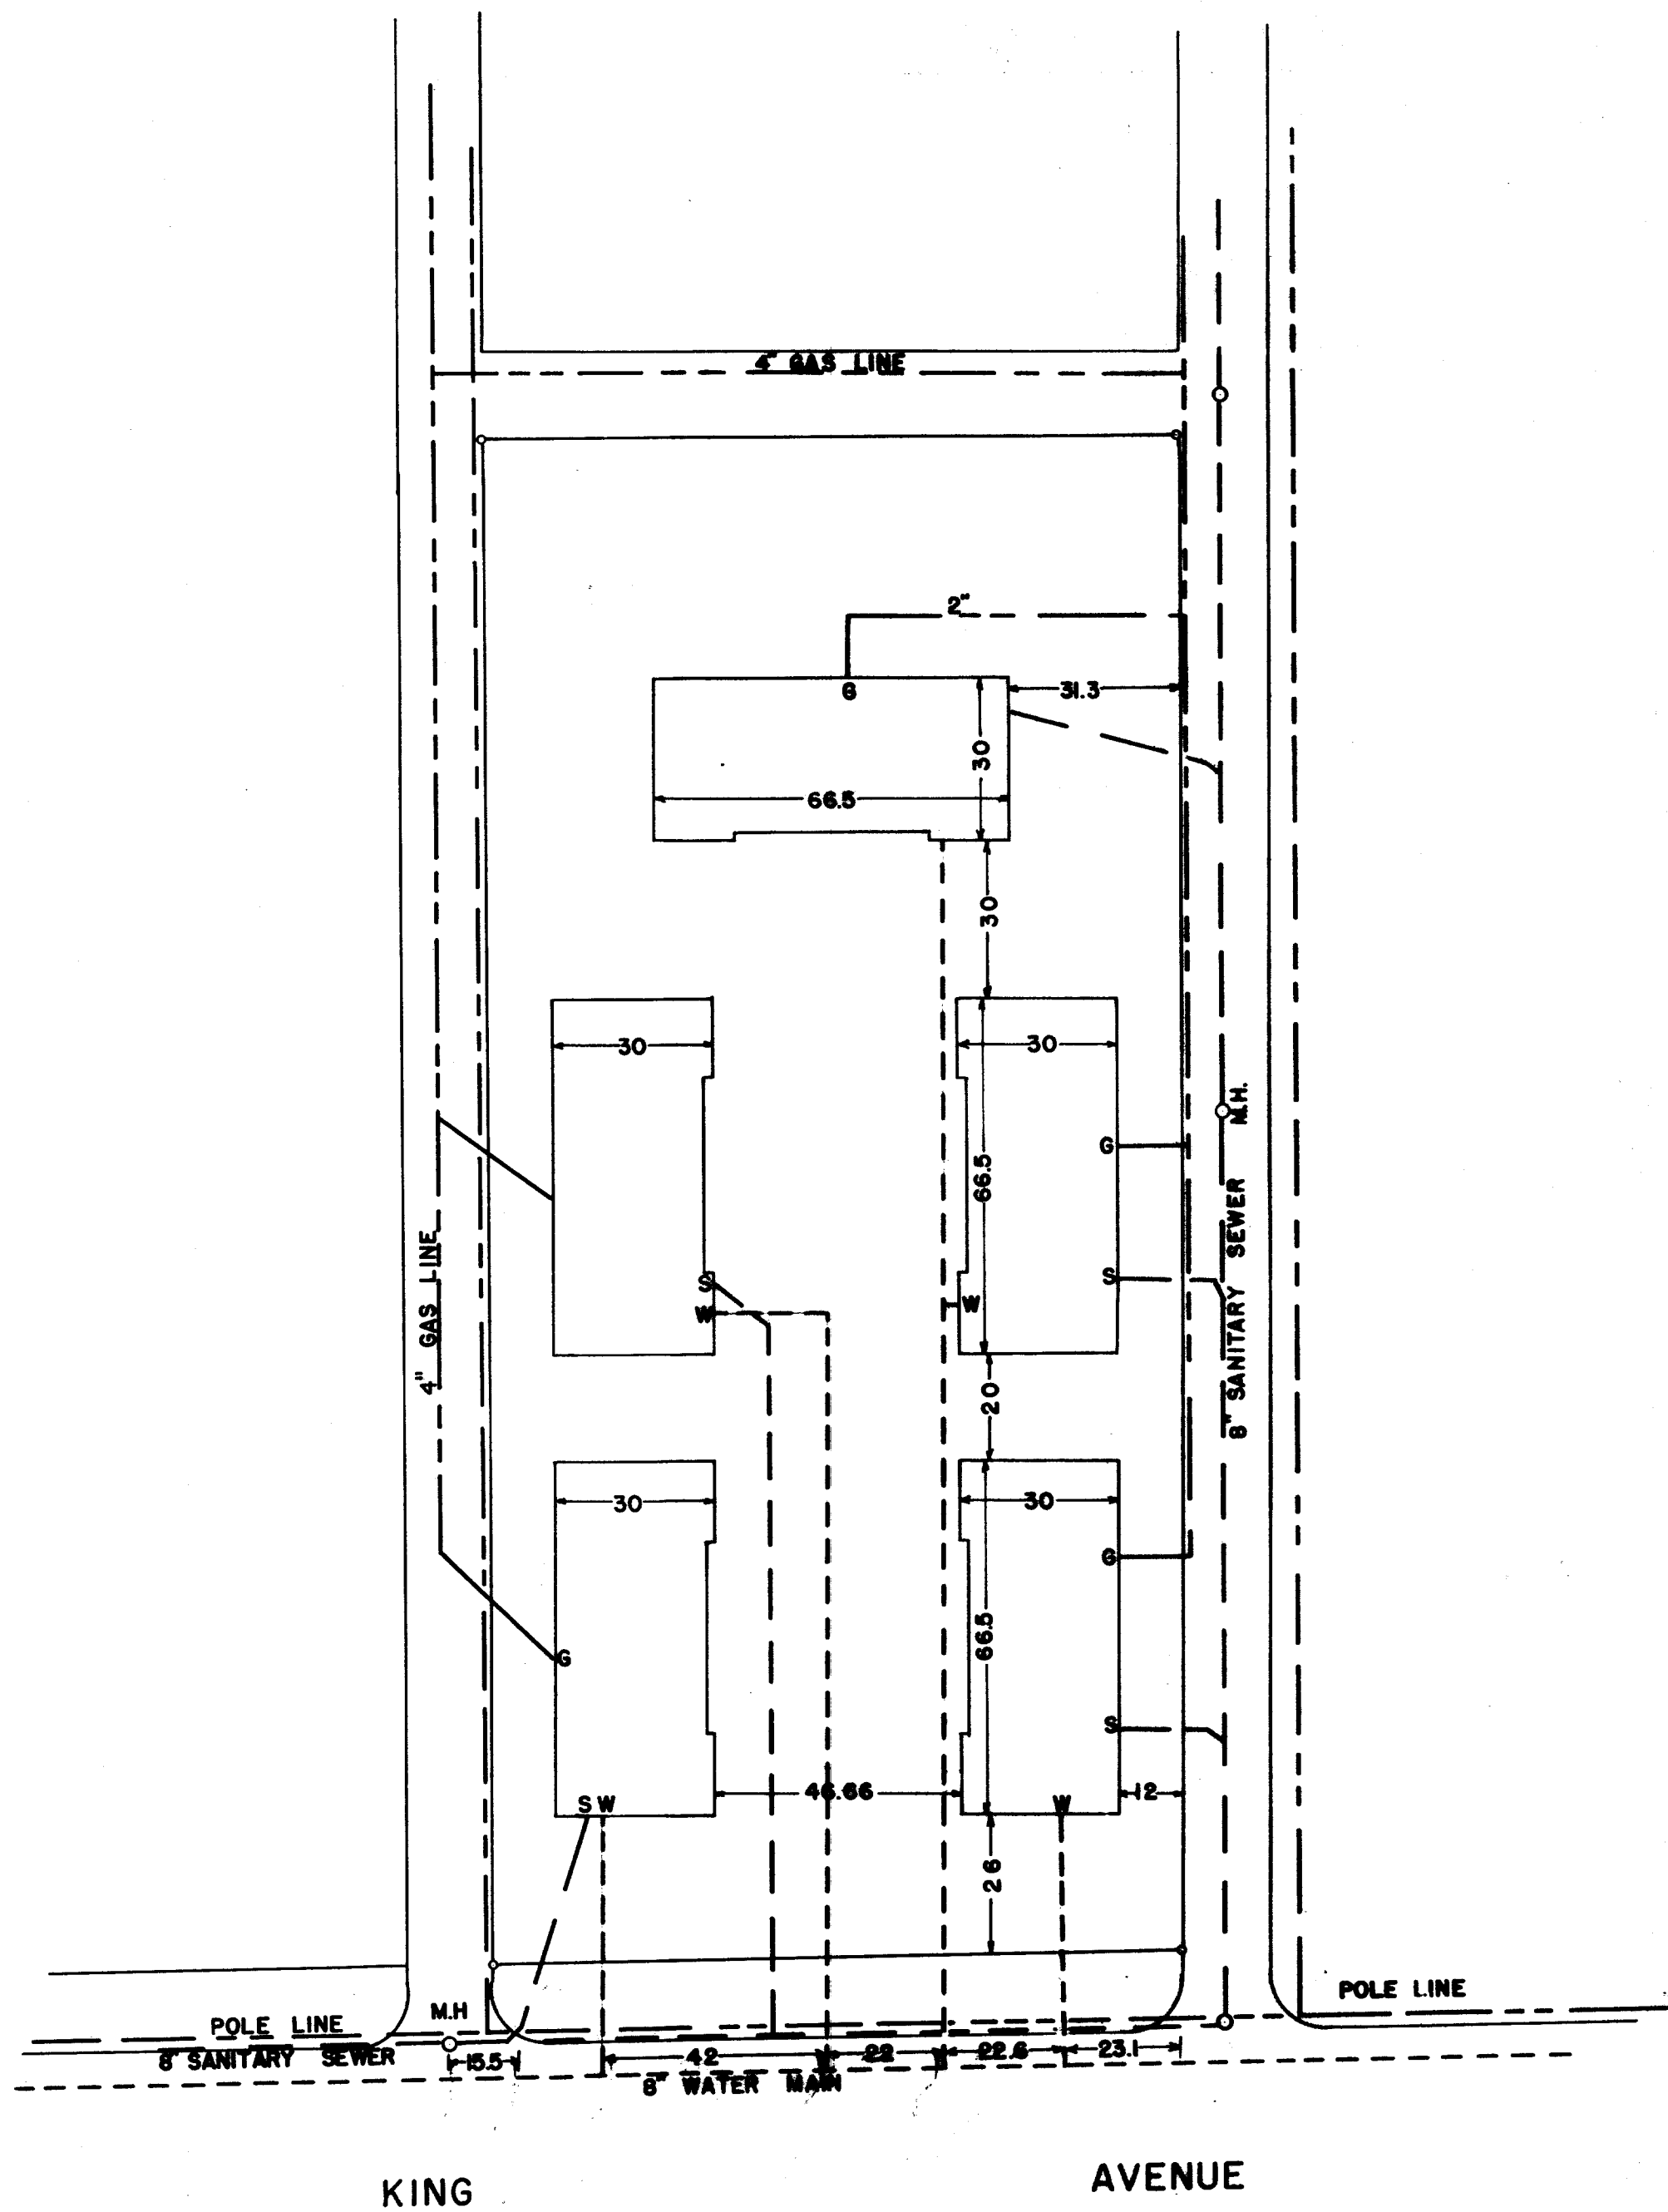

TO ALL PARTIES INTERESTED IN TITLE TO PREMISES SURVEYED.

This survey made for the benefit of
 Huntington National Bank, F.H.A., and
 Nor - Med Court Inc. Project No. 043 - 42100

Scale: 1" = 30'

Sept. 5, 1950

I hereby certify that I have made a survey of the premises shown on this plot plan on the 5th day of Sept, 1950, and that this plot plan is a correct representation of the premises as determined by this survey. I further certify that there are no encroachments either way across the boundary lines of said premises.

Frank T. Sayers

FRANK T. SAYERS Reg. Surveyor No. 3144

