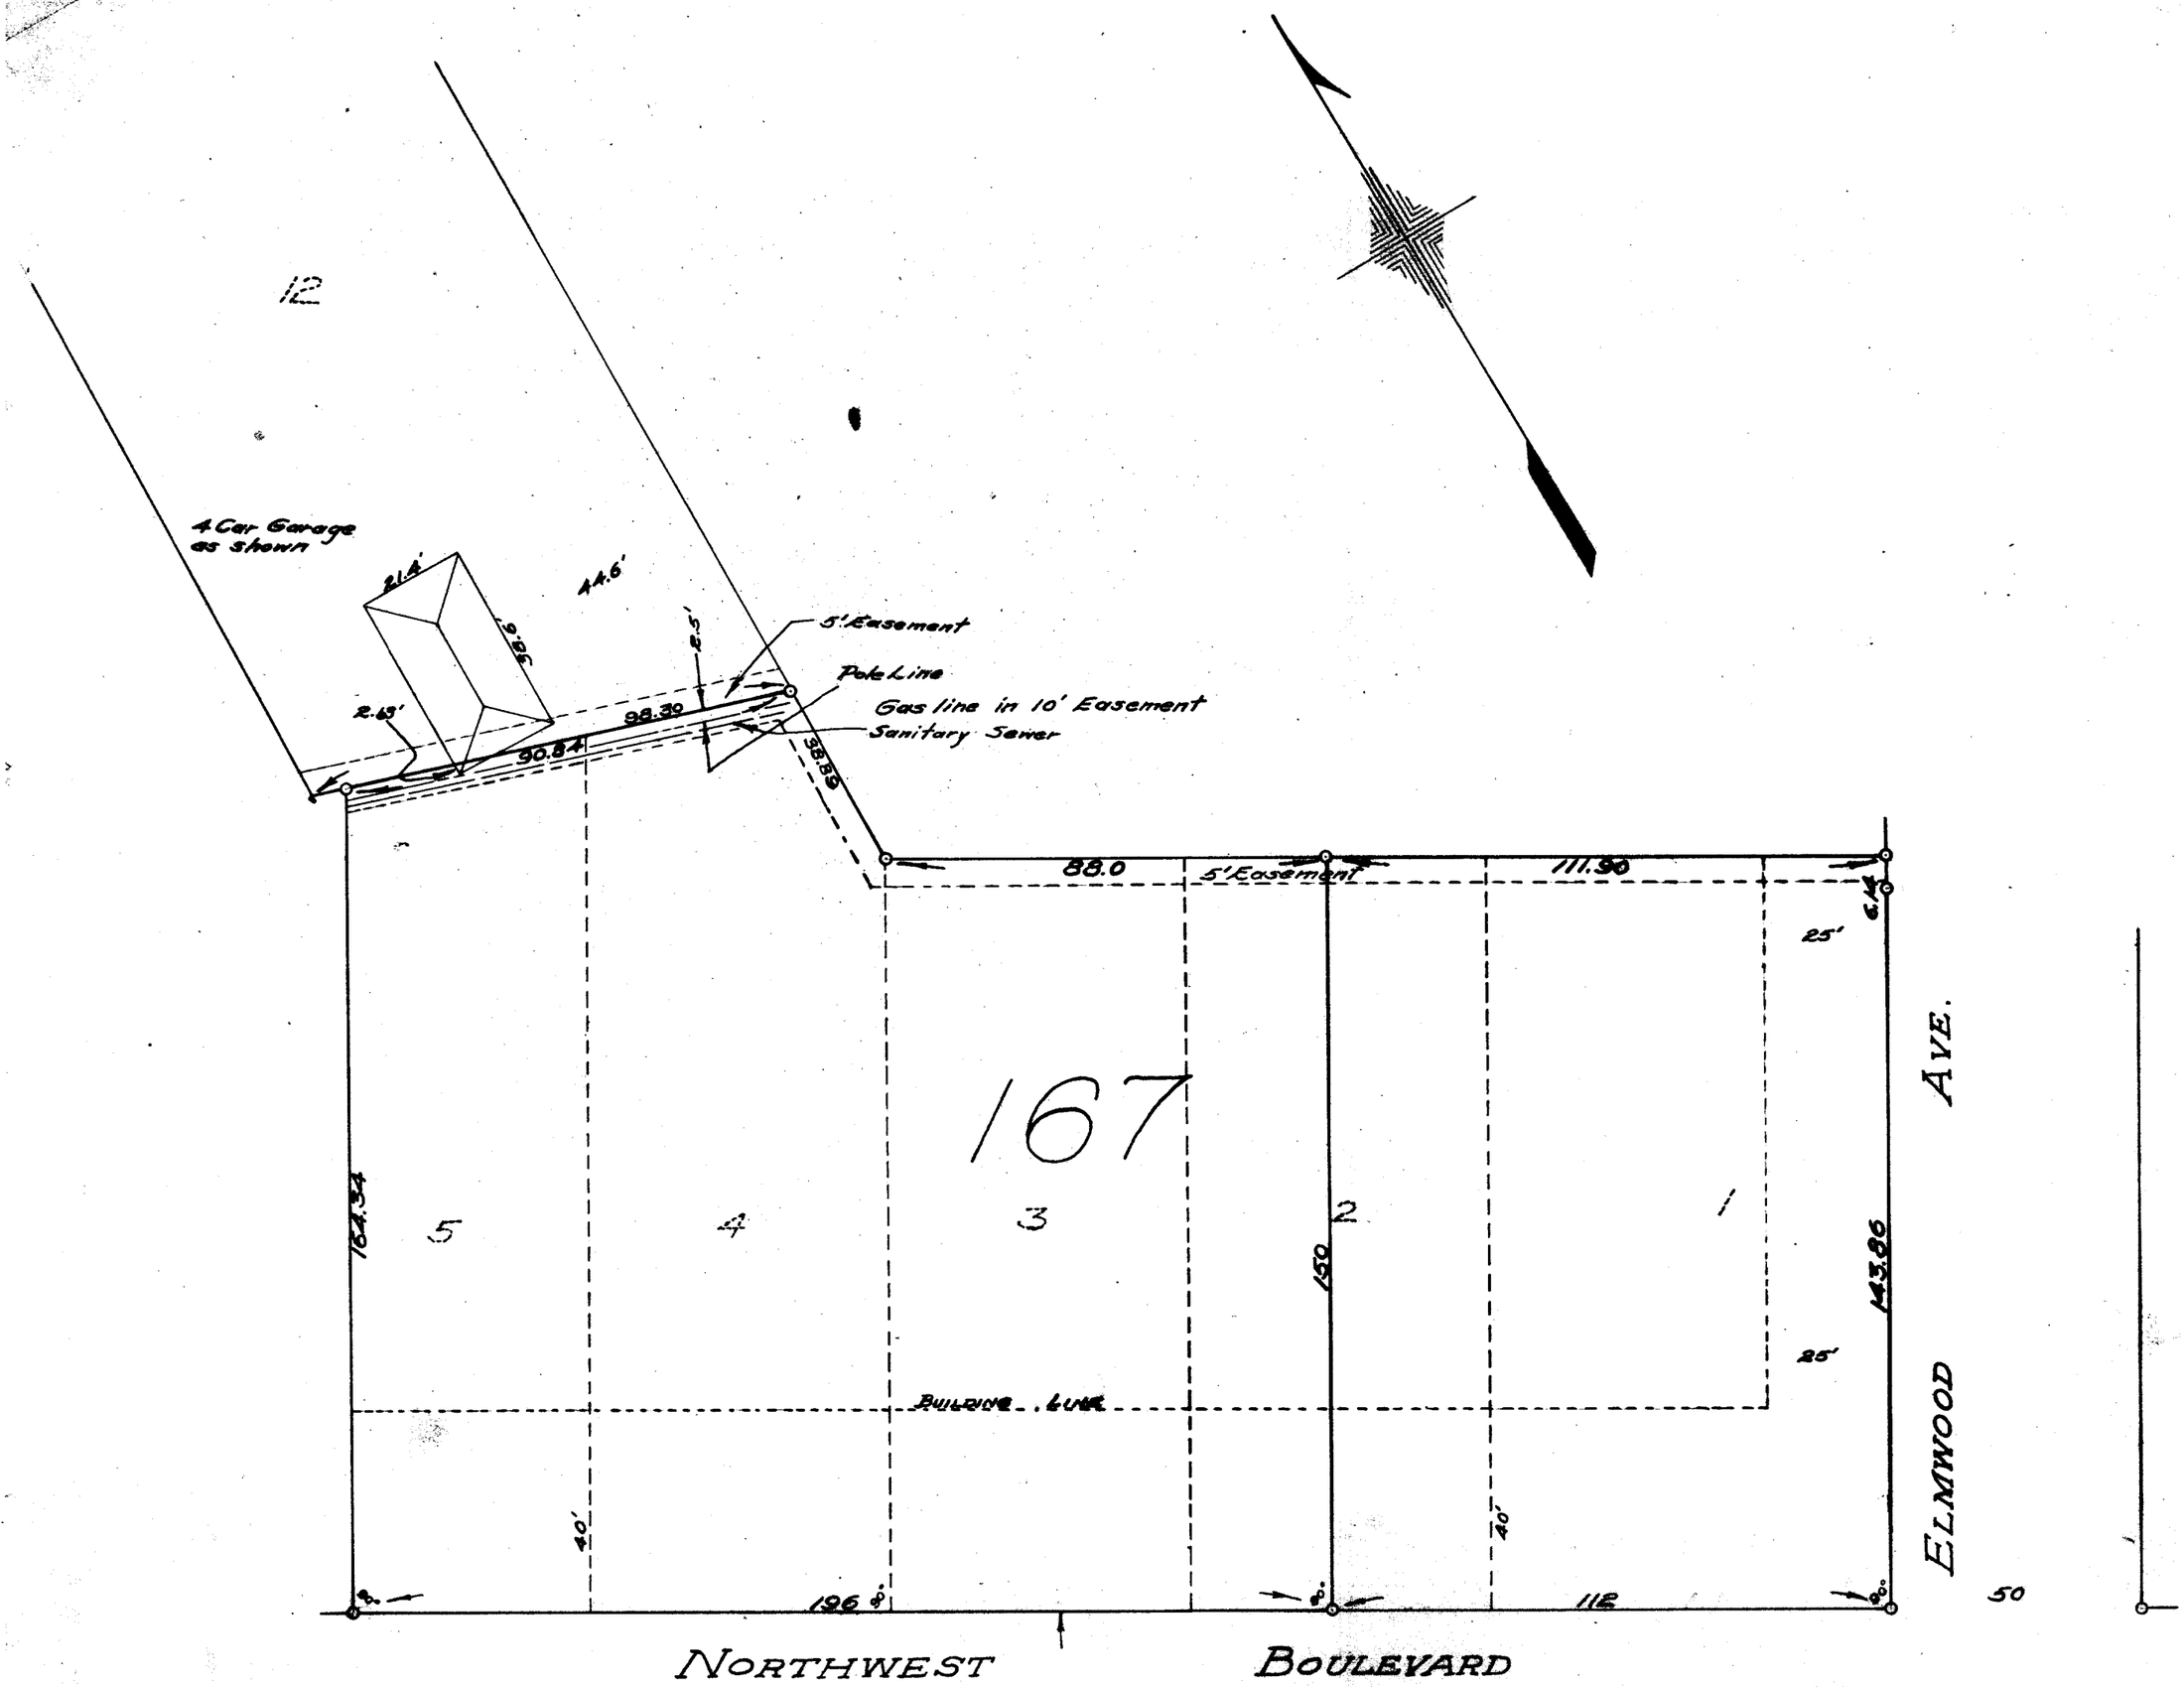

Fallon Properties Project 2
Northwest Blvd. & Elmwood Ave.
Upper Arlington

I certify that I have surveyed and staked lots nos. 1,2,3,4 and 48' off of East side lot no. 5 in Block 167 Upper Arlington and conditions are as shown
Scale 30'=1"
Feb. 9 - 1948

Frank Sayers
Surveyor