


Lot No. 1 & 20' off East side Lot No. 2,
Block 133, Upper Arlington
2312 Coventry Road

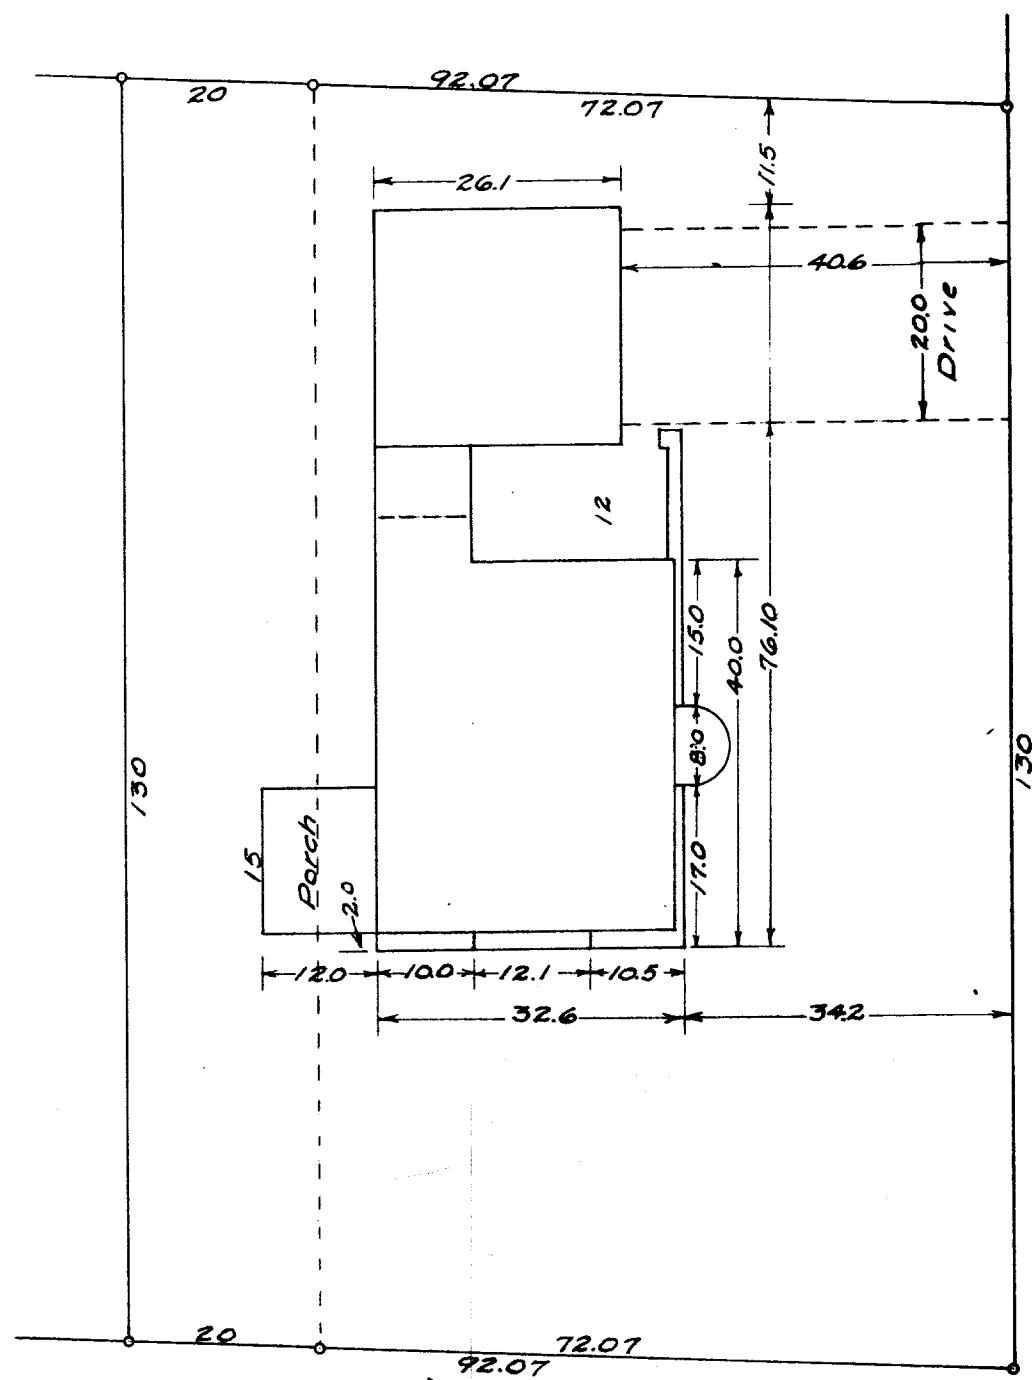

BEVERLY ROAD

COVENTRY ROAD

I certify this to be a correct
survey and there are no
encroachments.
Scale 20' = 1" April 20, 1949

Frank Hayers
Surveyor