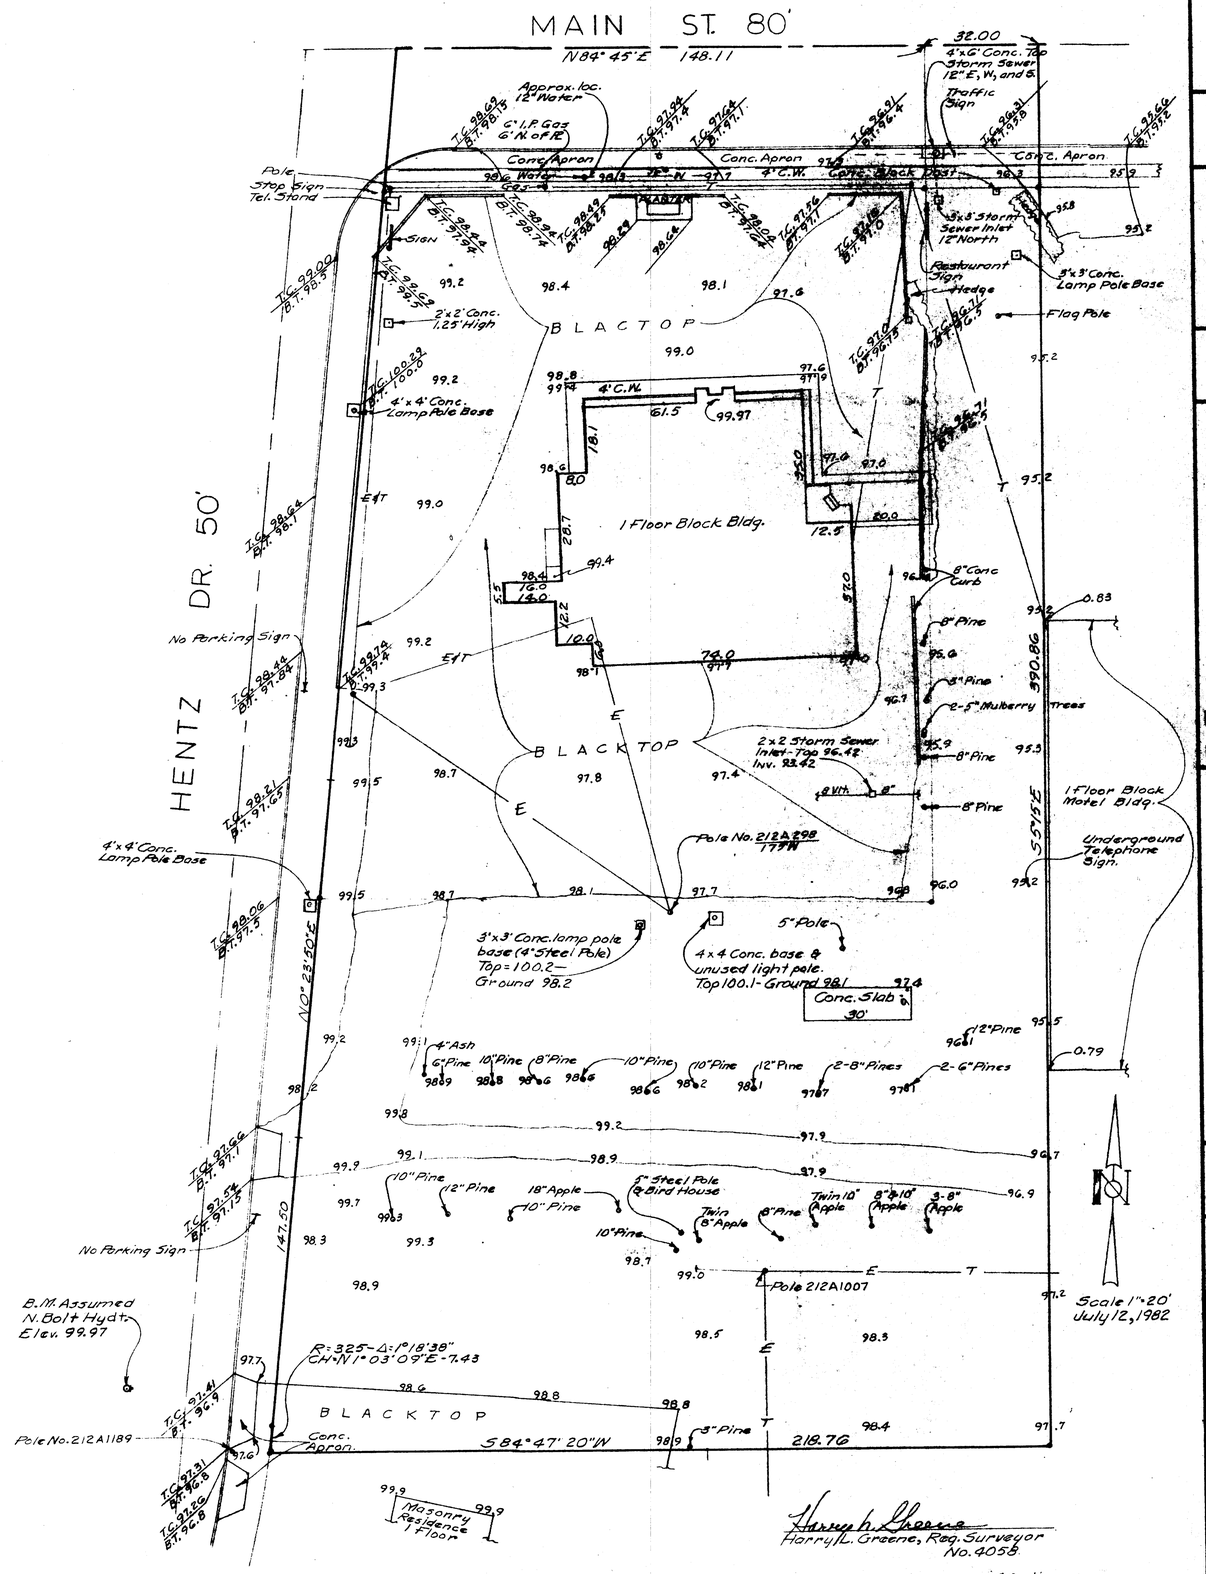

SHEET NO.

DATE

REVISIONS

COMMISSION NO.

Lajos Szabo, A.I.A. architect
905 Salin Road
Columbus Ohio, 43204

PRELIMINARY
CONSTRUCTION
FINAL RECORD

STATE OF OHIO
LARRY STEVEN SZABO
REGISTERED ARCHITECT

APPROVED

SHEET NO.